


PLAT OF SURVEY OF
PART OF LOT 9 AND LOT 10 OF LA SELVA SUBDIVISION LOCATED IN SECTION 26, T 4 N, R 16 E
WALWORTH CO., WISCONSIN

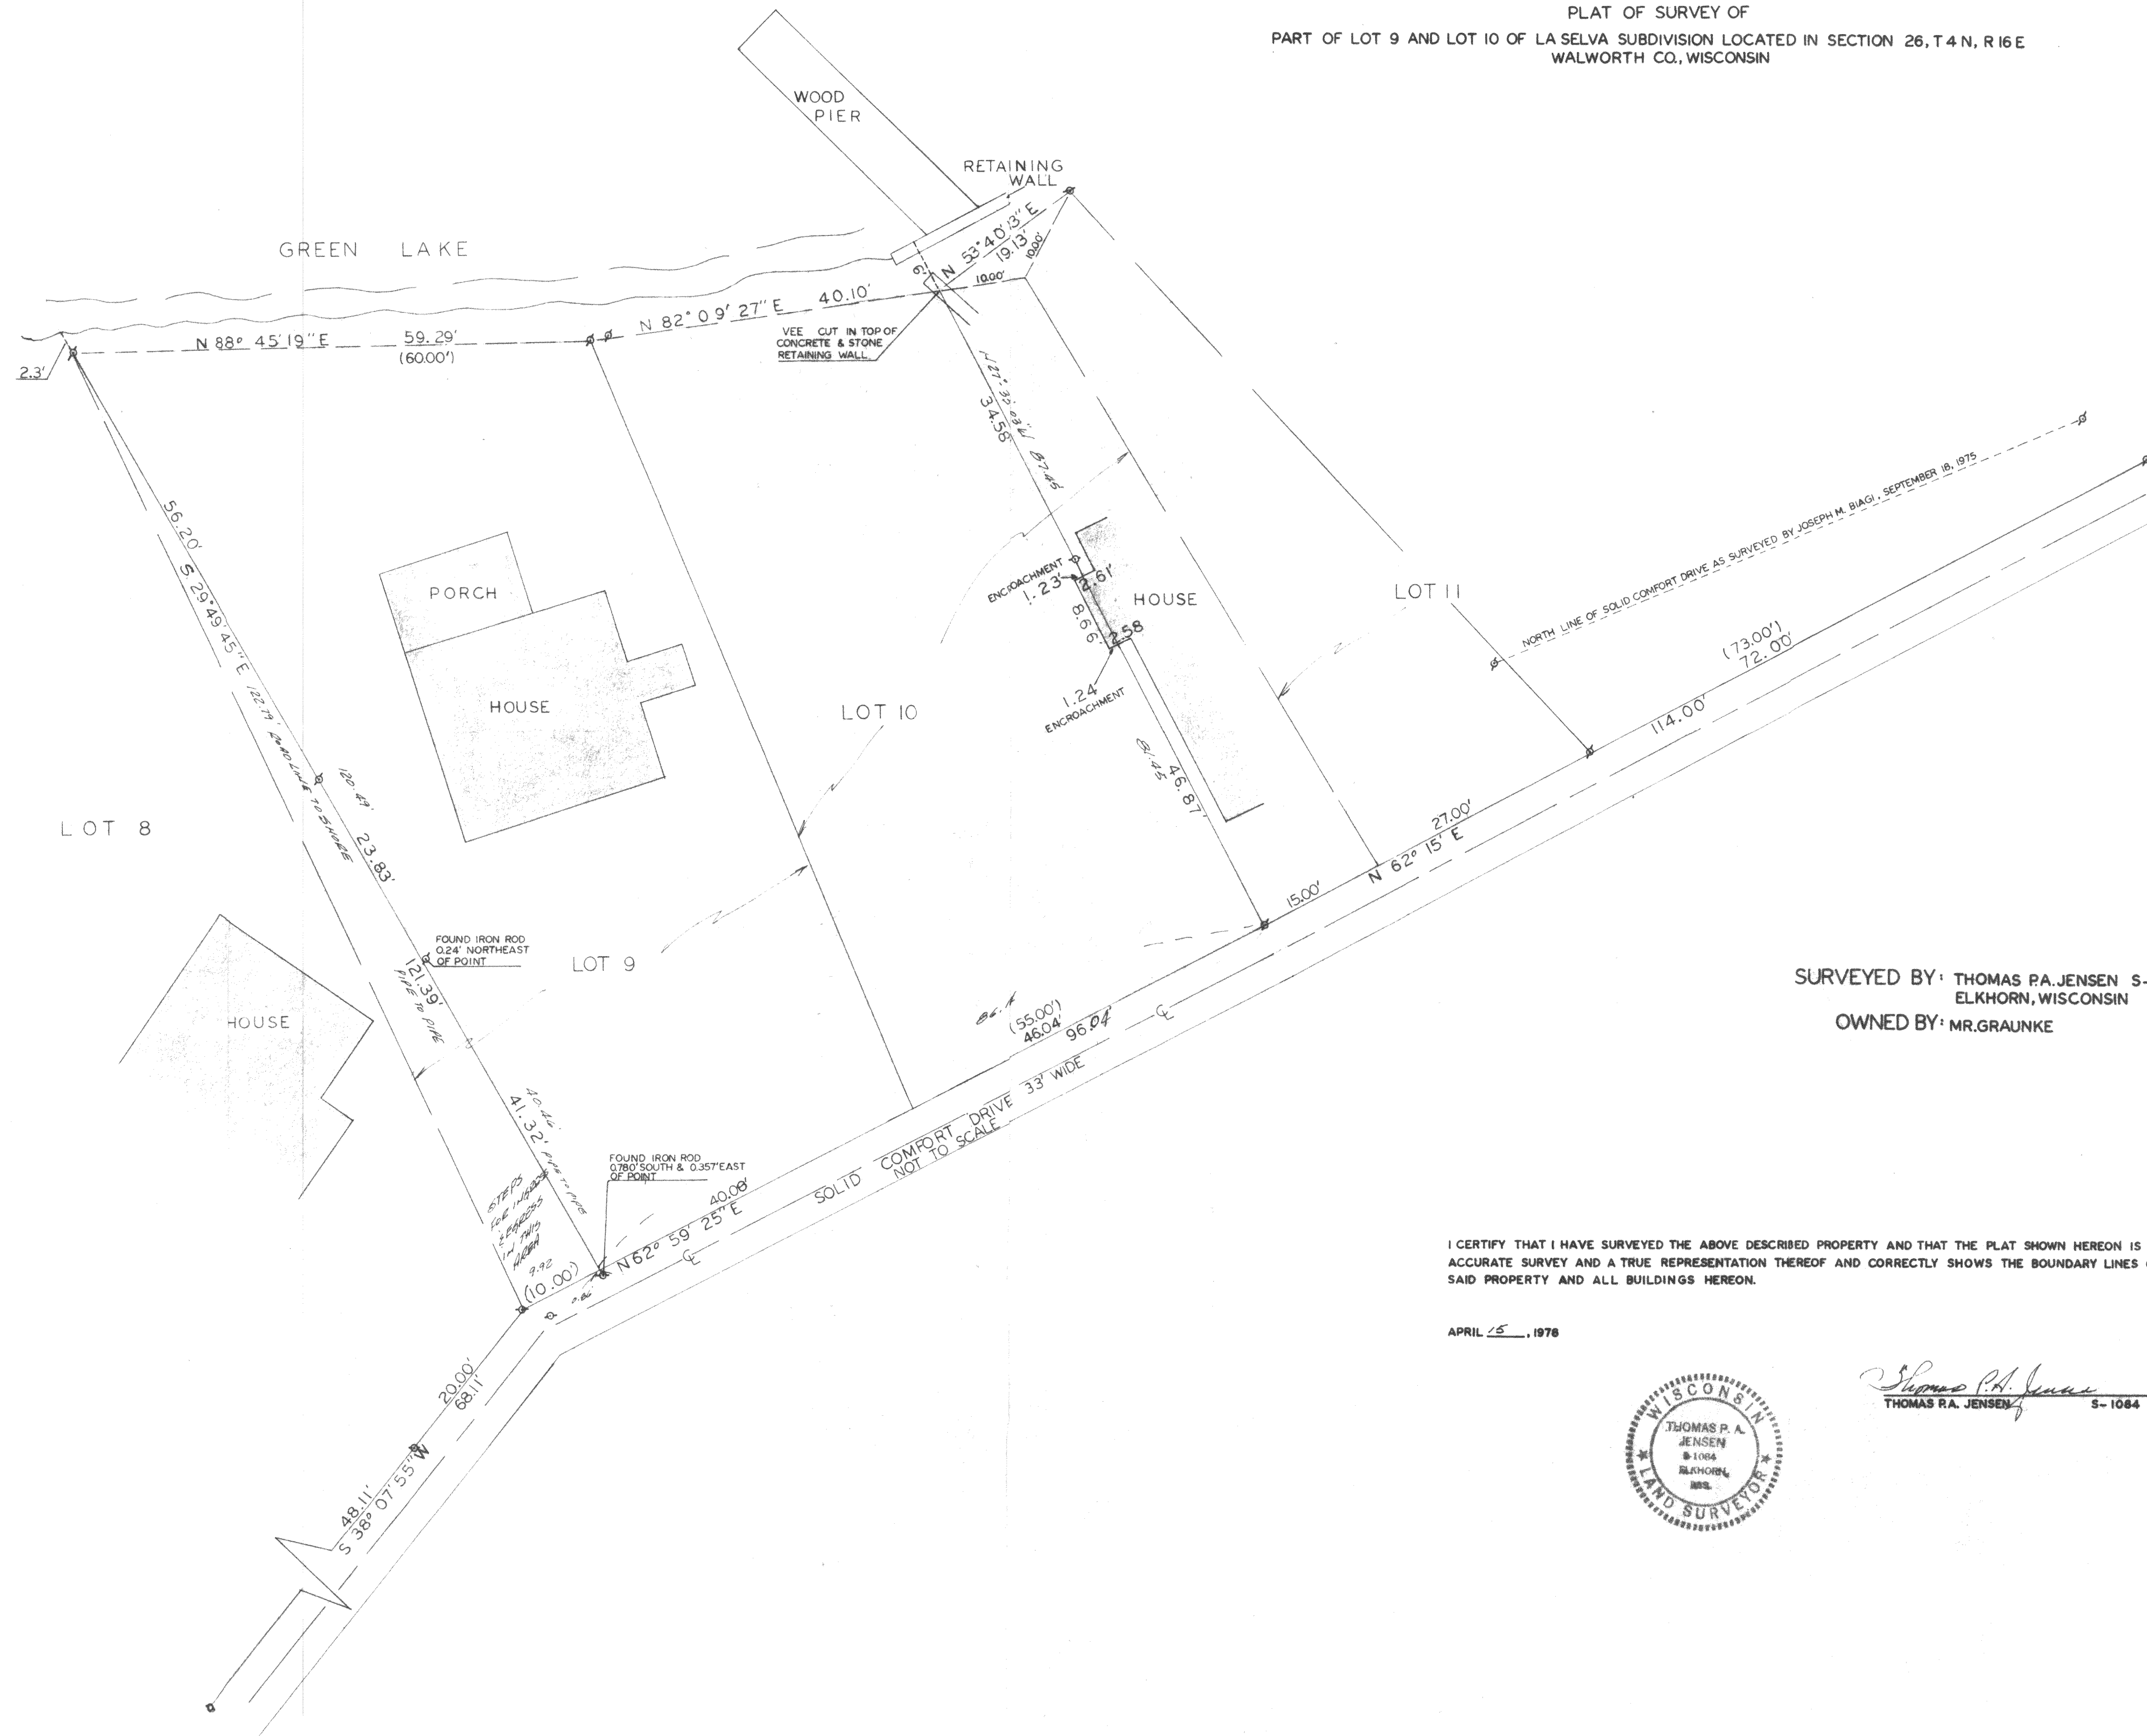


SCALE 1" = 10'

~ IRON PIPE OR ROD FOUND
NORTHERLY LINE SOLID
COMFORT DR. ASSUMED
N 62° 15' E AS PLATTED.
(RECORDED 112)

SURVEYED BY: THOMAS P.A. JENSEN S-1084
ELKHORN, WISCONSIN
OWNED BY: MR. GRAUNKE

I CERTIFY THAT I HAVE SURVEYED THE ABOVE DESCRIBED PROPERTY AND THAT THE PLAT SHOWN HEREON IS AN
ACCURATE SURVEY AND A TRUE REPRESENTATION THEREOF AND CORRECTLY SHOWS THE BOUNDARY LINES OF
SAID PROPERTY AND ALL BUILDINGS HEREON.

APRIL 15, 1978

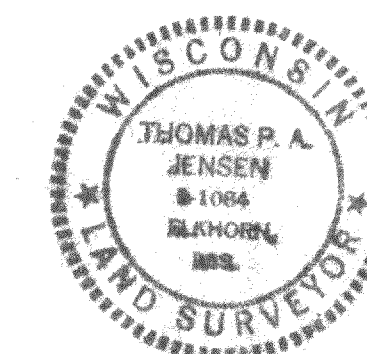


THOMAS P.A. JENSEN
THOMAS R.A. JENSEN S-1084

1977.065

.X

416-283

HHL-6A
" 7

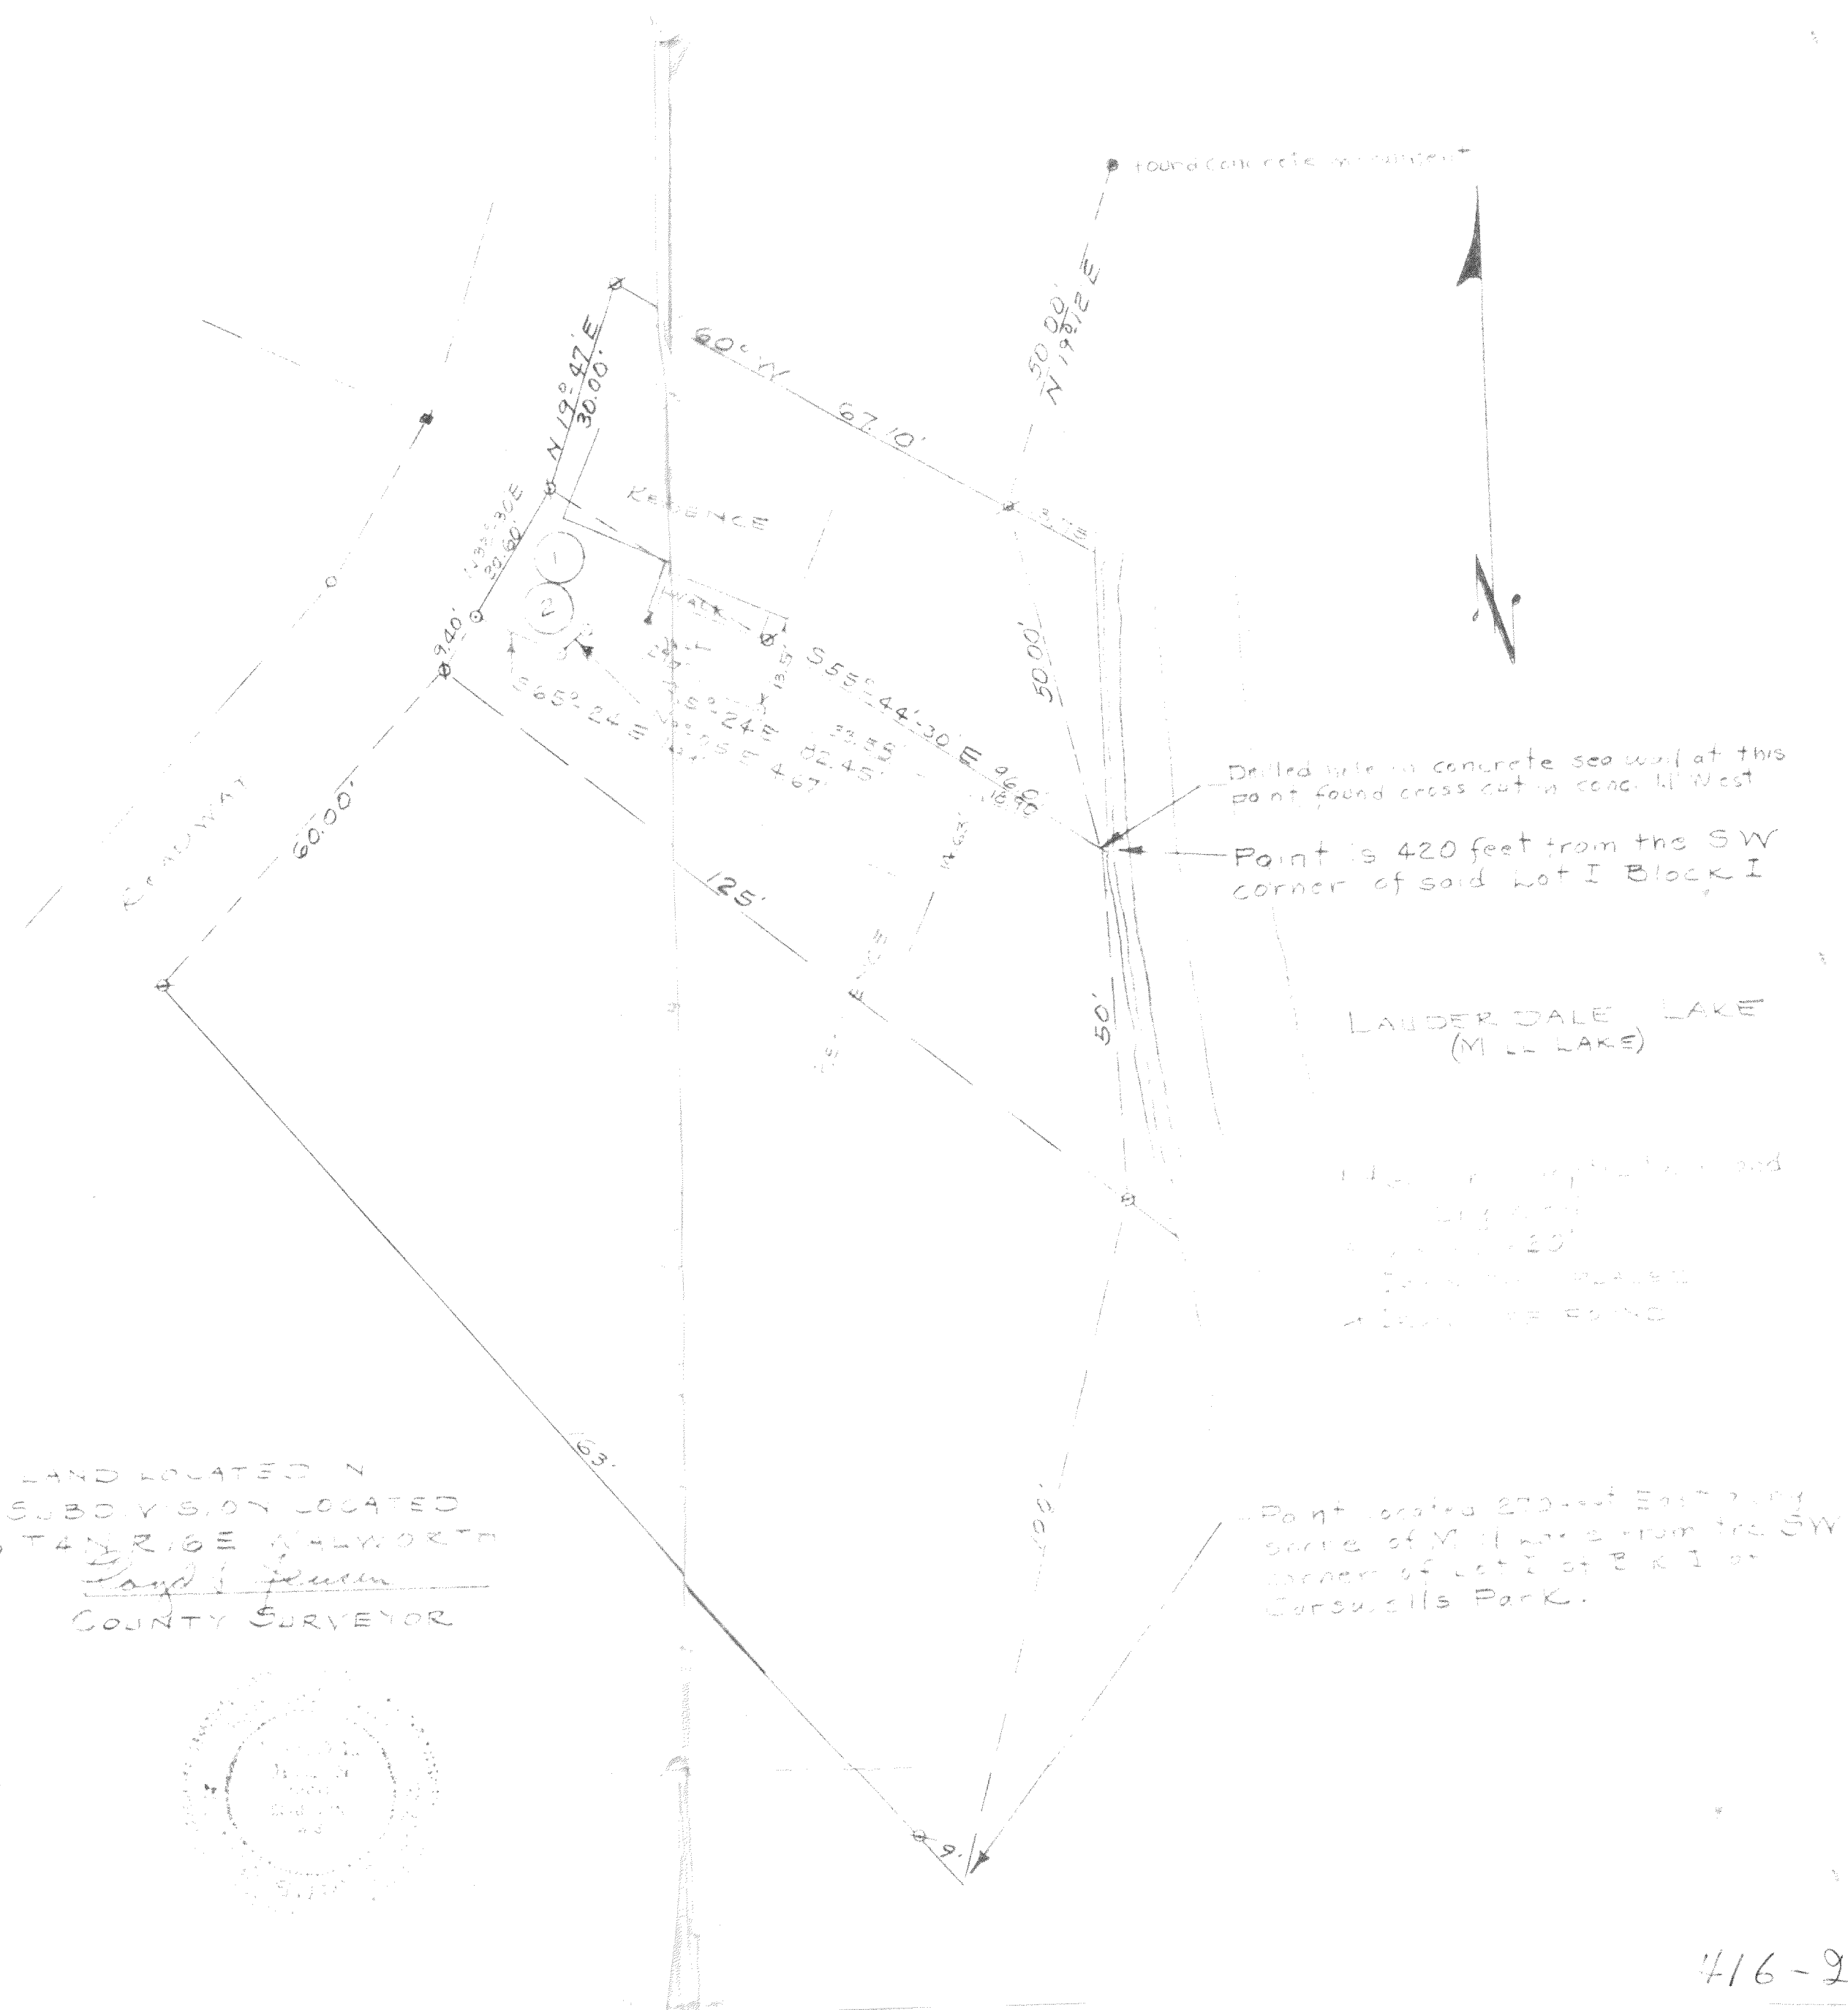

PLAT OF A SURVEY OF LAND LOCATED IN
CARSWELL PARK, A SUBDIVISION LOCATED
IN SECTIONS 35 & 36 T4N R1E W4NW
COUNTY, N.S.
JUNE 1978

COUNTY SURVEYOR

