

PREPARED FOR
PREMIER HOMES


PLAT OF SURVEY

- OF -

LOT 1, BLOCK 2 CARSWELL'S PARK, A SUBDIVISION LOCATED
IN SECTIONS 35 ANND 36, TOWN 4 NORTH, RANGE 16 EAST,
TOWN OF LA GRANGE, COUNTY OF WALWORTH AND STATE
OF WISCINSIN.



PATHFINDER SURVEYING INC.
(formerly)
J.K. SURVEYING INC.
P.O BOX 322
LAKE GENEVA, WI. 53147
WWW.PATHFINDERSURVEYING.NET
262-248-8303

MIDDLE LAKE

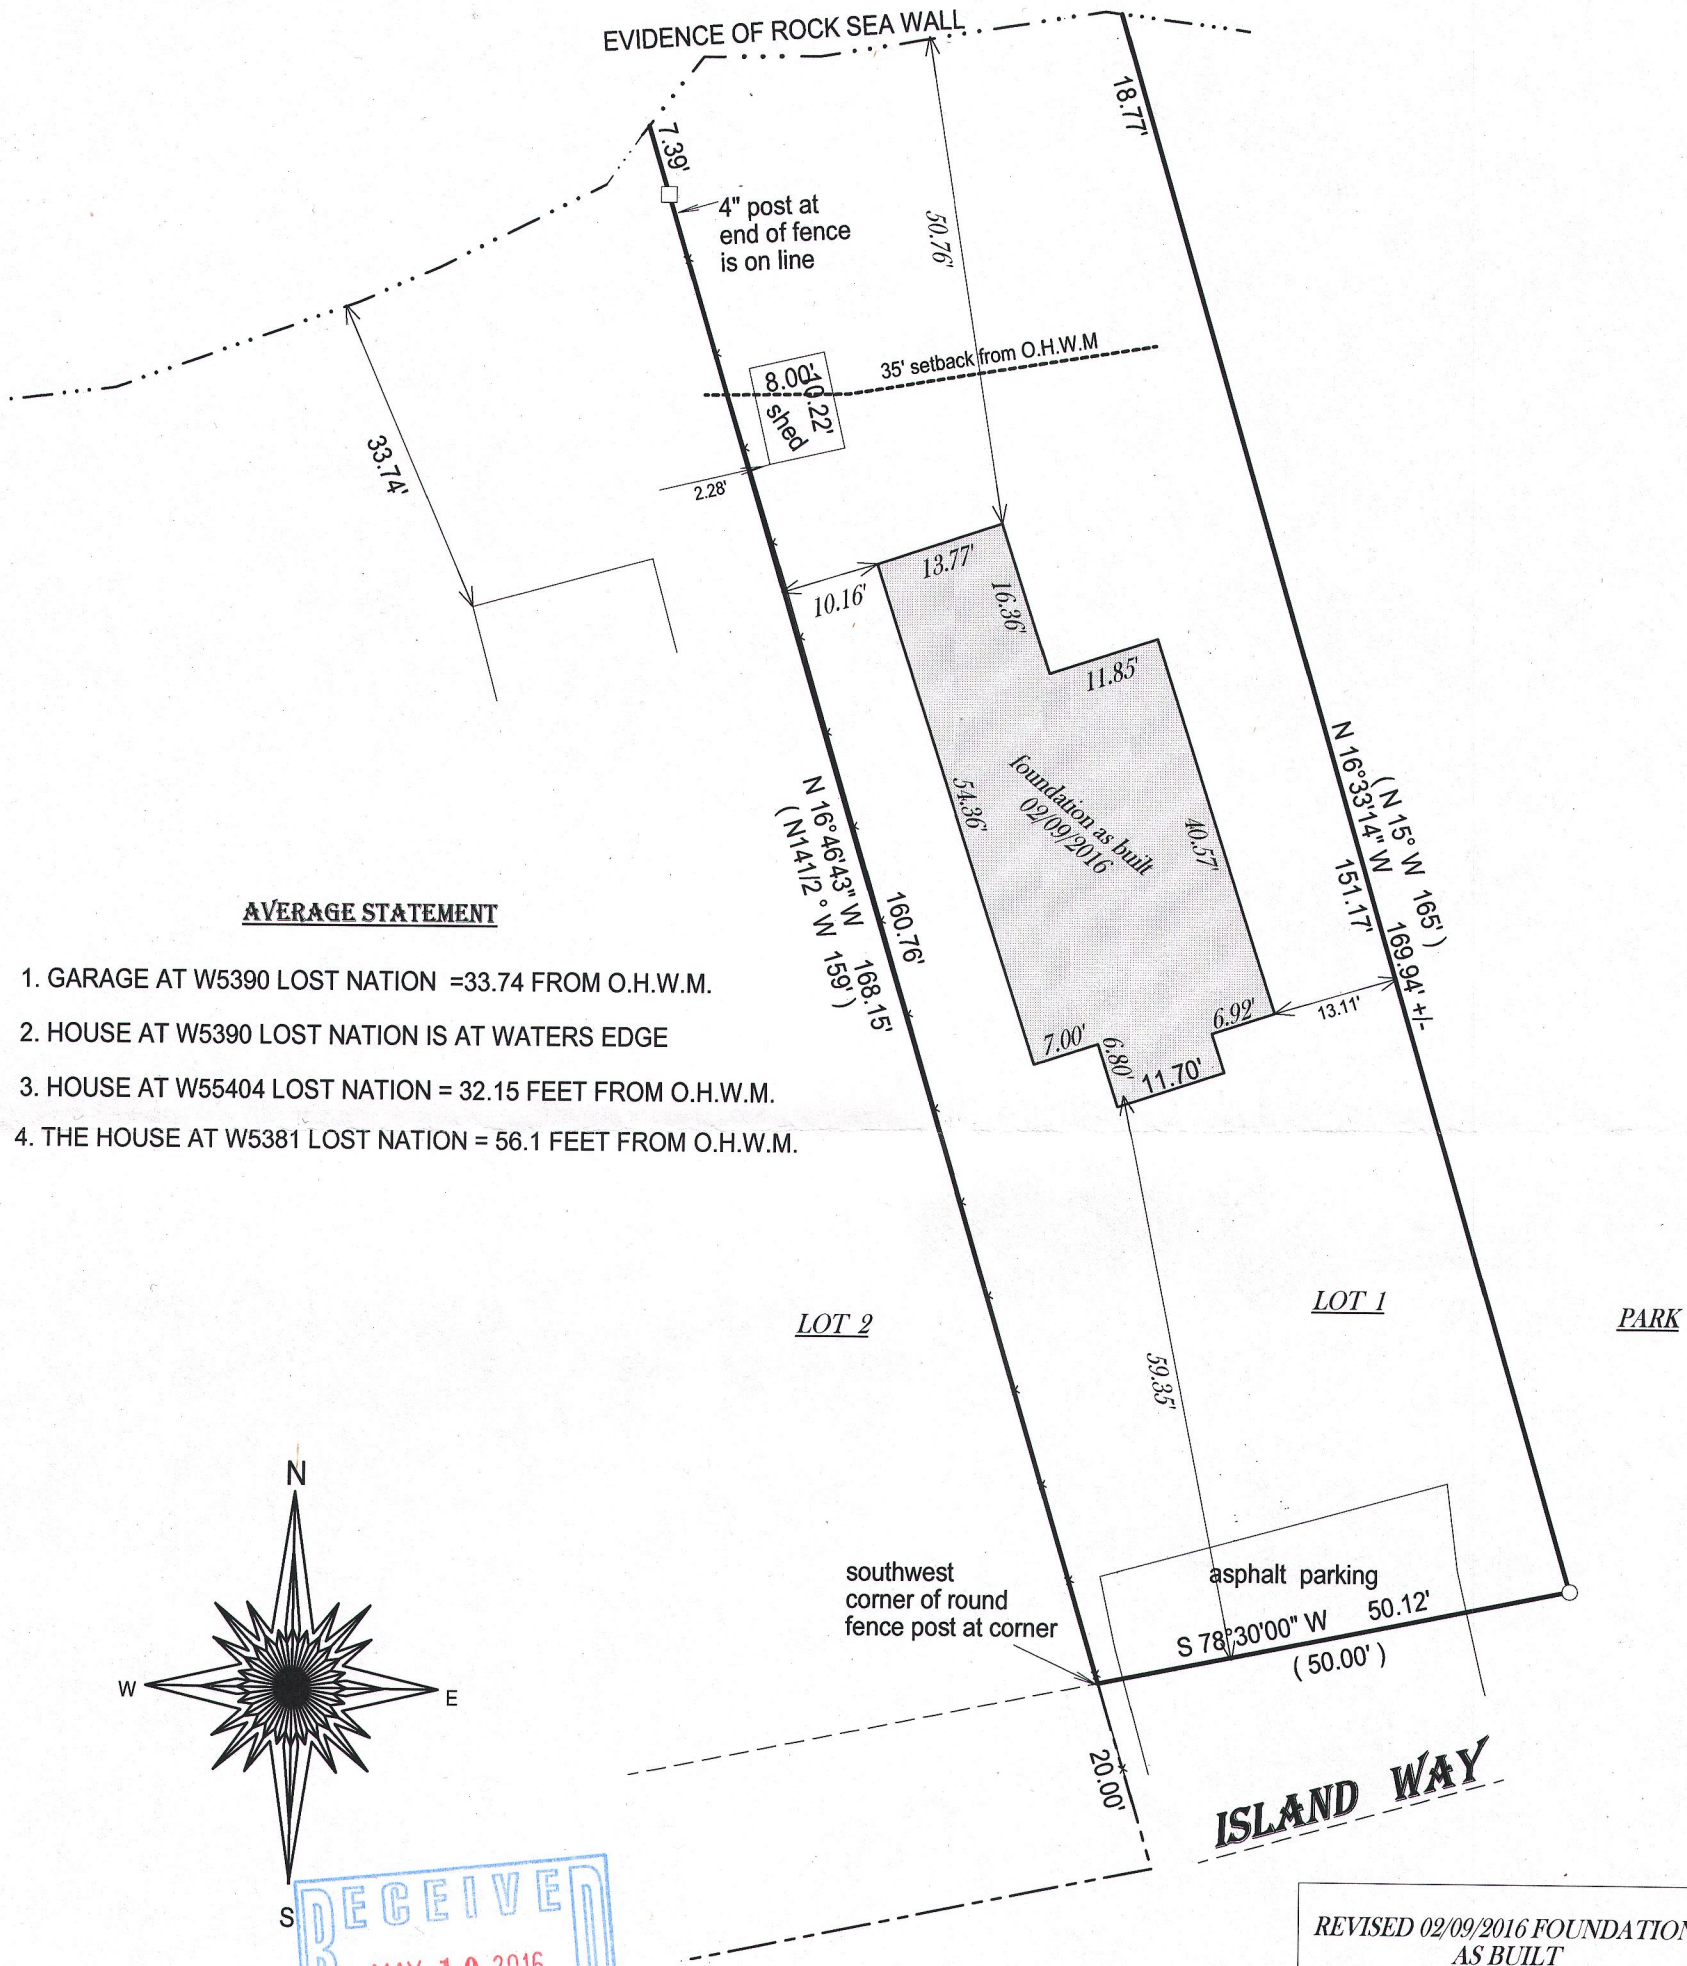

AVERAGE STATEMENT

1. GARAGE AT W5390 LOST NATION = 33.74 FROM O.H.W.M.
2. HOUSE AT W5390 LOST NATION IS AT WATERS EDGE
3. HOUSE AT W55404 LOST NATION = 32.15 FEET FROM O.H.W.M.
4. THE HOUSE AT W5381 LOST NATION = 56.1 FEET FROM O.H.W.M.

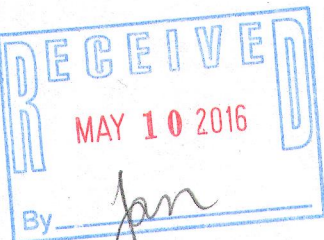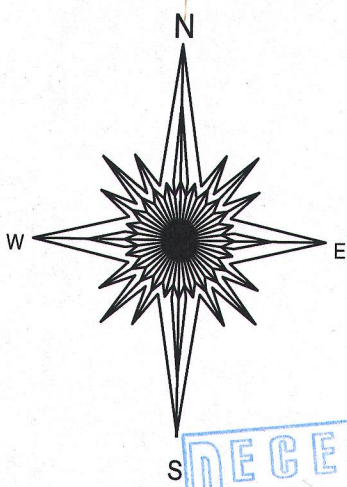


- () = recorded as
□ = found iron bar
○ = found iron pipe
● = set iron pipe
■ = set iron bar

SCALE 1" = 20'

JOB # 15-37AB

TAX ID #
HCA00021

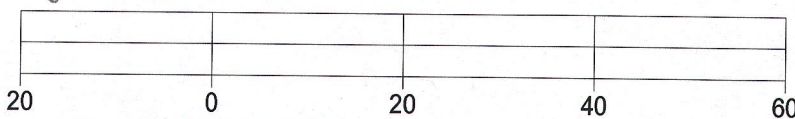

BASIS OF BEARING OF THIS PLAT: THE NORTH LINE OF
ISLAND WAY WAS ASSUMED TO BEAR S 78°30'00" W
AS RECORDED.

I hereby certify that I have surveyed the above- described property and the
above map is a true representation thereof and shows the size and
location of the property, its exterior boundaries, the location and
dimensions of all structures thereon, fences, apparrant easements and
roadways and visible encroachments if any.


This survey is made for the present owners of the property, and those who
purchase, mortgage, or guarantee the title thereto, within one year from
the date hereof.

DATED THIS 15th day of February, 2015.

REVISED 02/09/2016 FOUNDATION
AS BUILT

REVISED 11/12/2015 ADDED PROPODED
RESIDENCE AND DECK

REVISED 02/27/2015 ADDED ADDITIONAL
SET BACK INFORMATION

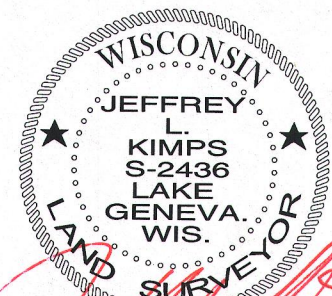

JEFFREY L. KIMPS S - 2436
Wisconsin Professional Land Surveyor
(original if signed in red)