


PREPARED FOR
LAURIE BOVIALI
REALTY EXECUTIVES

PLAT OF SURVEY

- OF -

LOT 8, BLOCK 4 COOL HILL PARK, A SUBDIVISION LOCATED IN THE NW 1/4 AND
SW 1/4 OF SECTION 35, TOWN 4 NORTH, RANGE 16 EAST, TOWN OF LAGRANGE,
COUNTY OF WALWORTH AND STATE OF WISCONSIN.

PATHFINDER SURVEYING INC.
(formerly)
J.K. SURVEYING INC.
P.O BOX 322
LAKE GENEVA, WI. 53147
WWW.PATHFINDERSURVEYING.NET
262-248-8303

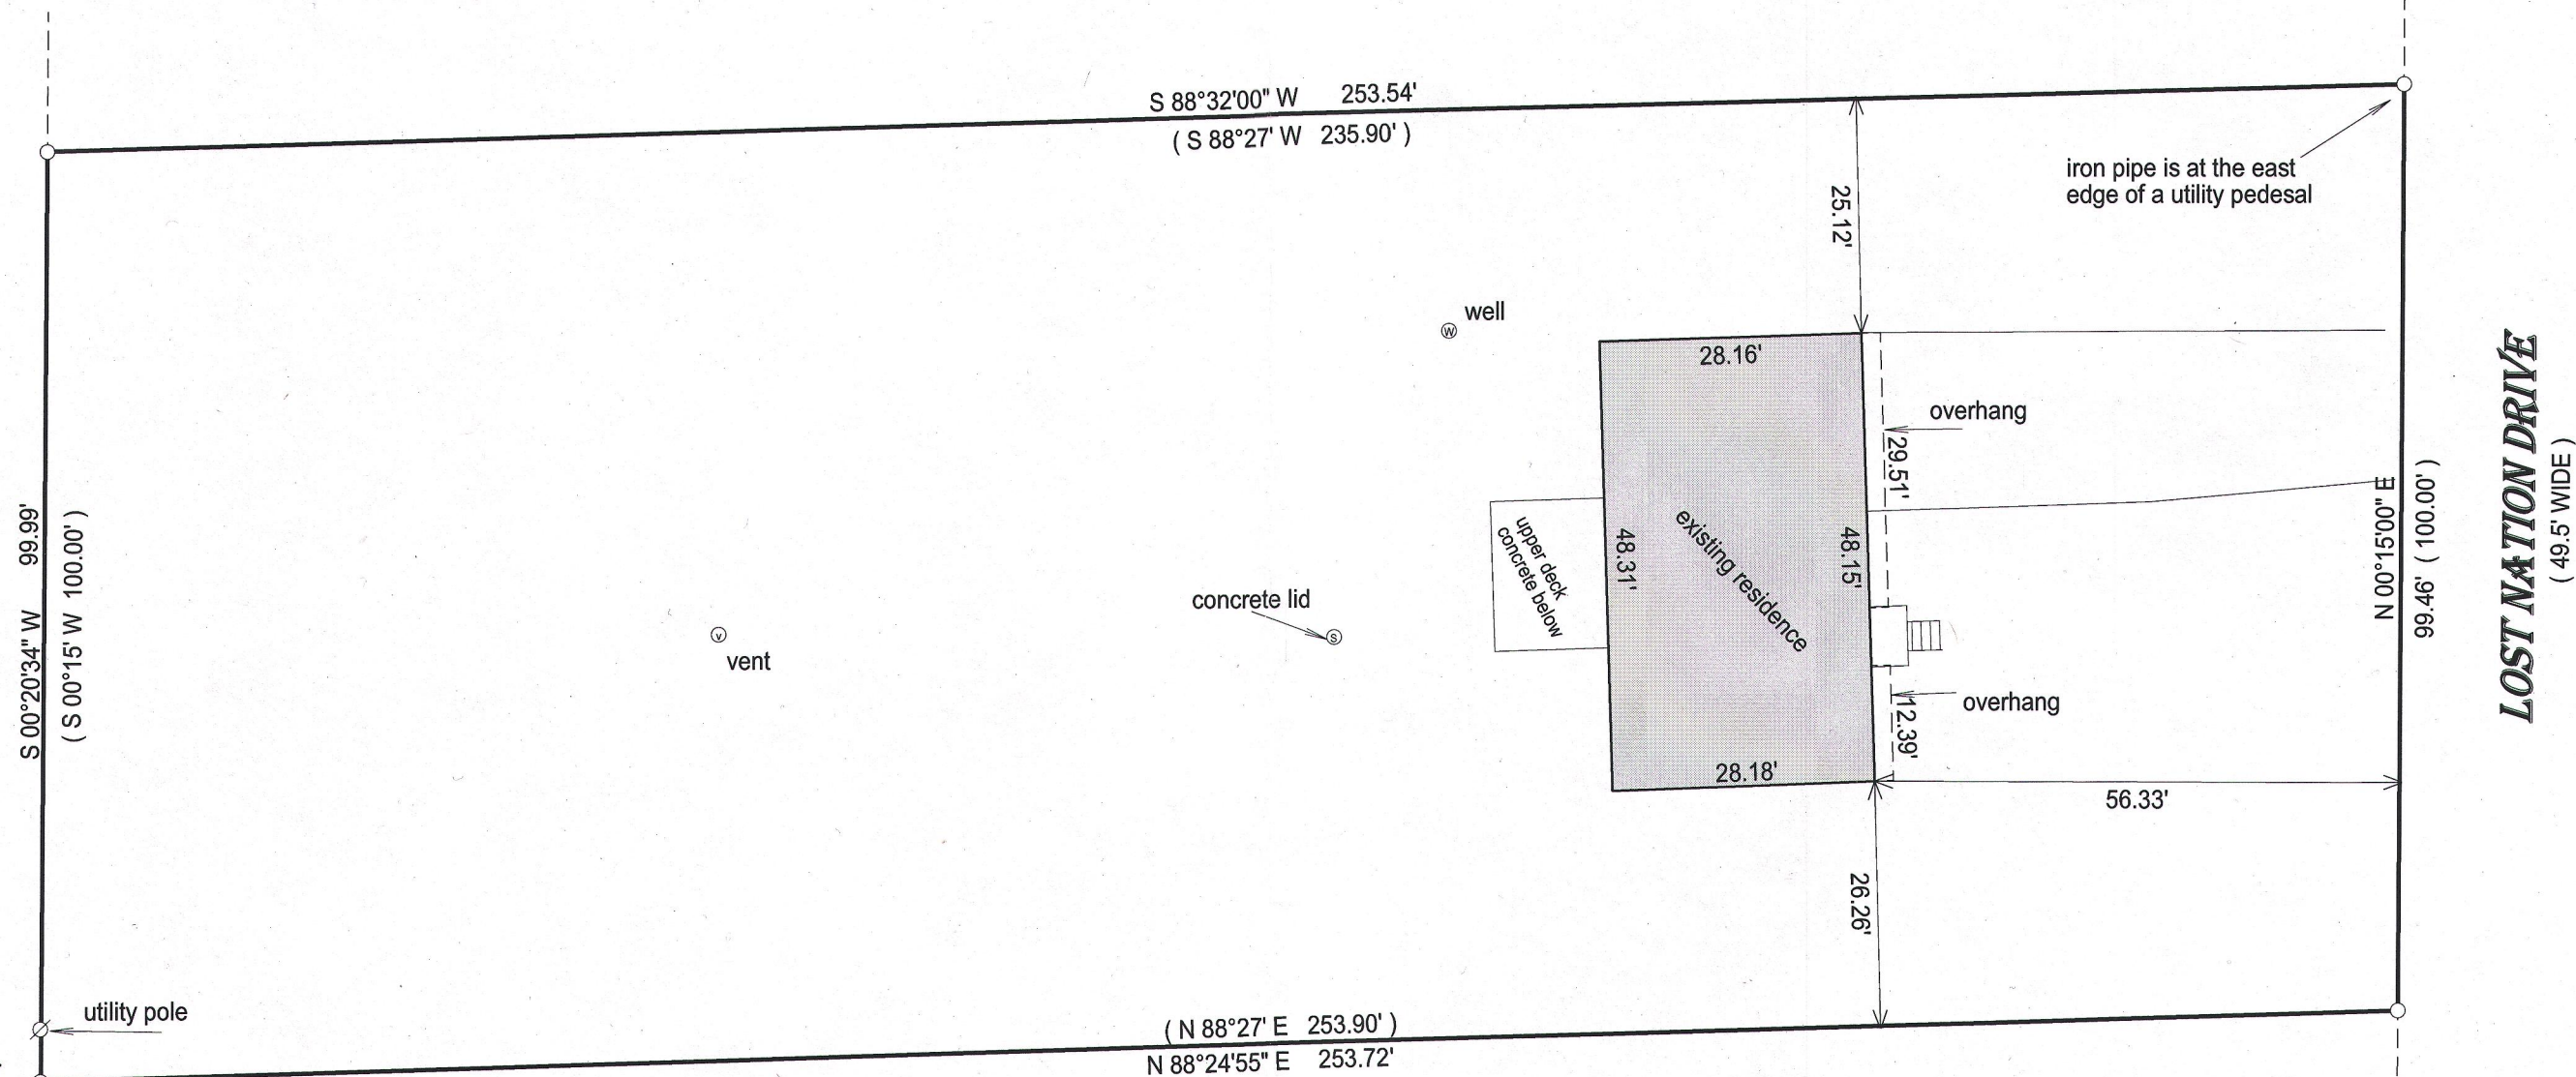


- () = recorded as
□ = found iron bar
○ = found iron pipe
● = set iron pipe
■ = set iron bar

SCALE 1" = 20'

JOB # 16-11

TAX ID # HCH 00027


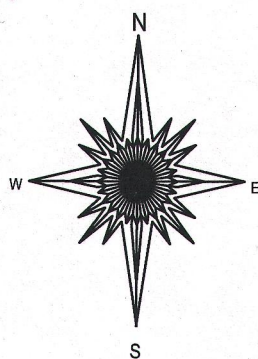


20 0 20 40 60
BASIS OF BEARING OF THIS PLAT: THE WEST LINE OF LOST NATION WAS ASSUMED
TO BEAR N 0°15' E AS PLATTED.

"I hereby certify that I have surveyed the above described property and that the above
map is a true representation of its exterior boundary and shows the size and location of
all visible structures, apparent easements and encroachments if any."

This survey is made for the present owners of the property, and those who
purchase, mortgage, or guarantee the title thereto, within one year from
the date hereof.

DATED THIS 21st DAY OF JANUARY, 2016.

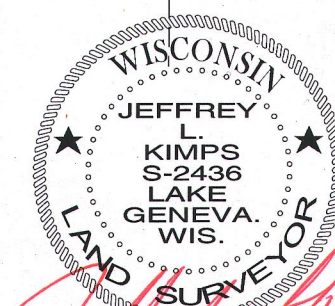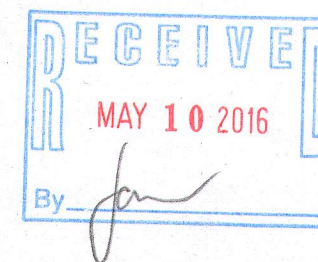

JEFFREY L. KIMPS S-2436
Wisconsin Professional Land Surveyor
(original if signed in red)

HCH-27

416-2834