


BOUNDARY & TOPOGRAPHIC SURVEY
LOT 6 OF SOUTHMOOR SUBDIVISION
LOCATED IN THE SE 1/4 OF THE SW 1/4
SECTION 25
TOWN 4 NORTH, RANGE 16 EAST
WALWORTH COUNTY, WISCONSIN

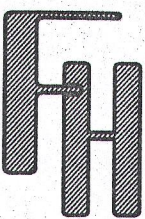

ORDERED BY:
TONY BALISTRERI
1538 COUNTRY CLUB PKWAY
ELKHORN, WI. 53121

FARRIS, HANSEN & ASSOCIATES, INC.
ENGINEERING - ARCHITECTURE - SURVEYING
7 RIDGWAY COURT P.O. BOX 437
ELKHORN, WISCONSIN 53121
OFFICE: (262) 723-2088 FAX: (262) 723-5886

REVISIONS

PROJECT NO.
9377
DATE:
10-07-2015
SHEET NO.
1 OF 1

ASSIGNED SOUTH LINE LOT 6
N 84°15'00" W

ASTA DRIVE
(66' WIDE)

LOT 5
GARAGE ENTRY LOT 5 = 941.2'

S 84°14'34" E 200.03

N 05°44'18" E

LOT 6
31,210 S.F.
0.72 AC.

AS BUILT RESIDENCE

PROPOSED SEPTIC
SYSTEM FIELD

PROPOSED
SEPTIC TANK

N 84°15'00" W

200.06

LOT 7

GARAGE ENTRY
931.1'

FLOOR EL.
932.8'

TOP = 931.6'

AS BUILT
FOUNDATION

U.S. HWY "12"

LEGEND
● = SET IRON REBAR STAKE
● = FOUND IRON REBAR STAKE
(XXX) = RECORDED AS


NOTE: COPIES OF THIS MAP TO WHICH THE FOLLOWING CERTIFICATE
WILL APPLY SHOW THE SURVEYOR'S ORIGINAL SEAL AND SIGNATURE
IN RED INK. COPIES BY ANY OTHER MEANS MAY HAVE ALTERATIONS
WHICH DO NOT REPRESENT THE SURVEYOR'S WORK PRODUCT.

I HEREBY CERTIFY THAT THE ABOVE DESCRIBED PROPERTY HAS BEEN
SURVEYED UNDER MY DIRECTION AND THAT THE ABOVE MAP IS A TRUE
REPRESENTATION THEREOF AND SHOWS THE SIZE AND LOCATION OF
THE PROPERTY AND ITS EXTERIOR BOUNDARIES. THIS SURVEY IS
MADE FOR THE USE OF THE PRESENT OWNERS OF THE PROPERTY, AND
ALSO THOSE WHO PURCHASE, MORTGAGE, OR GUARANTEE THE TITLE
THERE TO WITHIN ONE YEAR FROM THE DATE HEREOF.


DATED: OCTOBER 7, 2015

REVISED 3/17/2016-KB
TO SHOW SIZE & LOCATION OF
PROPOSED RESIDENCE
REVISED 04-20-2016
TO SHOW SIZE & LOCATION OF
AS BUILT FOUNDATION

PETER S. GORDON P.L.S. 2101

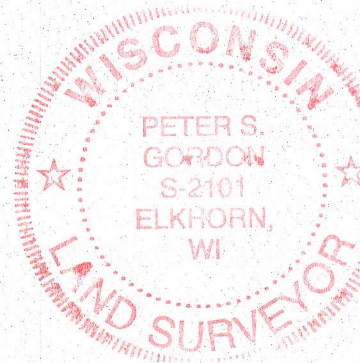

MAP SCALE IN FEET ORIGINAL 1" = 20'

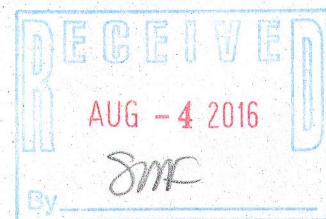

APR 21 2016

4/21/2016 X:\Projects\9377\DCAD\TOPO

HSM-6

416-2851