



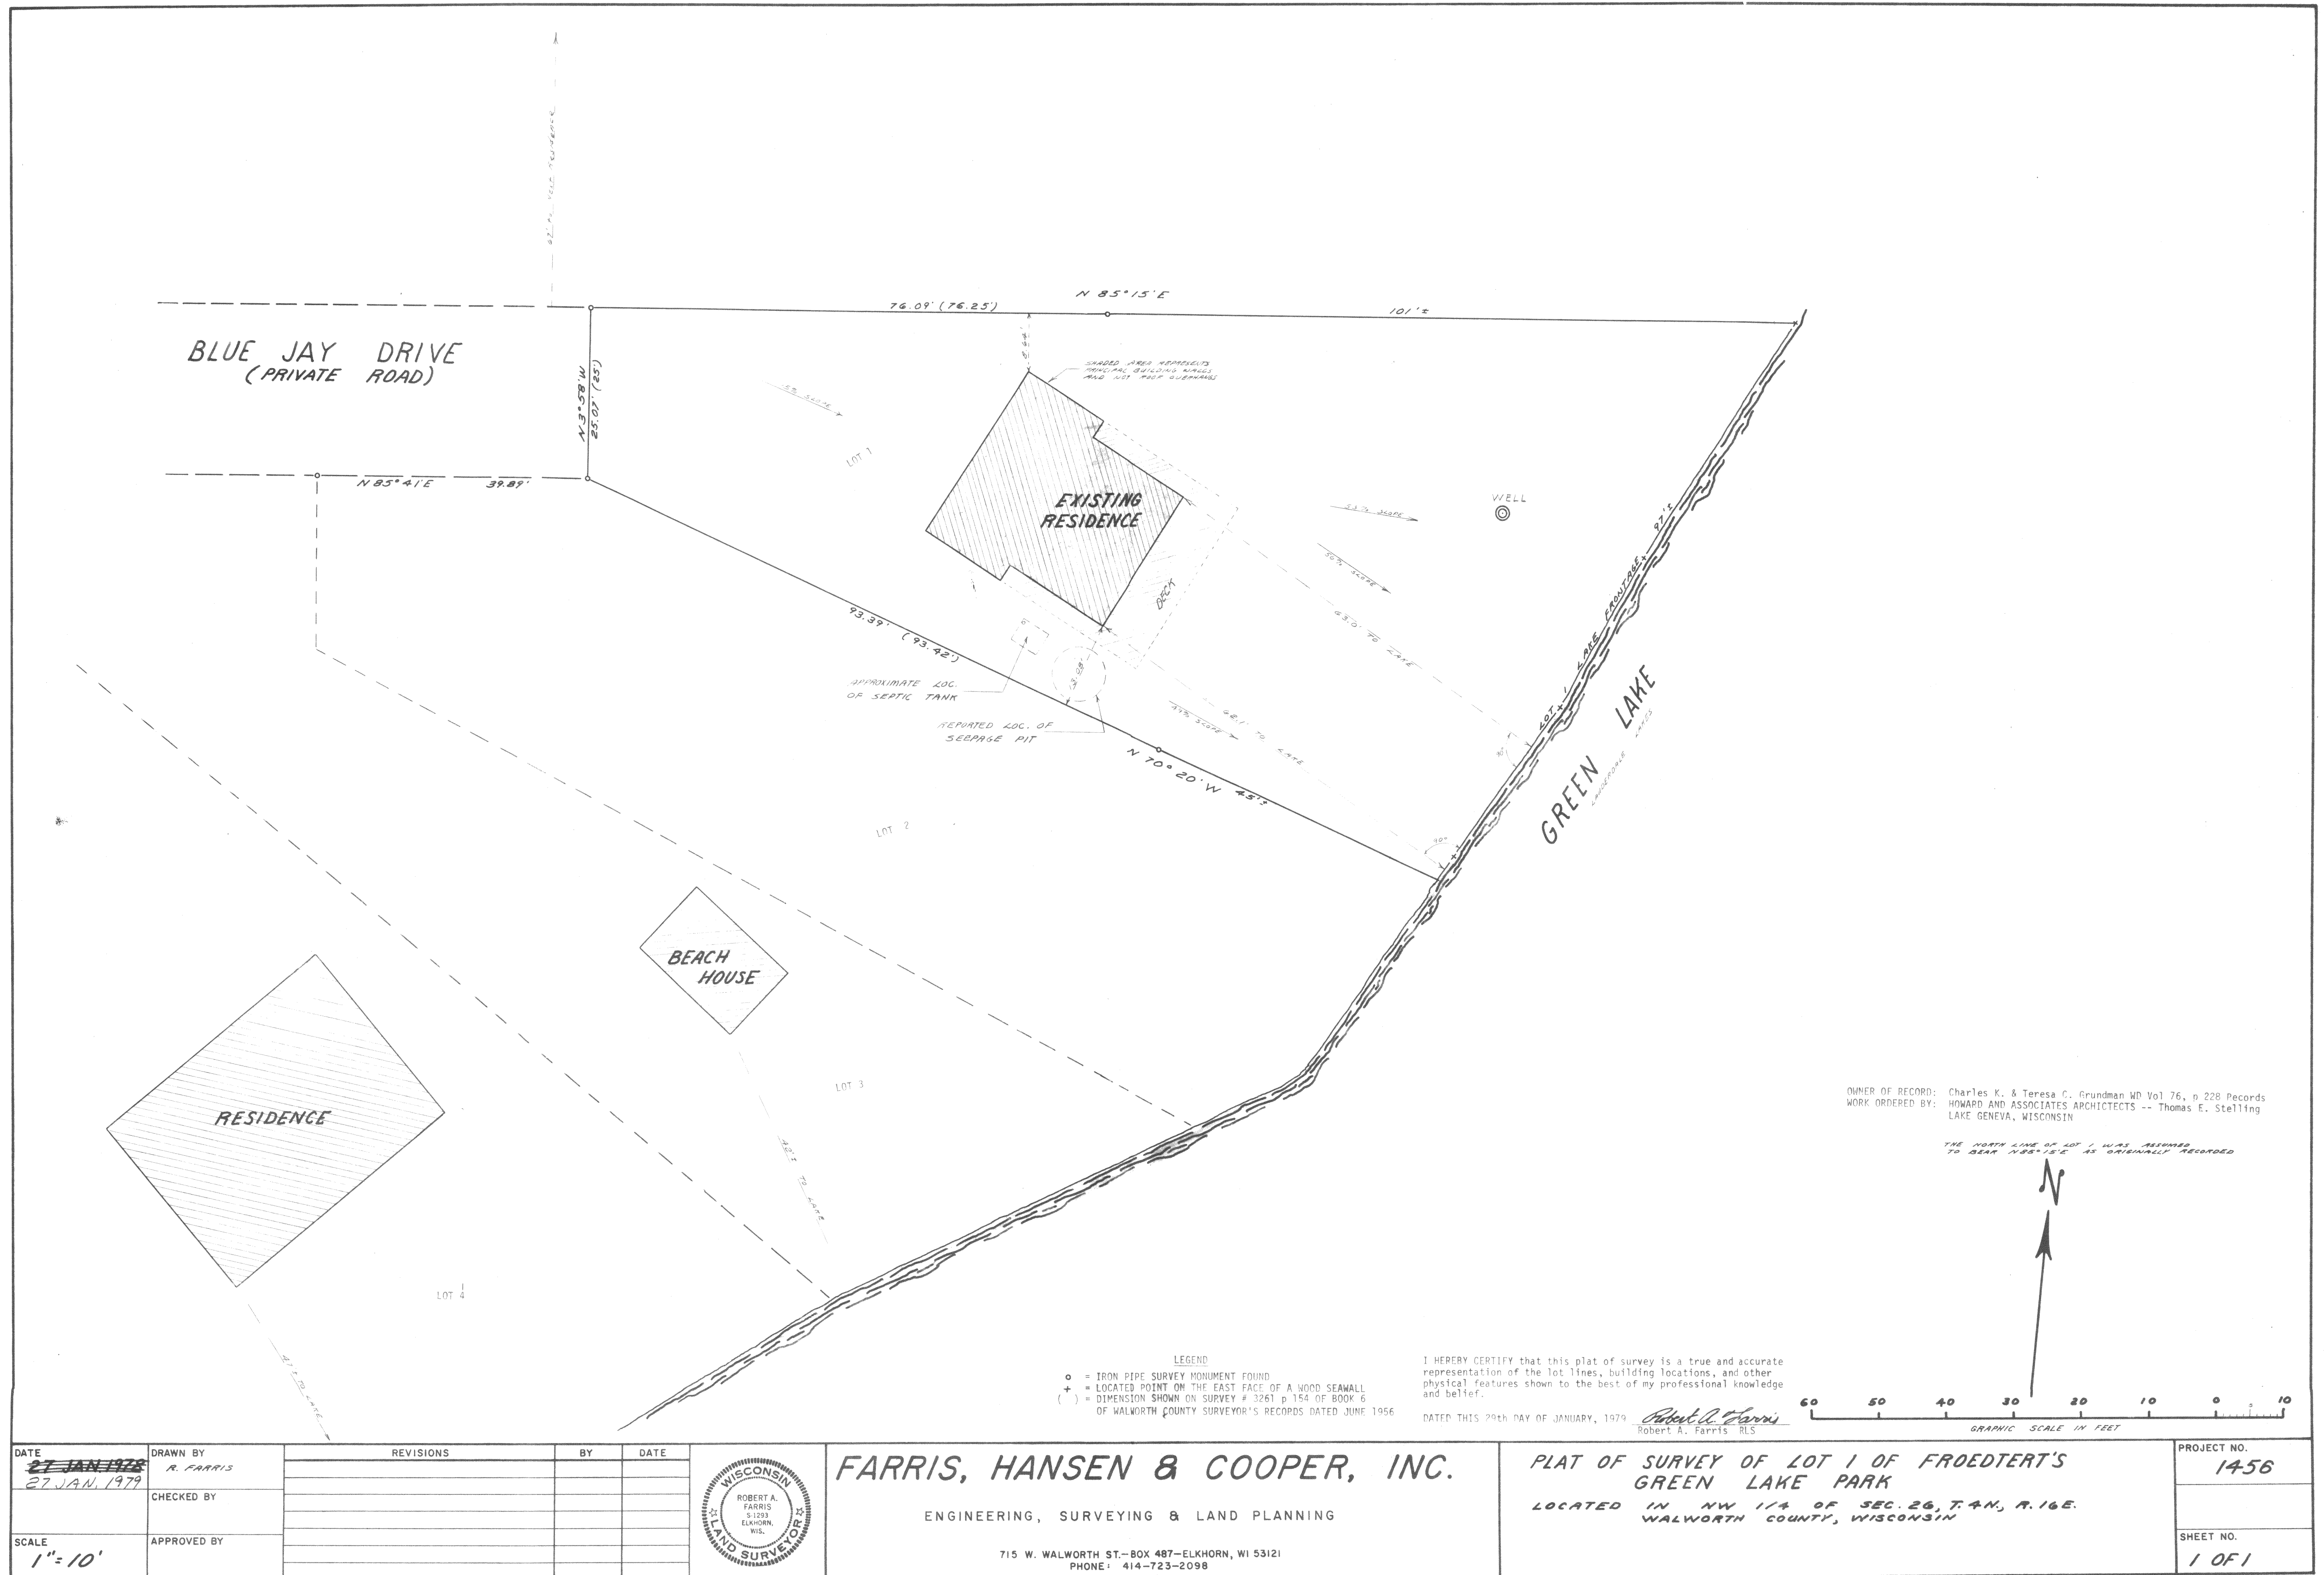

DATE 27 JAN 1978 27 JAN 1979	DRAWN BY R. FARRIS	REVISIONS	BY	DATE
	CHECKED BY			
	APPROVED BY			
SCALE 1"=10'				

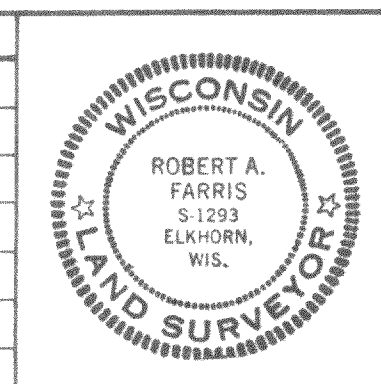

FARRIS, HANSEN & COOPER, INC.
ENGINEERING, SURVEYING & LAND PLANNING
715 W. WALWORTH ST.-BOX 487-ELKHORN, WI 53121
PHONE: 414-723-2098

PLAT OF SURVEY OF LOT 1 OF FROEDTERT'S GREEN LAKE PARK
LOCATED IN NW 1/4 OF SEC. 26, T.4N., R.16E.
WALWORTH COUNTY, WISCONSIN

PROJECT NO.
1456
SHEET NO.
1 OF 1