
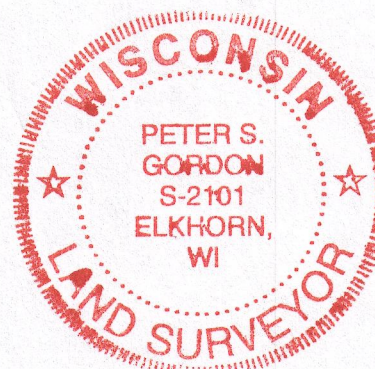
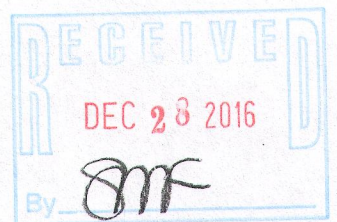


FARRIS, HANSEN & ASSOCIATES, INC.


ENGINEERING — ARCHITECTURE — SURVEYING
7 RIDGWAY COURT — P.O. BOX 437 — ELKHORN, WISCONSIN 53121
PHONE: (262) 723-2098 FAX: (262) 723-5886

ADDENDUM TO CSM 4651 FOR PROPOSED GARAGE PERMIT

— WORK ORDERED BY —
RONALD DIEDERICH
14 LOCHBROOK LANE
INVERNESS, IL. 60010

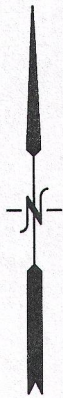

REVISED 11-18-2016
TO SHOW AS BUILT GARAGE

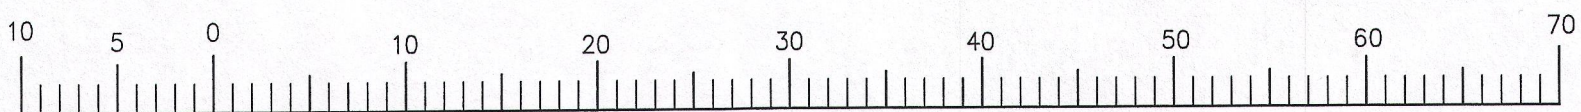

MAP SCALE IN FEET ORIGINAL 1" = 10'

PROJECT: 9470
DATE: 06-15-2015
SHEET 1 OF 1

HA4651-1

NOV 18 2016

416-2886