


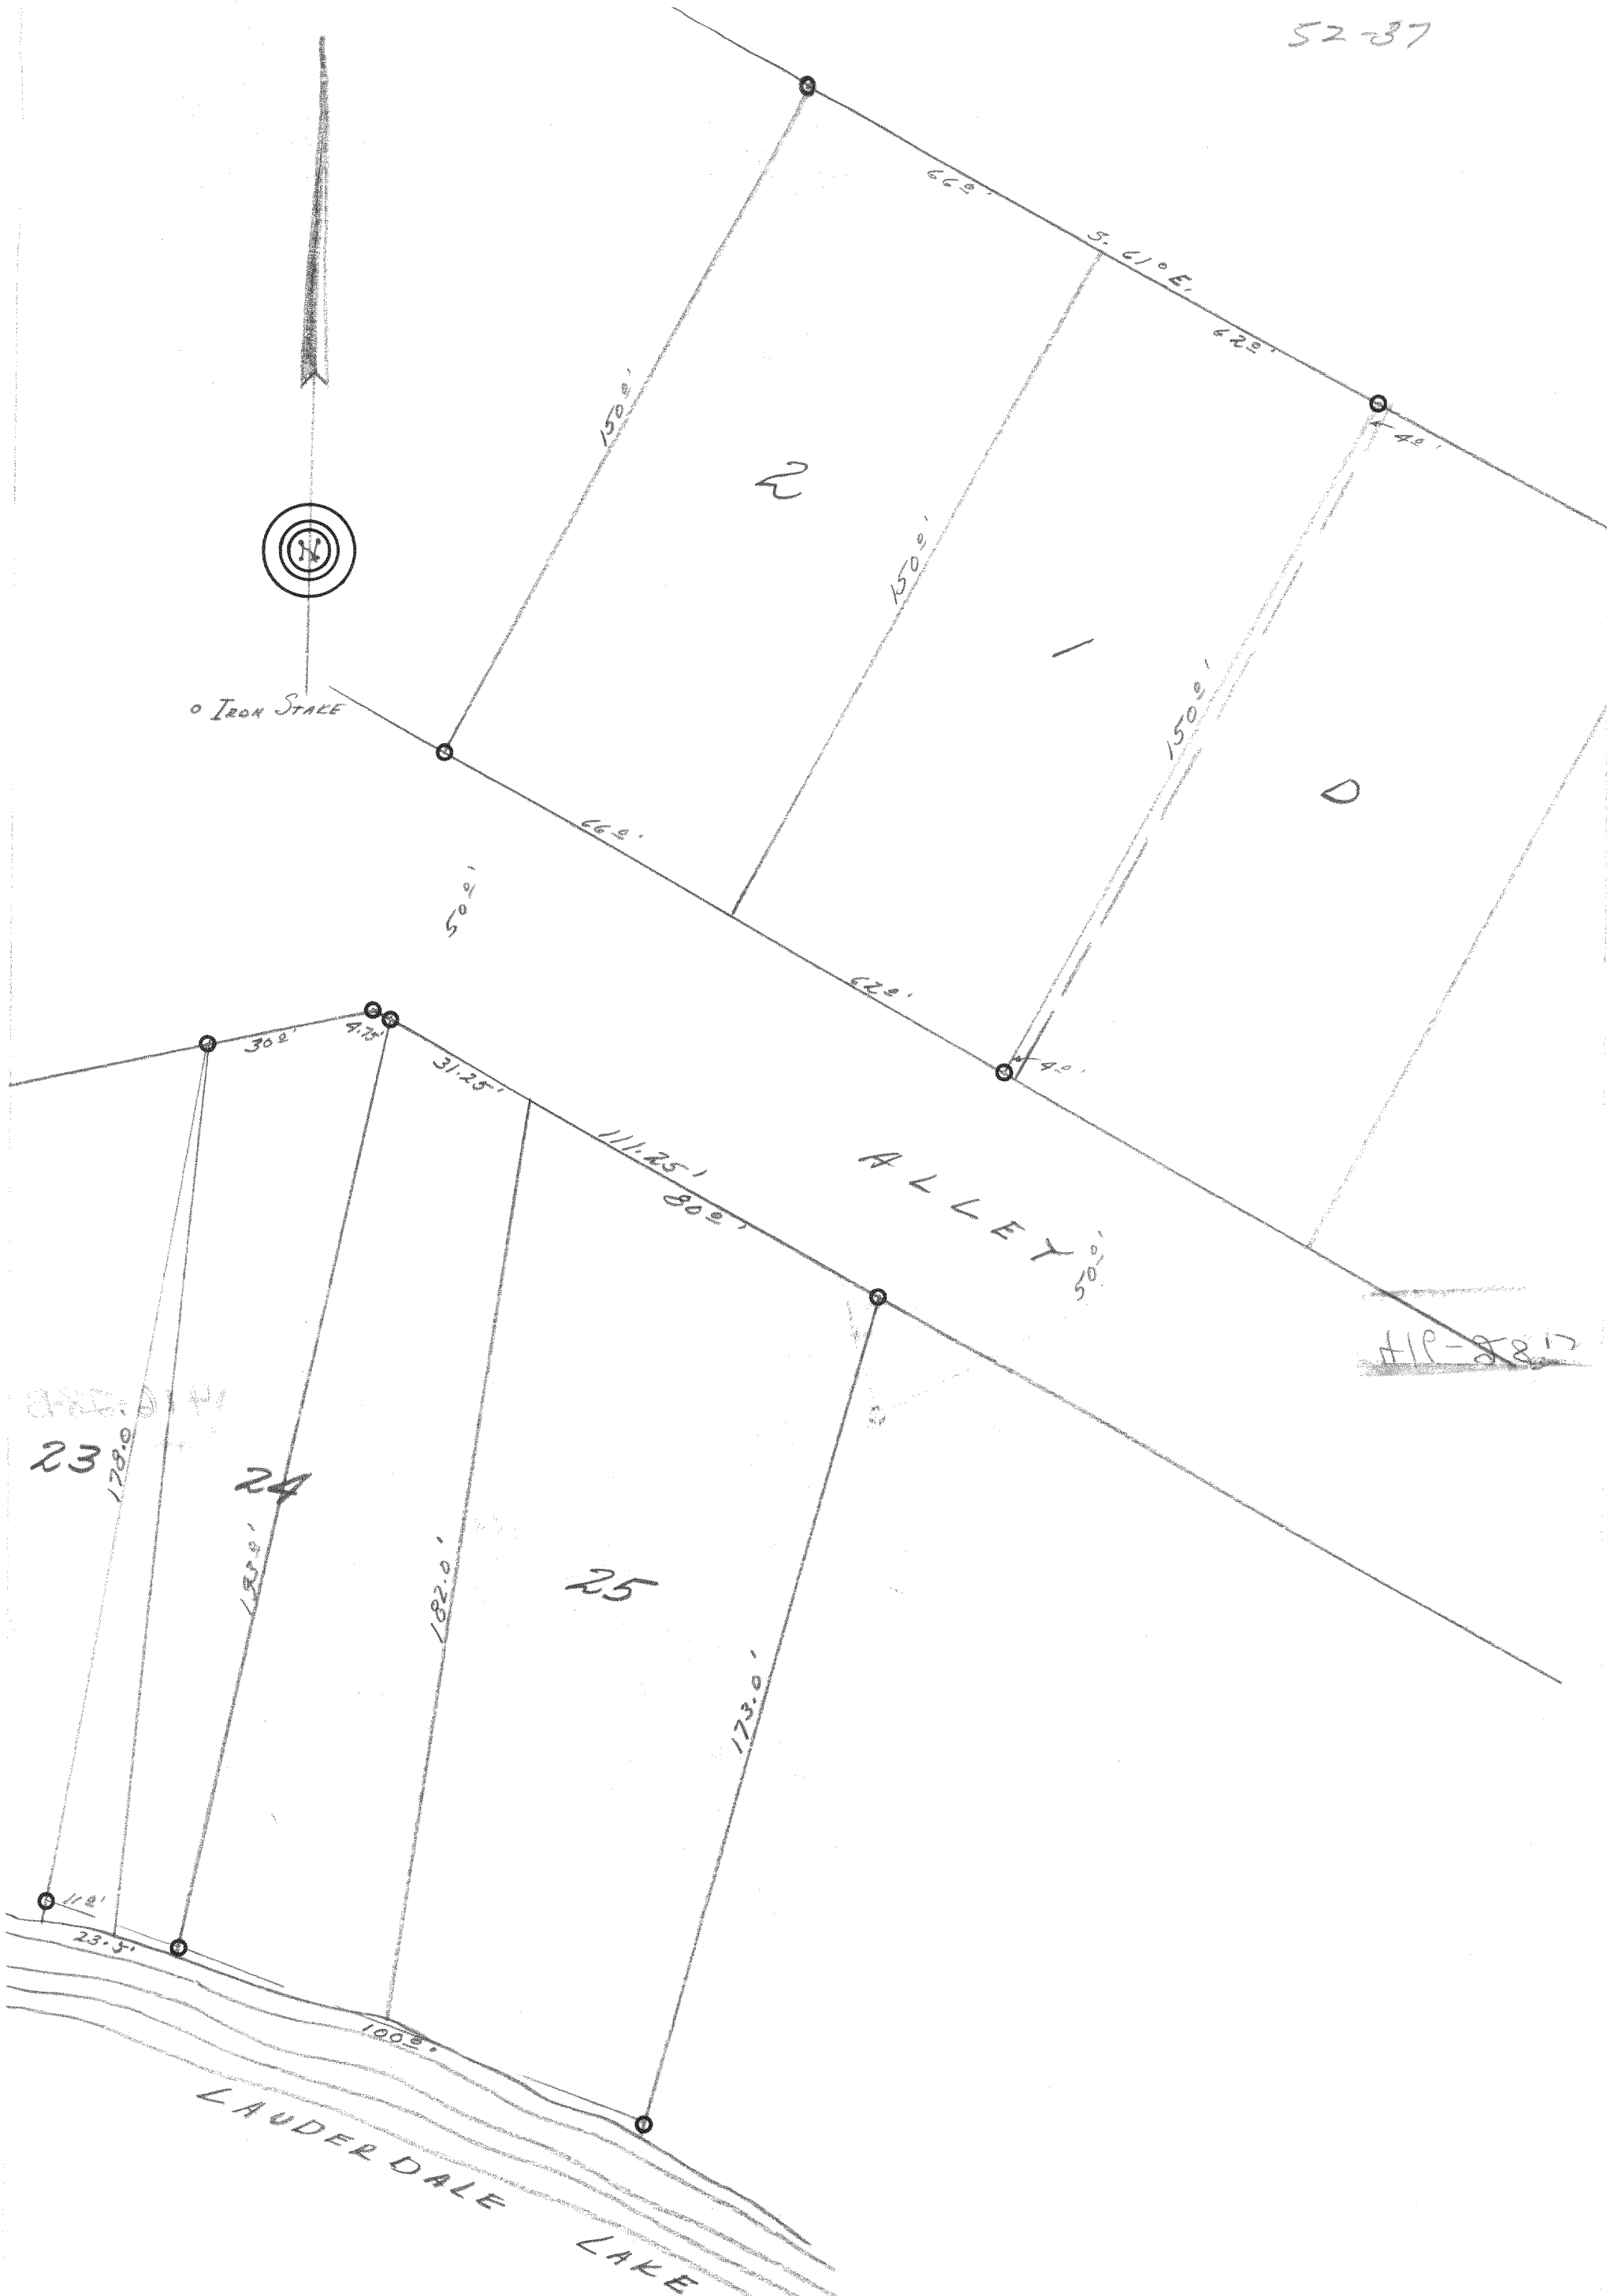

DESCRIPTION: Commencing at the northeast corner of Lot 25 Droughtville Park, in Section 25, Town 4 north, Range 16 east of the 4th P. M. thence northwest along the north line of Lot 25 and Lot 24 in said Droughtville Park 111.25 feet to an iron stake, thence south 192.0 feet to an iron stake on the shore of Lauderdale Lake, thence southeasterly along the shore of said lake 100.0 feet to an iron stake, thence northeasterly along the east line of said Lot 25, 173.0 feet to the place of beginning

CERTIFICATE: I, hereby certify that I have on this the 31st day of July surveyed the above described property.

SIGNED AND SEALED ON THIS THE 1 ST DAY OF AUGUST 1952.

DP-11
DP-24

Joseph M. Biagi
Joseph M. Biagi, Professional Engineer.
Elkhorn Wisconsin.