

Plat of Survey

of

Lot 27 in Block 2 of Pebble Beach,


a subdivision located in the Northeast 1/4 of Section 26, Town 4 North,
Range 16 East, Town of LaGrange, Walworth County, Wisconsin.

Surveyed for:

Pebble Beach Property Owners Association

c/o Rodger Beck

W5295 Court Lane
Elkhorn, Wisconsin. 53121

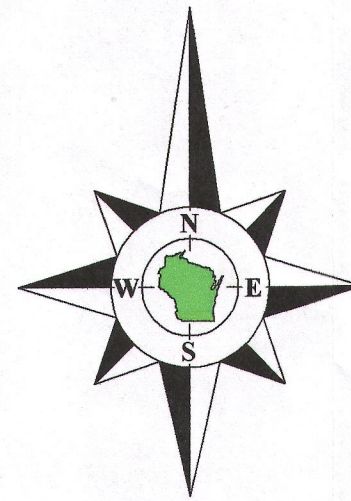

Bearings reference to the
plat of Pebble Beach.

Tax Parcel
HLG 2600002C

Lot 23
Block 1

Public Access
(60.00'+ Wide)

Pebble Beach Drive
(66' Wide)

Lauderdale

Swim
Area

Lake

Lot 27
Tax Parcel
HPE 00050
0.975 Acre
42,487 Sq.Ft.

Lot 26

Copyright 2016 by Olson Land Surveying, LLC.


All rights reserved. No part of this survey plat may be reproduced or transmitted in any form by any means - graphic, electronic, or mechanical, including photocopying, tracing, or information storage and retrieval systems - without permission in writing from Douglas G. Olson, Olson Land Surveying, LLC.

I, Douglas G. Olson, Wisconsin Professional Land Surveyor, do hereby certify that this survey was performed by me, or under my direction in full compliance with the owner's/agent's instructions and Chapter A-E 7 of the Wisconsin Administrative Code "Minimum Standards for Property Surveys"; and that this map is an accurate representation thereof to the best of my knowledge and belief.

Douglas G. Olson
Wisconsin Professional Land Surveyor - 2093

Notes:

- 1) This survey plat is not certified unless signed and sealed in red ink.
- 2) This survey is subject to Wisconsin lien laws. This Plat of Survey is the notice of intent to file lien. Lien waiver required.

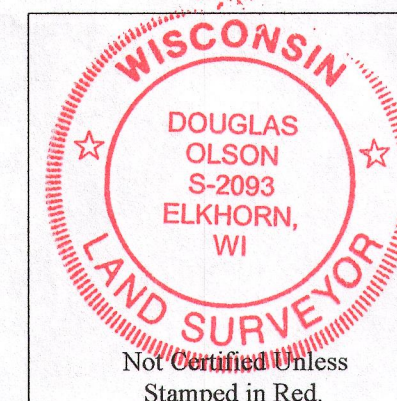

HPE-50 416-2900

Survey Date: May 12, 2016.
Revisions:

Scale in Feet
1" = 30'
0' 15' 30' 60'

Olson Land Surveying, LLC

45 South Wisconsin Street * P.O. Box 322 * Elkhorn, Wisconsin. 53121
Telephone: (262) 723-3434 * Facsimile: (262) 723-8044
Email: doug@olsonsurveying.com

Legend
Found Iron Pipe
Found Iron Rod
Set Iron Pipe 1" dia.
Set Iron Rod
Set Metal Nail
Set Lath
Recorded Information

Sheet 1 of 1 Sheets

Job Reference Number

2015.093

2015.093