


HAROLD H. KOLB

REGISTERED PROFESSIONAL LAND SURVEYOR
LAKE GENEVA, WISCONSIN

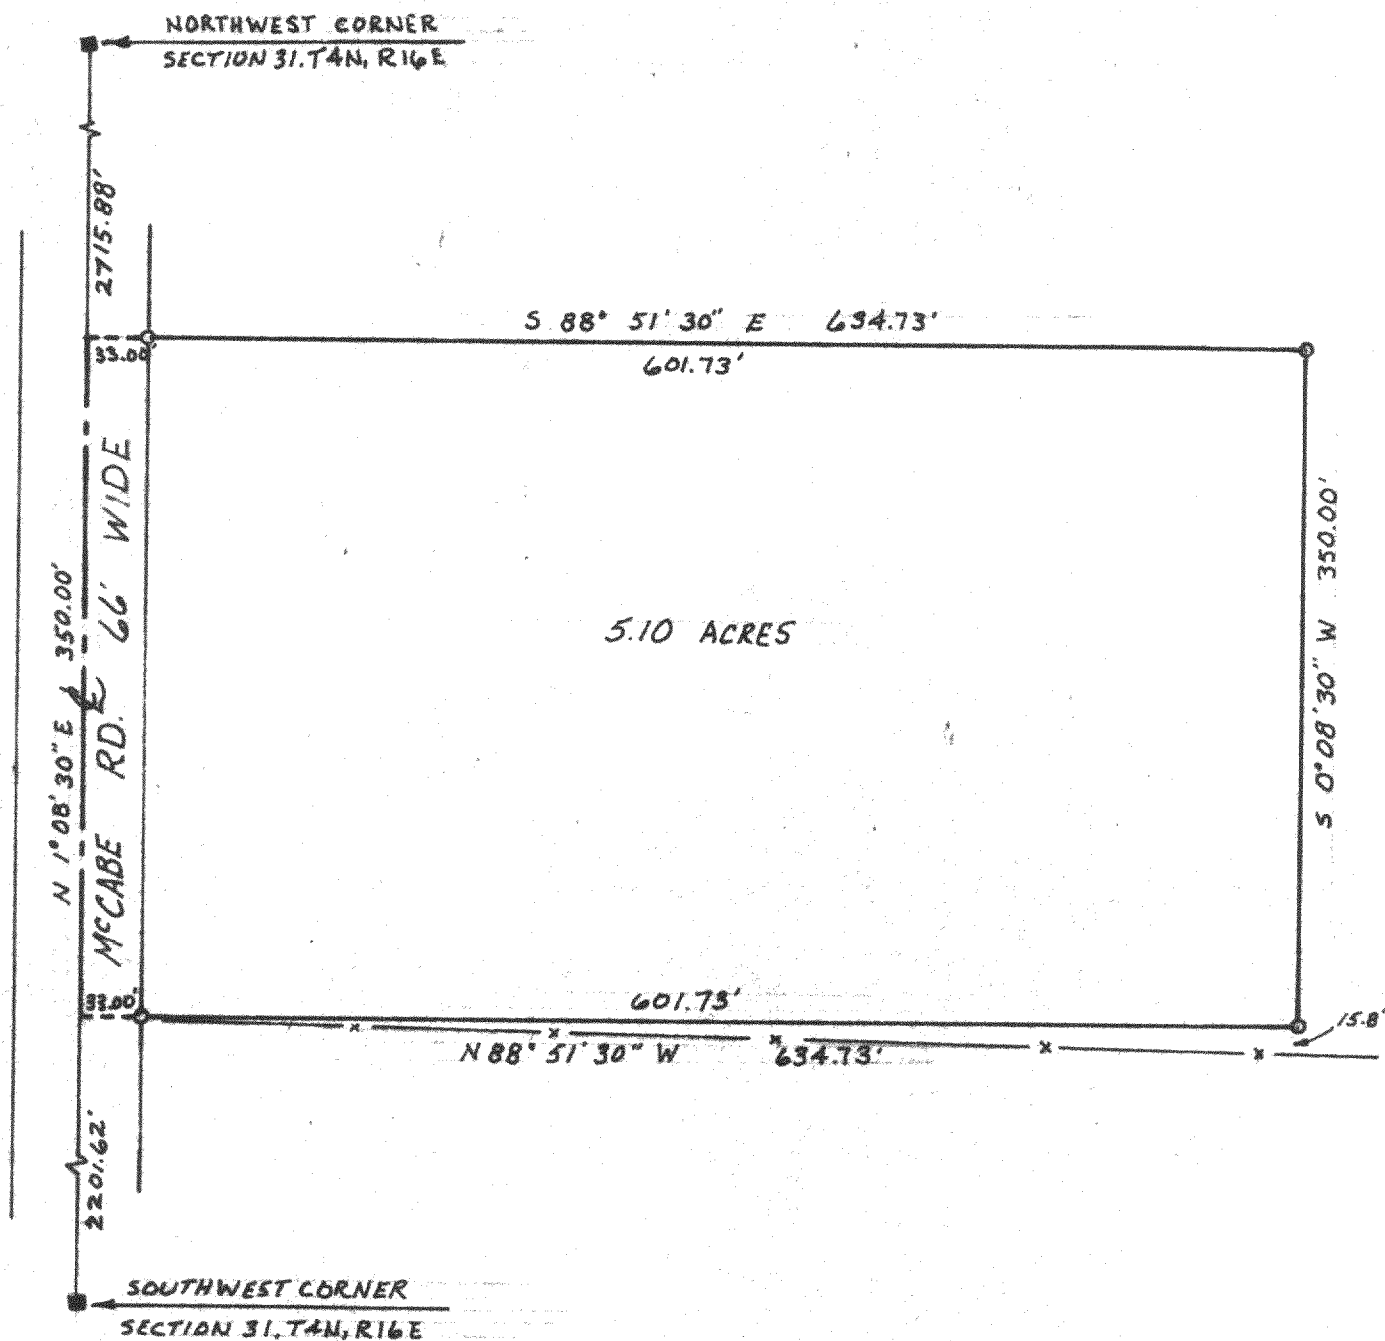


PLAT OF SURVEY OF

A parcel of land located in the Southwest $\frac{1}{4}$ of Section 31, T4N, R16E, Walworth County, Wisconsin and described as follows: Commencing at the Southwest corner of said Section 31; thence N 1°08'30" E 2201.52 feet to the place of beginning; thence continuing N 1°08'30" E 350.00 feet; thence S 88°51'30" E 634.73 feet; thence S 1°08'30" W 350.00 feet; thence N 88°51'30" W 634.73 feet to the place of beginning. Containing 5.10 acres.

Note: Bearings assumed from previous survey records.


Owner: Robert Schoenbeck
Rt. 2
Whiterwater, WI.

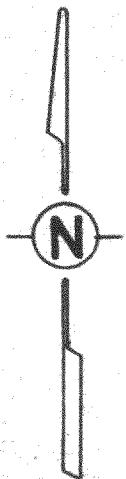

SCALE: 1" = 100'

LEGEND

- φ — IRON PIPE FOUND
- — IRON PIPE PLACED
- — CONCRETE MONUMENT 6" sq. top x 2" sq. bottom x 36"
- x — SPIKE

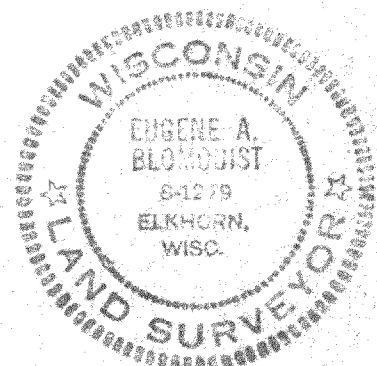

I, EUGENE A. BLOMQUIST DO HEREBY CERTIFY THAT I HAVE SURVEYED THE PROPERTY HEREON DESCRIBED ACCORDING TO THE OFFICIAL RECORDS, AND THAT THE PLAT HEREON IS A CORRECT REPRESENTATION OF THE LOT LINES.

EUGENE A. BLOMQUIST
WISCONSIN REGISTERED LAND SURVEYOR, S. 1279
DATE Aug. 3, 1979