

LAND-MARK SURVEYING

Mark L. Miritz

Wisconsin Professional Land Surveyor S-2582

N9330 Knuteson Drive
Whitewater, WI 53190
Phone: (262) 495-3284
MARKMIRITZ@
LAND-MARKSURVEYING.COM

ORDERED BY:
**KANCHANA HAMILTON
SHOREWEST REALTY
839 E. GENEVA STREET
DELAVER, WI 53115**


OWNER:
**PETER RIZZO
7358 W. BREEN ST.
NILES, IL. 60714**

PLAT OF SURVEY

LEGAL DESCRIPTION:

LOT 113, MARINER HILLS SUBDIVISION

**LOCATED IN THE NORTHWEST 1/4 OF THE SW 1/4, SECTION 34,
TOWNSHIP 4 NORTH, RANGE 16 EAST, IN THE TOWN OF LAGRANGE,
WALWORTH CO., WISCONSIN**

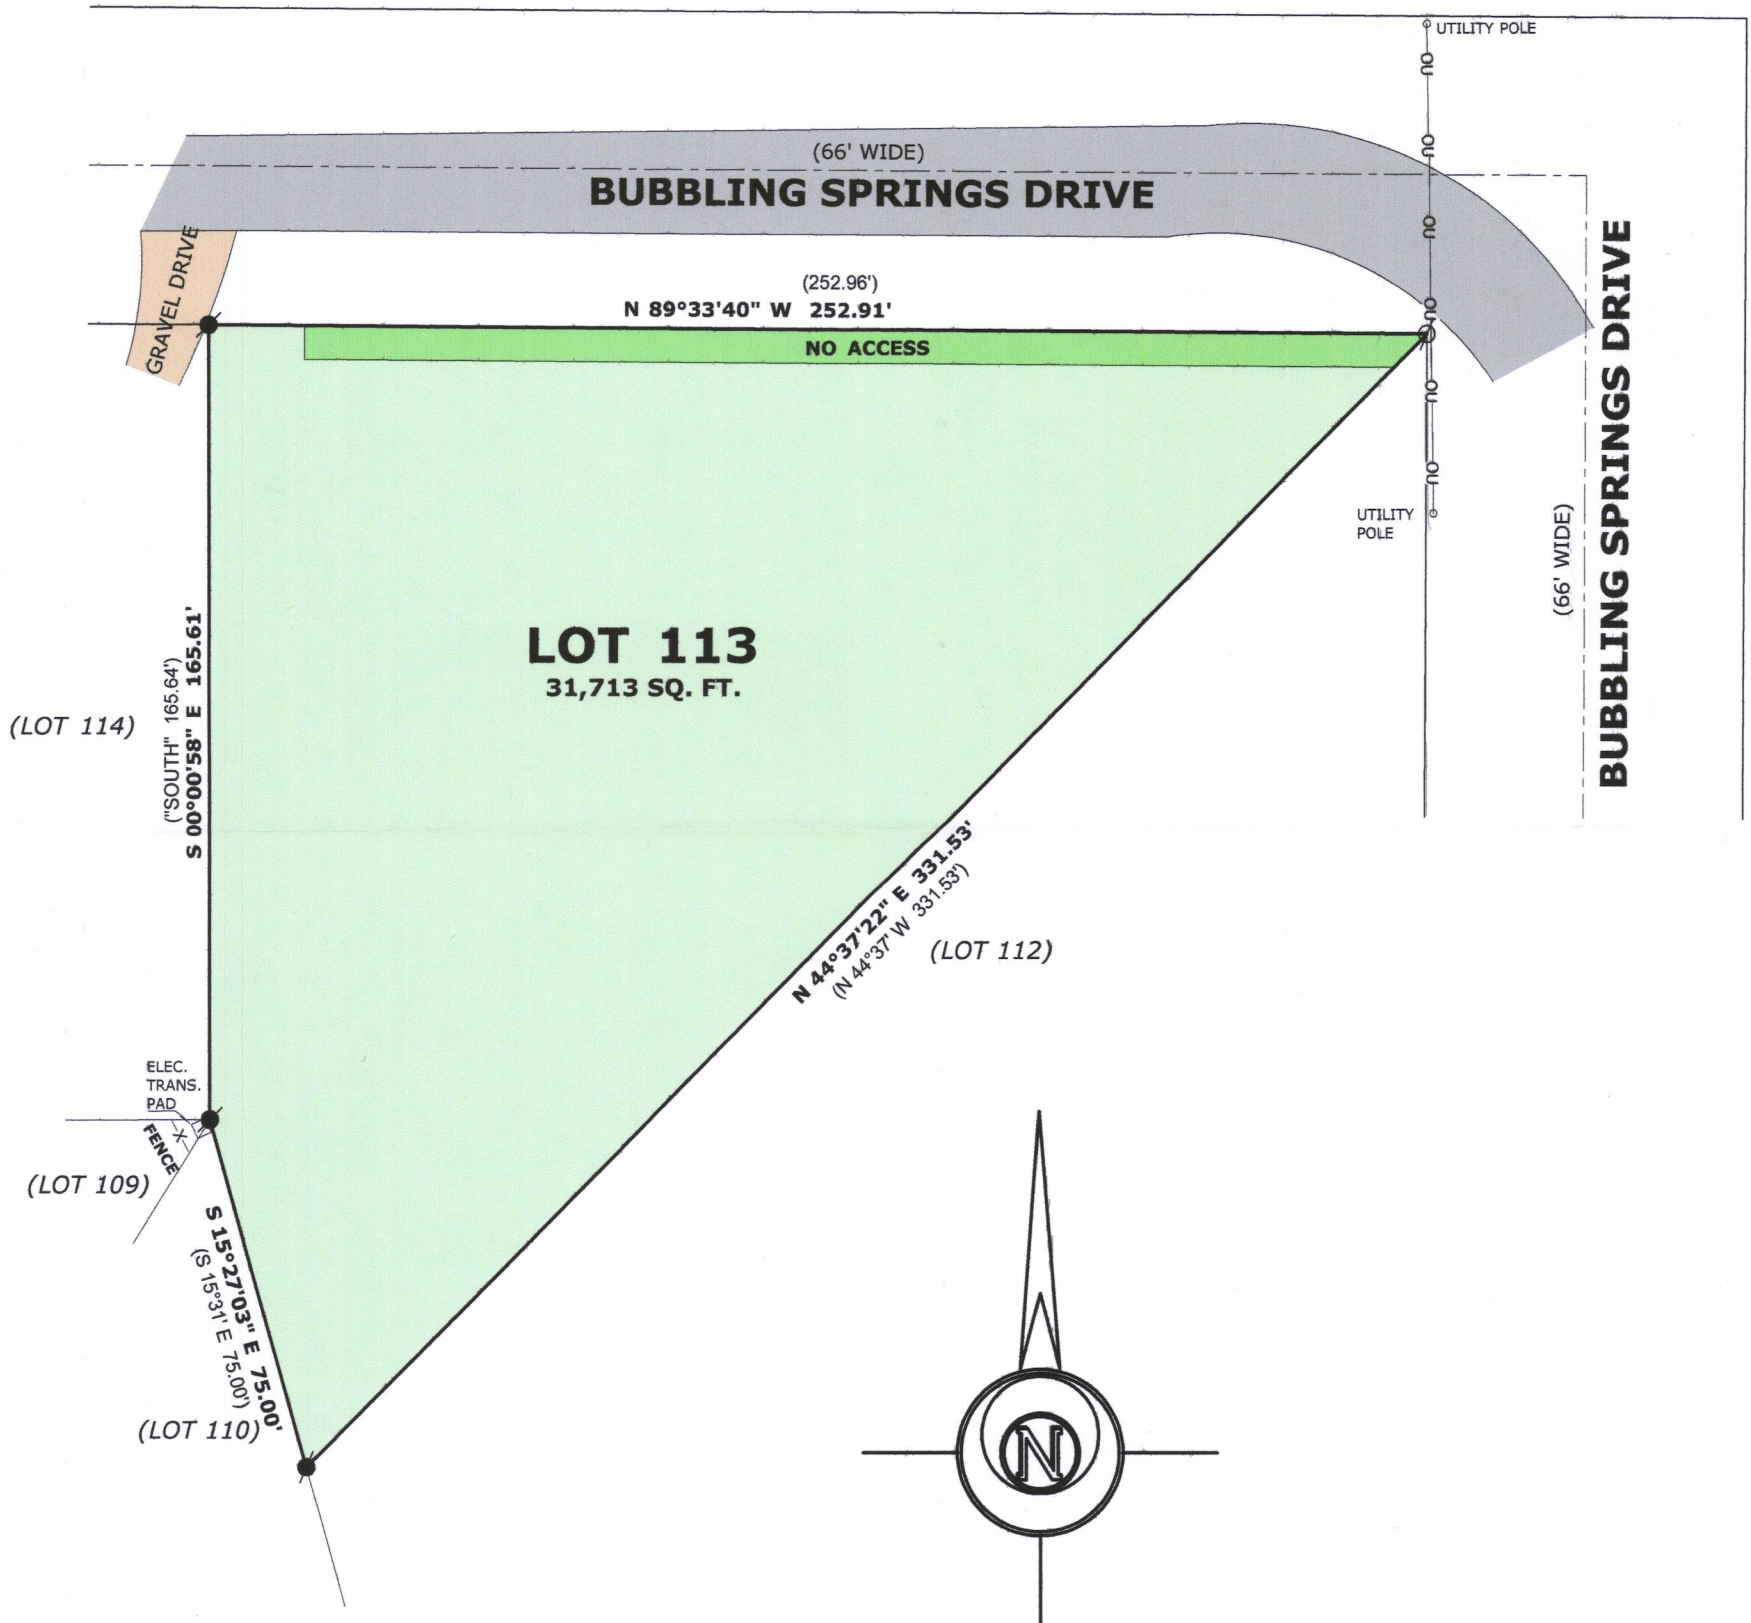

BASIS OF BEARINGS:
THE SOUTH LINE OF
BUBBLING SPRINGS DRIVE
BEING N 88°33'40" W AS PLATTED



LEGEND

- FOUND IRON PIPE 2"
- FOUND IRON ROD 3/4"
- (x x) RECORDED AS DIMENSION

SCALE: 1 INCH = 40 FEET

"I hereby certify that the above described property has been surveyed by me or under my direction and that the above map is a true representation thereof and shows the size and location of the property, its exterior boundaries, the location of all visible structures and dimensions of all principal buildings thereon, boundary fences, apparent easements, roadways and visible encroachments, if any."
"This survey is made for the use of the present owners of the property, and also those who purchase, mortgage, or guarantee the title thereto within one year from date hereof."

Mark L. Miritz
MARK L. MIRITZ
WISCONSIN PROFESSIONAL
LAND SURVEYOR S-2582
DATE: April 22, 2017 JOB NO. 17.406

HMH-113 416-2930