

PLAT OF SURVEY

OF
LAND LOCATED IN THE SOUTHWEST 1/4 OF
SECTION 26, T4N, R16E, WALWORTH COUNTY,


WISCONSIN

OWNER

R.P. MILKE

573 DOROTHY DR.

DES PLAINES, ILL 60016

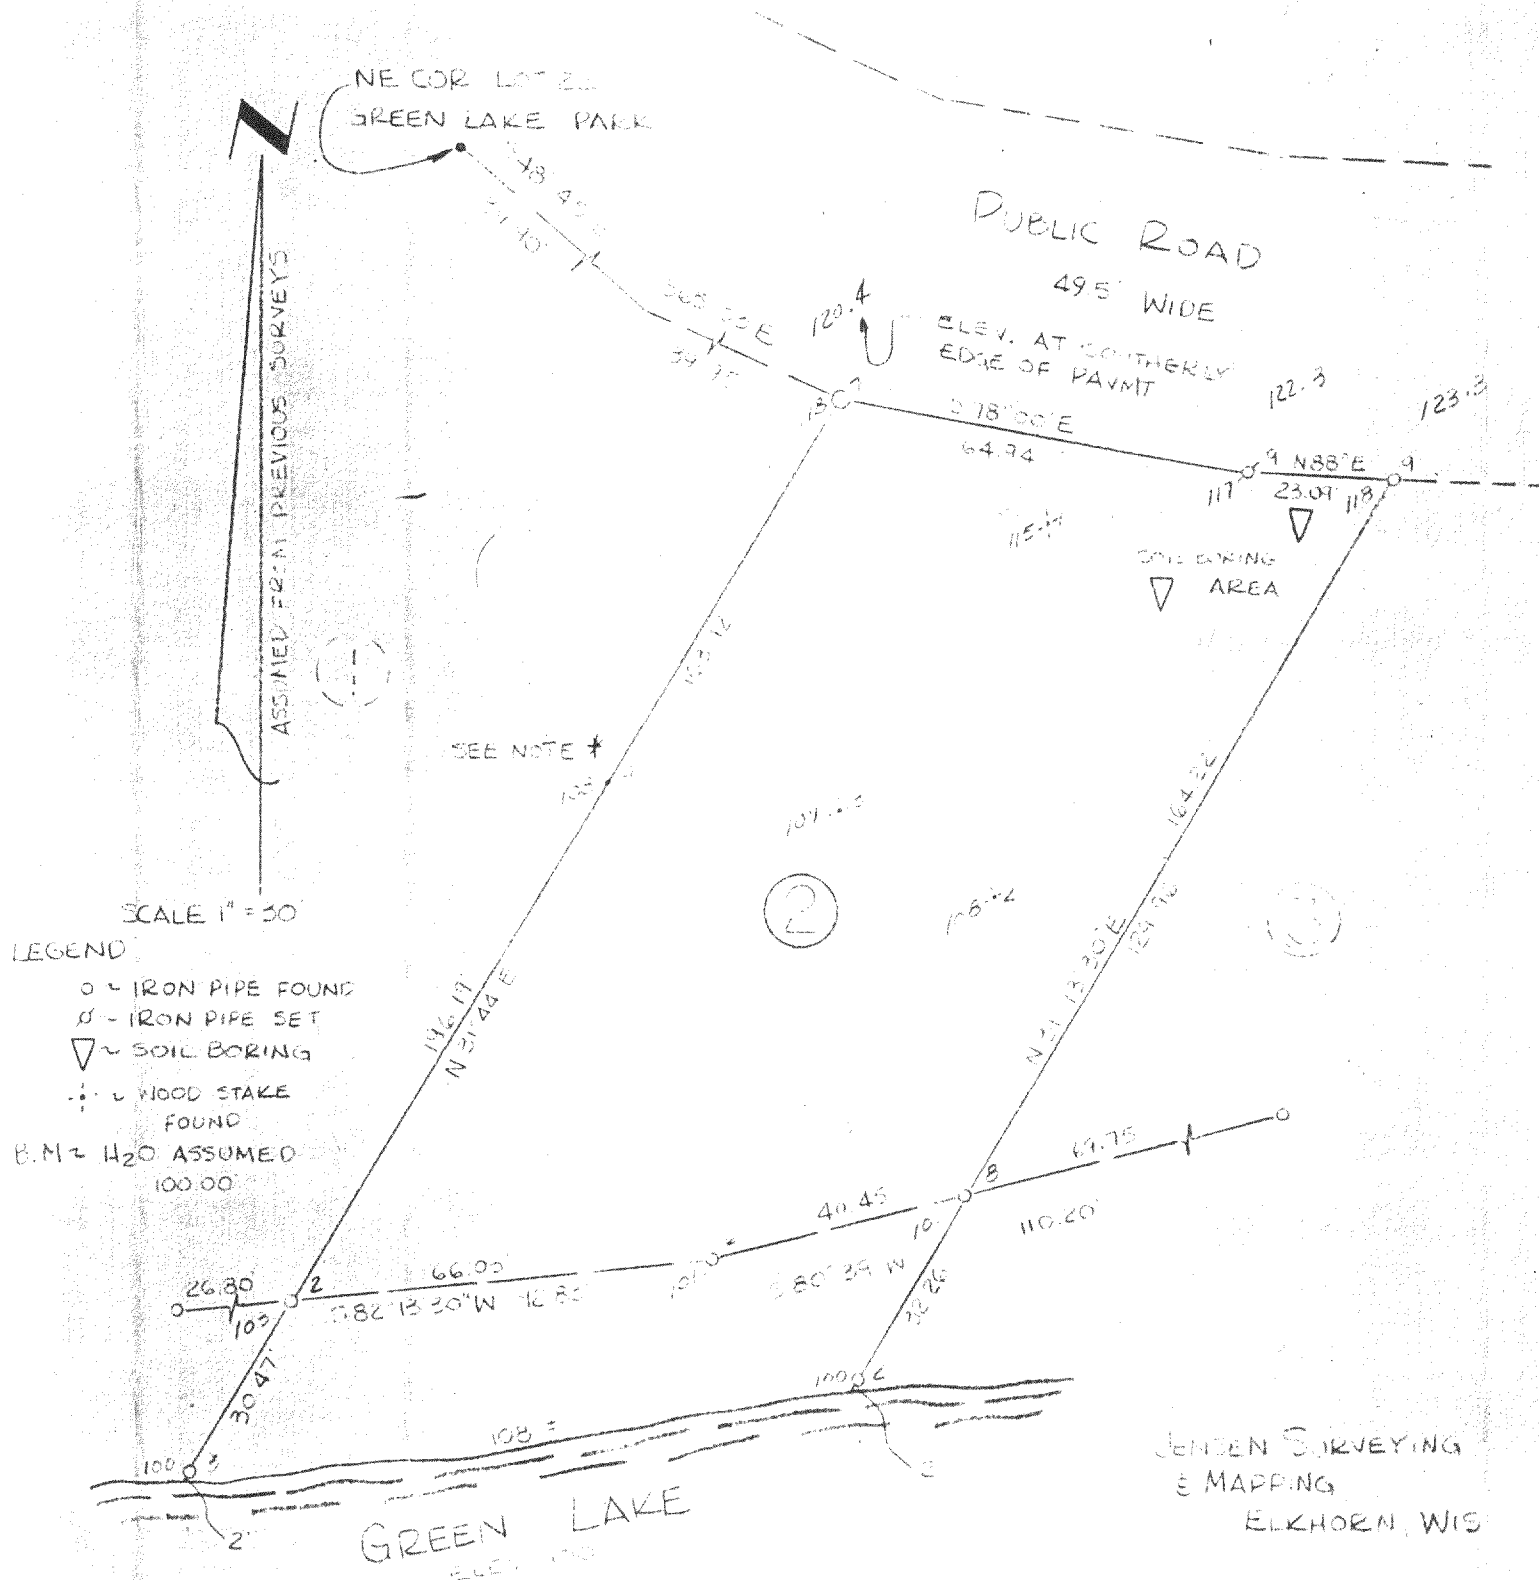

NOTE * PIPE ON WEST LINE FOUND
UNDER 200' MATERIAL
STAKED THERE

I HEREBY CERTIFY THAT THE ABOVE DESCRIBED PROPERTY
HAS BEEN SURVEYED UNDER MY DIRECTION AND THAT THE PLAT
HEREON DRAWN IS A CORRECT REPRESENTATION OF THE
SURVEY AND CORRECTLY SHOWS EXTERIOR BOUNDARIES AND
DIVISIONS OF SAID PROPERTY AND THAT LOCATIONS SHOWN ARE
CORRECT

PLAN OF SURVEY

LA-1 LOCATED IN THE SOUTHWEST 1/4 OF
SECTION 20, T4N, R16E, WALWORTH COUNTY

WIXONS IN