


Plat of Survey

of


Lot 2 in Block 3 of Cool Hill Park,

a subdivision located in the Southeast 1/4 of the Northwest 1/4 of Section 35, Town 4 North, Range 16 East, Town of LaGrange, Walworth County, Wisconsin.

Surveyed for: Ron & Kara Howard
W5678 Canary Road
Elkhorn, Wisconsin. 53121

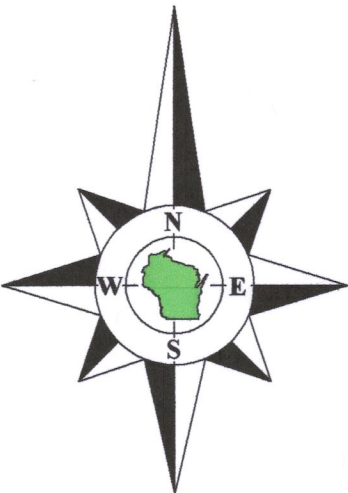

Bearings referenced to the North line of Cool Hill Drive, recorded as N88°33'E on the plat of Cool Hill Park.

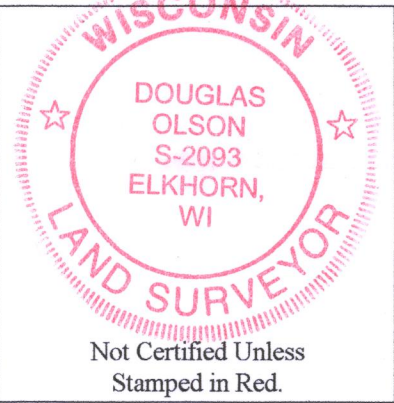

Notes:

- 1) This Plat of Survey is not certified unless signed and sealed in red ink.
- 2) This survey is subject to Wisconsin lien laws. This Plat of Survey is the notice of intent to file lien. Lien waiver required.
- 3) The Survey Date shown on this Plat of Survey is the completion date of the field work.




Copyright ©2012 by Jensen & Olson Land Surveying, LLC.

All rights reserved. No part of this survey plat may be reproduced or transmitted in any form by any means - graphic, electronic, or mechanical, including photocopying, tracing, or information storage and retrieval systems - without permission in writing from Douglas G. Olson, Jensen & Olson Land Surveying, LLC.

I hereby certify that I have surveyed the above described property and the map hereon is correct to the best of my professional knowledge and belief and shows the size and location of the property, its exterior boundaries, the location and dimensions of all visible structures thereon, boundary fences, apparent easements and roadways and visible encroachments, if any.
This survey is made for the exclusive use of the present owners of the property, and also those who purchase, mortgage or guarantee title thereto, within one year from the date hereof.

Douglas G. Olson
Wisconsin Professional Land Surveyor - 2093

Survey Date: March 28, 2017.
Revisions: No. 1 - Proposed House Staked
No. 2 - Poured Concrete Foundation

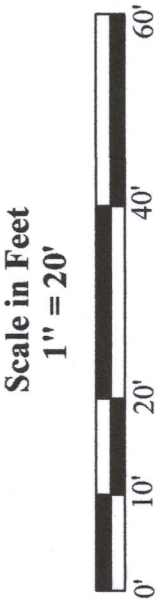

45 South Wisconsin Street | P.O. Box 322
Elkhorn, Wisconsin, 53121
Telephone: (262) 723-3434
Facsimile: (262) 723-8044
Email: doug@olsonsurveying.com
Website: www.olsonsurveying.com

OLSON
LAND SURVEYING, LLC
Rural | Residential | Commercial

Legend of Symbols & Abbreviations	
North Arrow	North
Found Iron Pipe	Found Iron Pipe
Found Iron Rod	Found Iron Rod
Set Wood Stake	Set Wood Stake
Recorded Information	Recorded Information
Utility Pole	Utility Pole
Asphalt Surface	Asphalt Surface
Gravel Surface	Gravel Surface

Sheet 1 of 1 Sheets
Drawing Name: 2017021 Howard-21 Plat
Job Reference Number
2017.021

2017.021