




PLAT OF SURVEY OF LOT 3 BLOCK 3, BAY VIEW MANOR,
LOCATED IN SECTION 36, TAN RICE, WAL. CO. WIS.

I CERTIFY THAT I HAVE SURVEYED THE ABOVE DESCRIBED
PROPERTY & THAT THE PLAT SHOWN HEREON IS AN
ACCURATE SURVEY & A TRUE REPRESENTATION THEREOF &
CORRECTLY SHOWS THE BOUNDARY LINE OF SAID PROPERTY.

OCT. 1, 1979

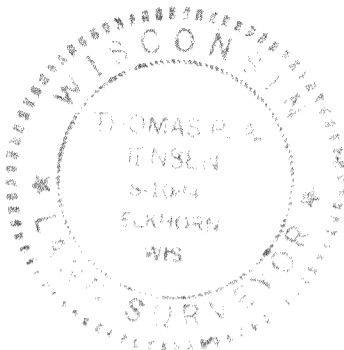

Thomas P. A. Jensen
JENSEN SURVEYING & MAPPING
ELKHORN, WISCONSIN

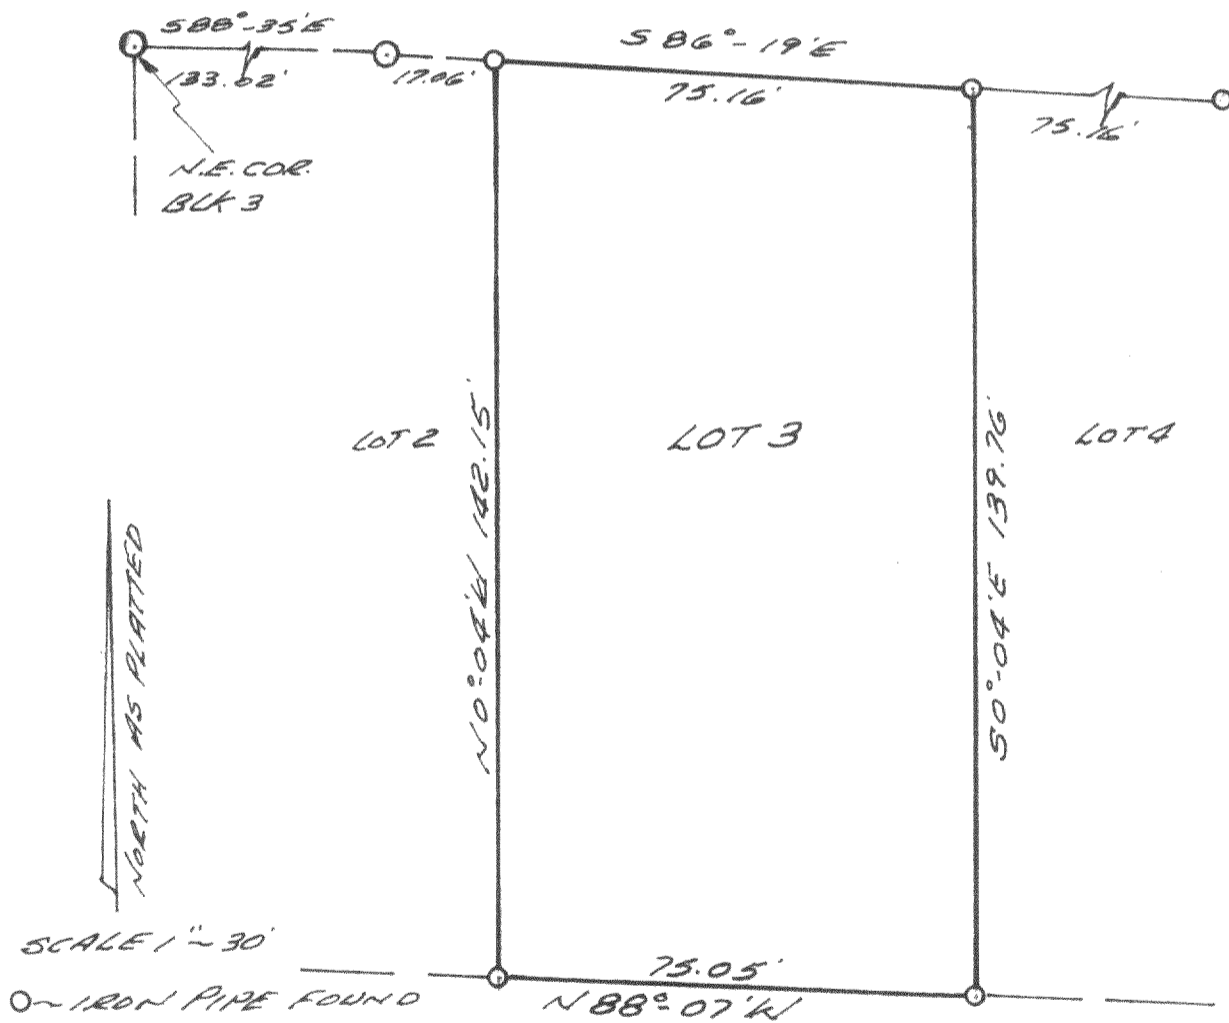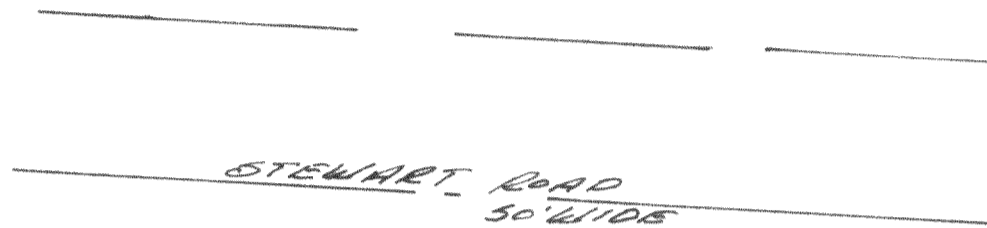

SURVEYED FOR:
MR. KEN HART
707 SO. STEWART
LOMBARD, ILL.
60148