

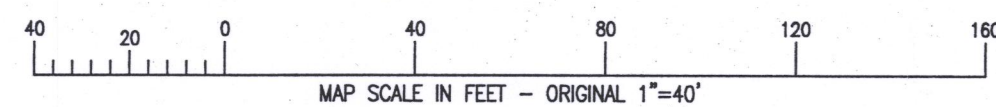
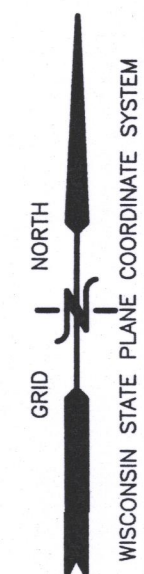


DEC 06 2017

X:\PROJECTS\7451\7451_17\ACAD\7451_17.dwg

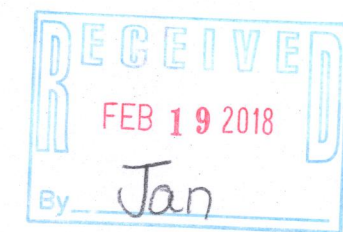

- LEGEND
- = FOUND IRON PIPE STAKE
 - = WELL LOCATED
 - ▲ = SEPTIC LID LOCATED
 - ▲ = SEPTIC VENT LOCATED
 - = SEPTIC PLUG LOCATED
 - = TRANSFORMER LOCATED
 - = TELEPHONE BOX LOCATED
 - {xxx} = RECORDED AS

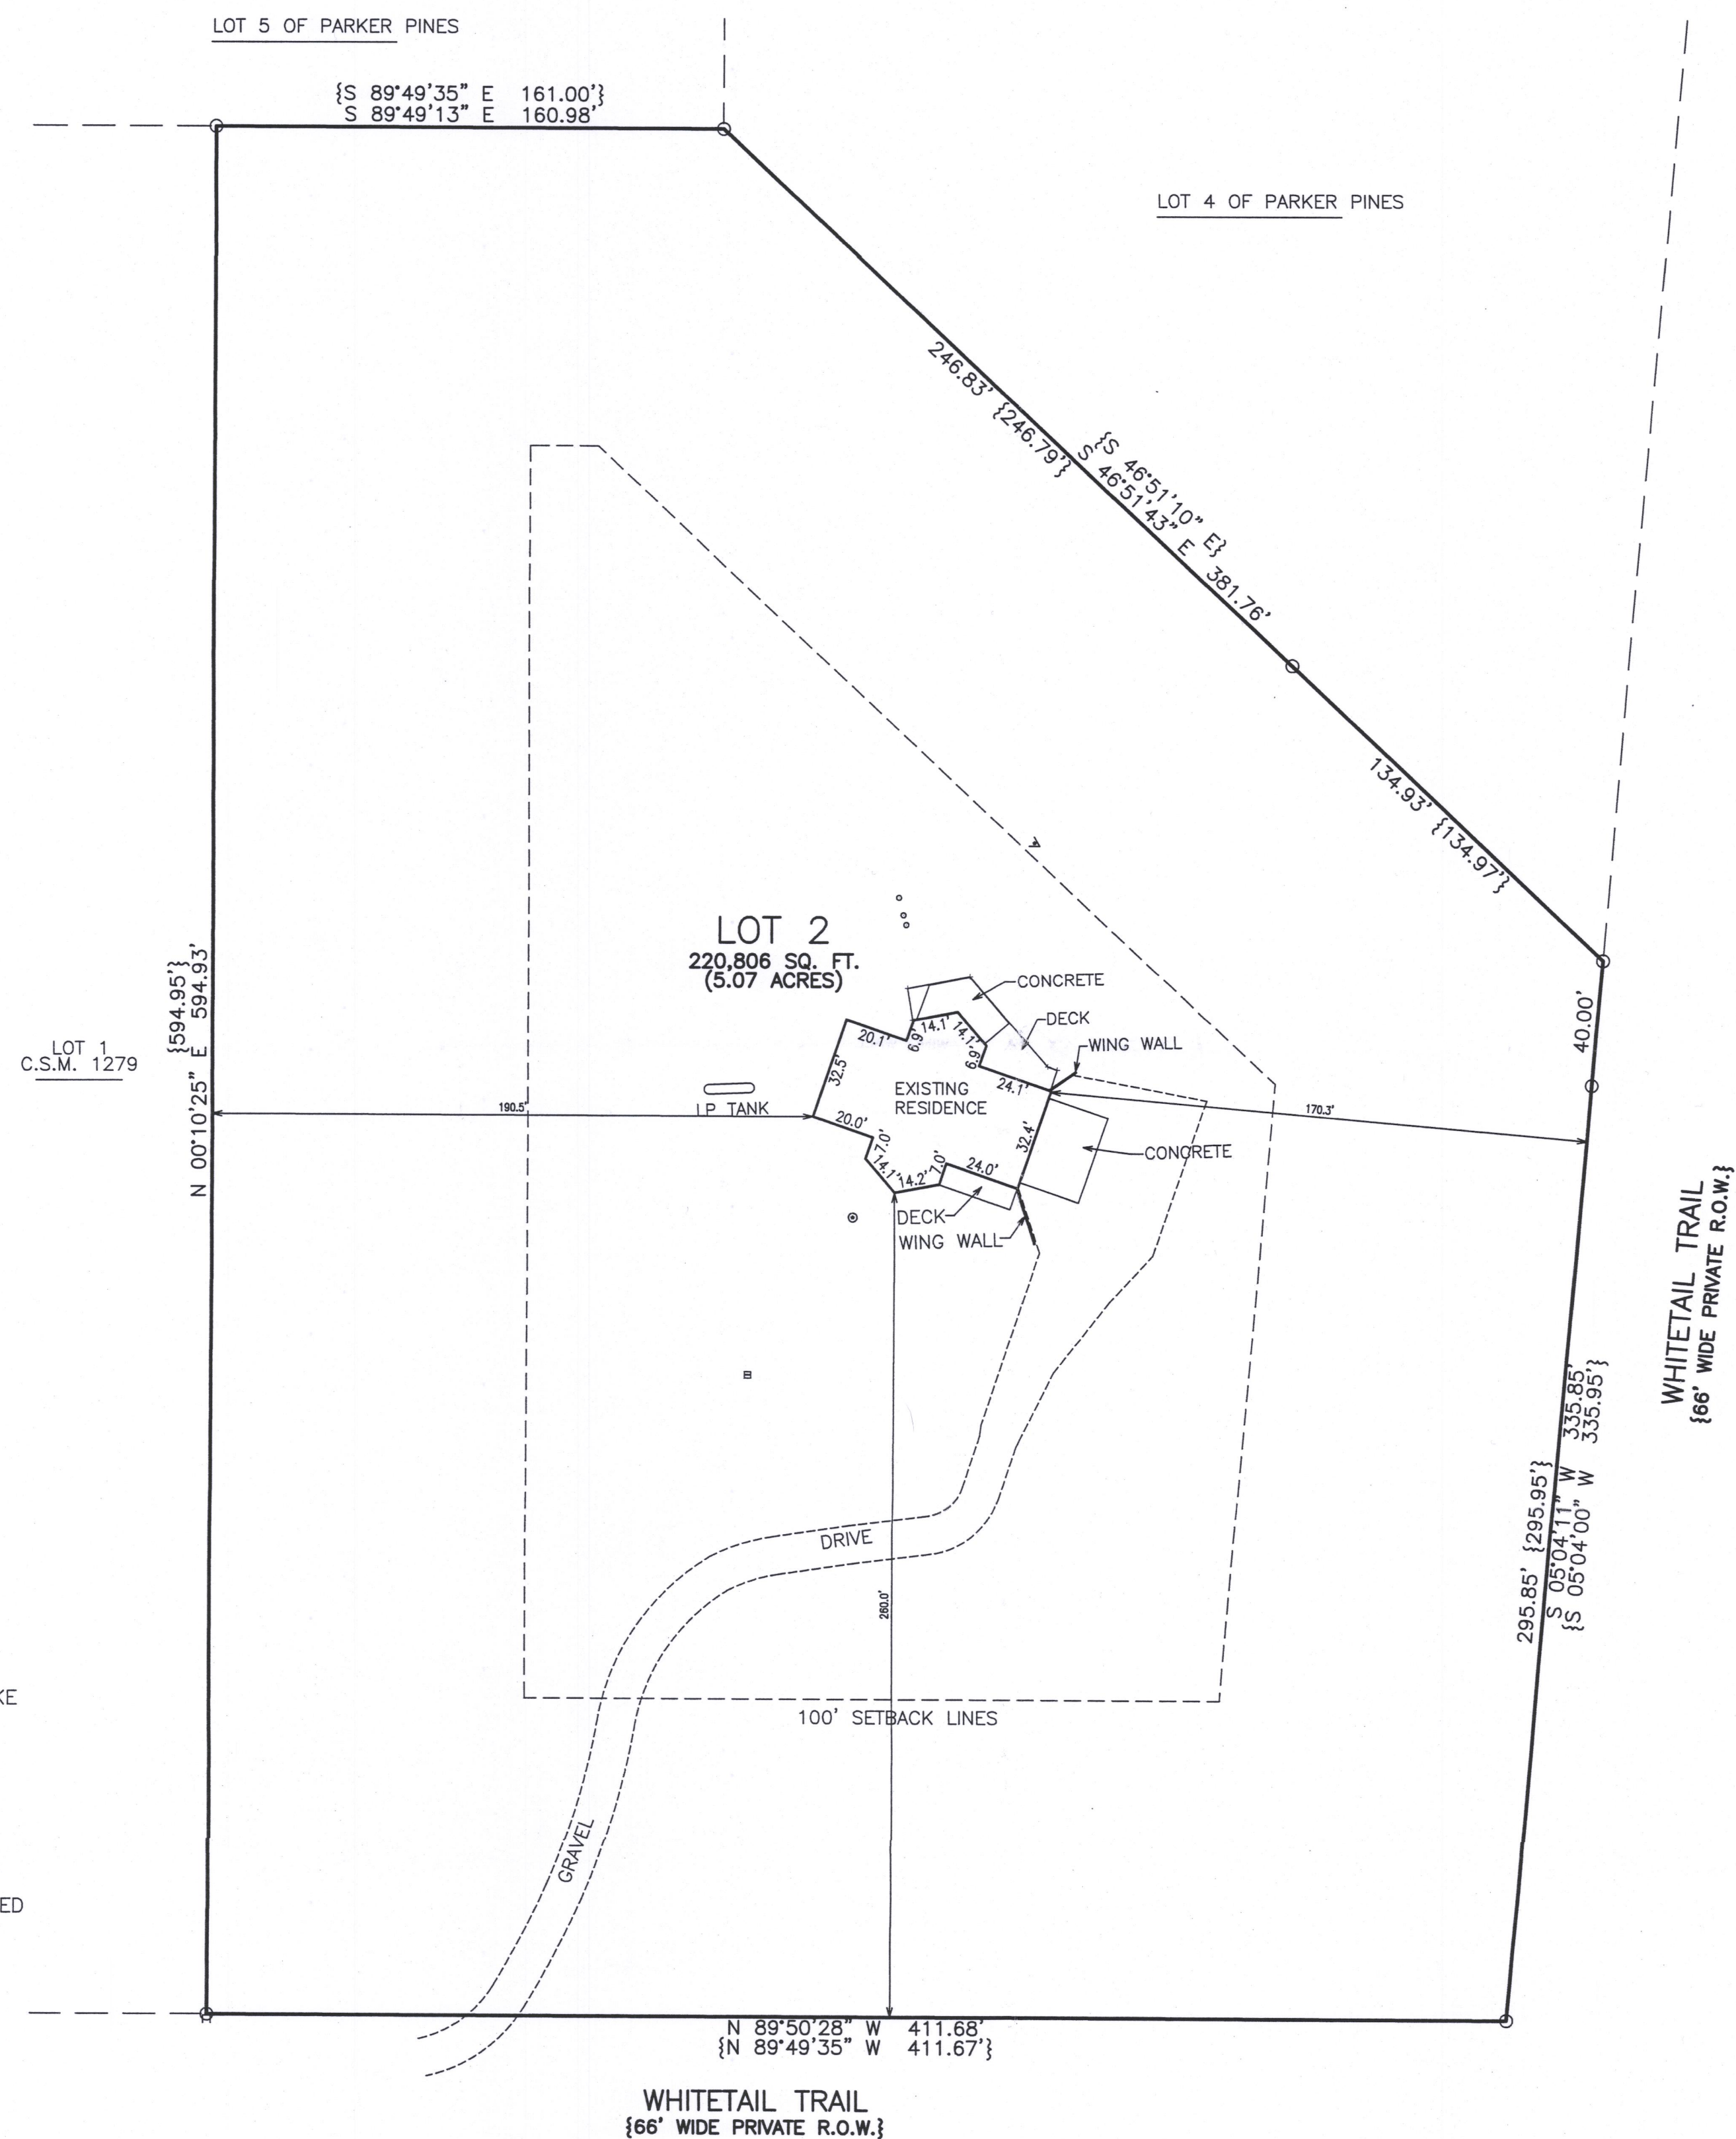


NOTE: COPIES OF THIS MAP TO WHICH THE FOLLOWING CERTIFICATE WILL APPLY SHOW THE SURVEYOR'S ORIGINAL SEAL AND SIGNATURE IN RED INK. COPIES BY ANY OTHER MEANS MAY HAVE ALTERATIONS WHICH DO NOT REPRESENT THE SURVEYOR'S WORK PRODUCT.

I HEREBY CERTIFY THAT THE ABOVE DESCRIBED PROPERTY HAS BEEN SURVEYED UNDER MY DIRECTION AND THAT THE ABOVE MAP IS A TRUE REPRESENTATION THEREOF AND SHOWS THE SIZE AND LOCATION OF THE PROPERTY AND ITS EXTERIOR BOUNDARIES. THIS SURVEY IS MADE FOR THE USE OF THE PRESENT OWNERS OF THE PROPERTY, AND ALSO THOSE WHO PURCHASE, MORTGAGE, OR GUARANTEE THE TITLE THERETO WITHIN ONE YEAR FROM THE DATE HEREOF.



DATED: 12-05-2017

Brian M. Carlson
BRIAN M. CARLSON P.L.S. 2039

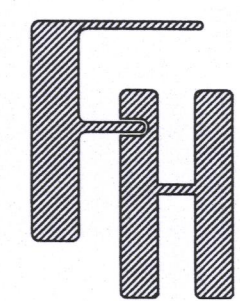

PLAT OF SURVEY
TOWN OF LA GRANGE, WALWORTH COUNTY,
WISCONSIN

WORK ORDERED BY -
CHARLES VANDERBOSCH
W5520 WHITETAIL TRAIL
WHITEWATER, WISCONSIN 53190

FARRIS, HANSEN & ASSOCIATES, INC.
ENGINEERING - ARCHITECTURE - SURVEYING
7 RIDGWAY COURT P.O. BOX 437
ELKHORN, WISCONSIN 53121
OFFICE: (262) 723-2098 FAX: (262) 723-5886

REVISIONS

PROJECT NO.
7451.17
DATE
12-05-2017
SHEET NO.
1 OF 1

HA1279-2 416-2974