


-OF-

SURVEY FOR: AMARJIT SIDHU

LEGEND

- NOTE: ALTHOUGH THE FOUND IRON PIPE AS DEPICTED
HEREON VARY IN DIAMETERS, THIS OFFICE BELIEVES
THEY ARE MOST LIKELY THE ORIGINAL SUBDIVISION
MONUMENTS AND WERE HELD AS THE BEST EVIDENCE
OF THE PROPERTY LINES.

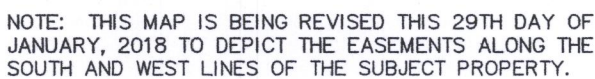

"I HEREBY CERTIFY THAT I HAVE SURVEYED THE ABOVE DESCRIBED PROPERTY AND THAT THE ABOVE MAP IS A CORRECT REPRESENTATION THEREOF AND SHOWS THE SIZE AND LOCATION OF THE PROPERTY, ITS EXTERIOR BOUNDARIES, THE LOCATION OF ALL VISIBLE STRUCTURES AND DIMENSIONS OF ALL PRINCIPAL BUILDINGS THEREON, BOUNDARY FENCES, APPARENT EASEMENTS, ROADWAYS AND ENCROACHMENTS, IF ANY."

"THIS SURVEY IS MADE FOR THE USE OF THE PRESENT OWNERS OF THE PROPERTY, AND THOSE WHO PURCHASE, MORTGAGE, OR GUARANTEE THE TITLE THERETO WITHIN ONE YEAR FROM DATE HEREOF."

A circular professional seal for a Wisconsin Land Surveyor. The outer ring contains the text "WISCONSIN" at the top and "LAND SURVEYOR" at the bottom, separated by two five-pointed stars. The inner circle contains the text "THOMAS L. SATTER", "S-2850", and "BURLINGTON, WI" arranged vertically.

THIS IS NOT AN ORIGINAL PRINT
UNLESS THIS SEAL IS RED.

Thomas L. Satter

REVISED: 1/29/18
JANUARY 18, 2018
DATE

011802
JOB NUMBER

HCO-16B 416-2983