


Plat of Survey

of

Lot 5 in Block 8 of Cool Hill Park Addition No. 1,

a subdivision located in the Northwest 1/4 of the Southwest 1/4 of Section 35, Town 4 North, Range 16 East, Town of LaGrange, Walworth County, Wisconsin.

Surveyed for: **Dan Machaj**
W5625 Cool Hill Drive
Elkhorn, Wisconsin. 53121

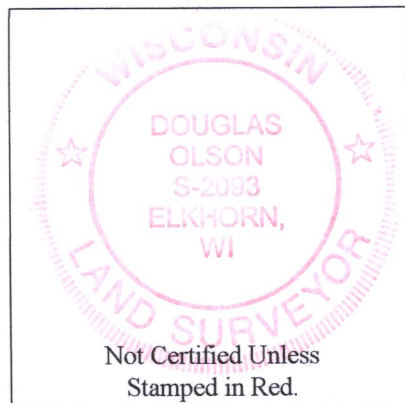

Notes:

- 1) This Plat of Survey is not certified unless signed and sealed in red ink.
- 2) This survey is subject to Wisconsin lien laws. This Plat of Survey is the notice of intent to file lien. Lien waiver required.
- 3) The Survey Date shown on this Plat of Survey is the completion date of the field work.



Copyright ©2018 by Olson Land Surveying, LLC.

All rights reserved. No part of this survey plat may be reproduced or transmitted in any form by any means - graphic, electronic, or mechanical, including photocopying, tracing, or information storage and retrieval systems - without permission in writing from Douglas G. Olson, Olson Land Surveying, LLC.

I hereby certify that I have surveyed the above described property in compliance with Chapter A-E 7 of the Wisconsin Administrative Code and that the map hereon is correct to the best of my professional knowledge and belief and shows the size and location of the property, its exterior boundaries, the location and dimensions of all visible structures thereon, boundary fences, apparent easements and roadways and visible encroachments, if any.

This survey is made for the exclusive use of the present owners of the property, and also those who purchase, mortgage or guarantee title thereto, within one year from the date hereof.

Douglas G. Olson
Wisconsin Professional Land Surveyor - 2093

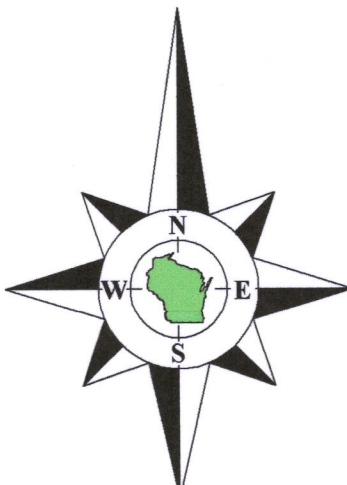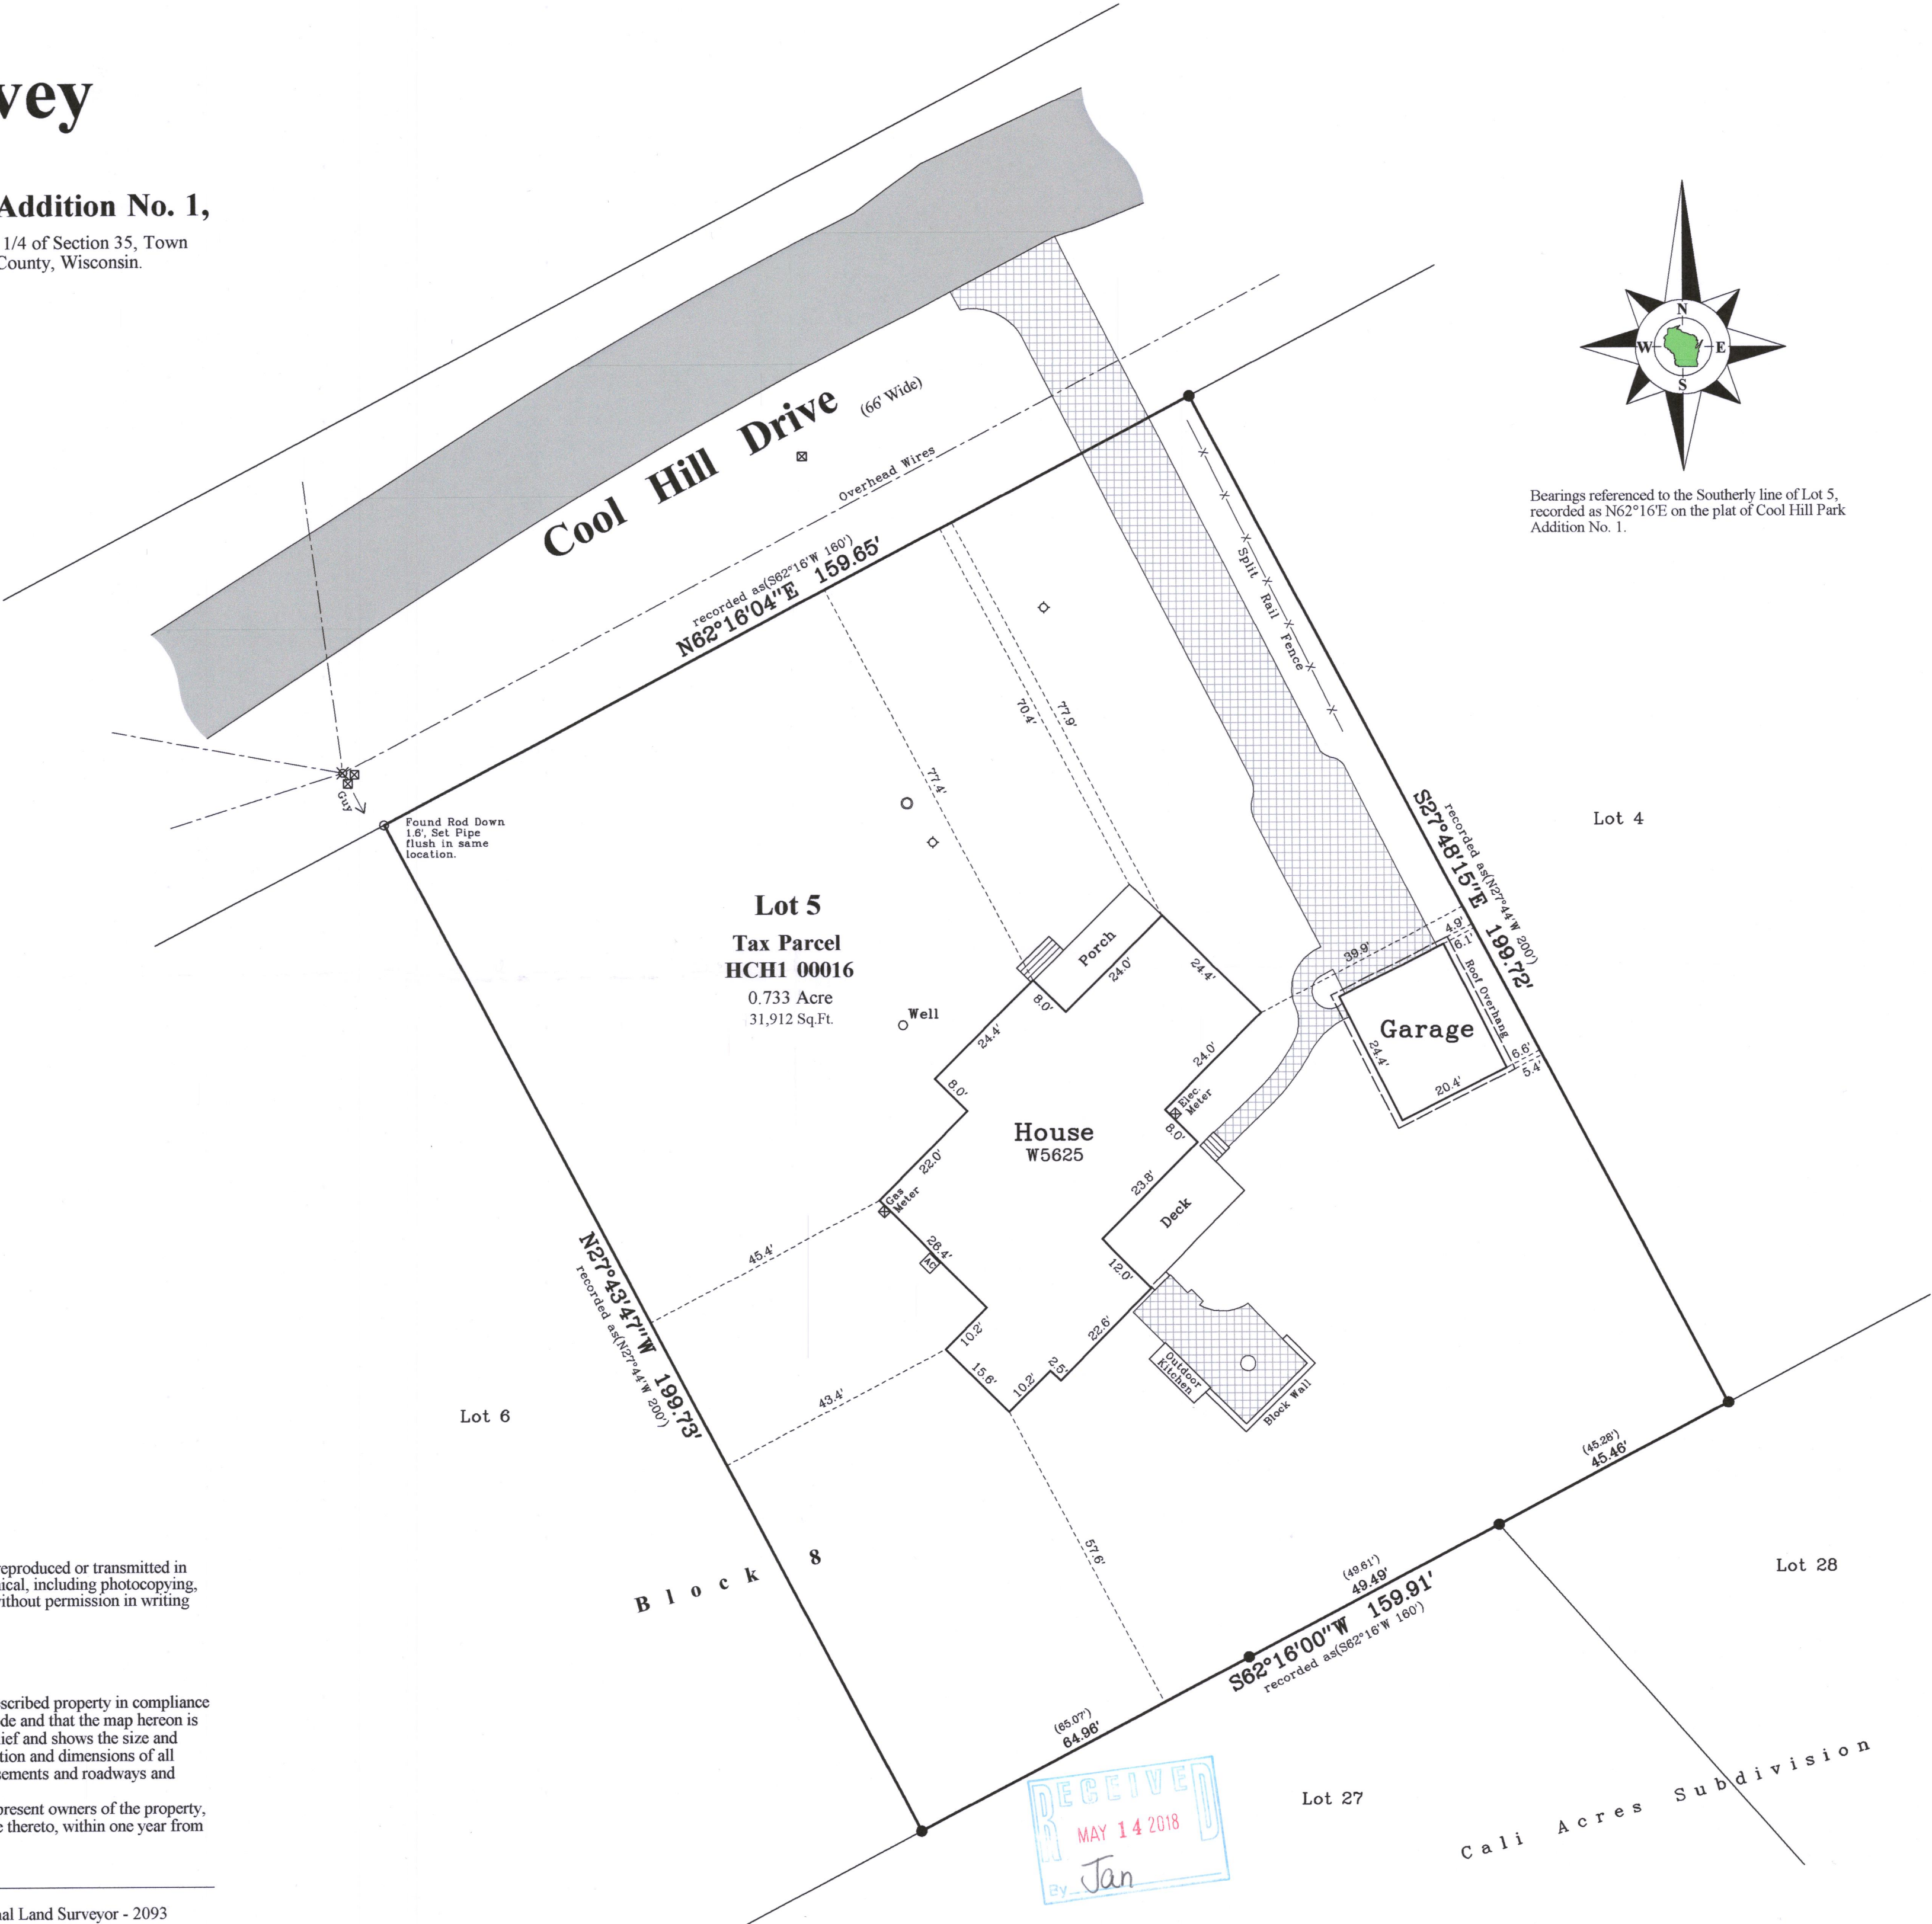

Bearings referenced to the Southerly line of Lot 5, recorded as N62°16'E on the plat of Cool Hill Park Addition No. 1.


Survey Date: February 27, 2018.

Revisions:

Scale in Feet
1" = 20'



45 South Wisconsin Street | P.O. Box 322
Elkhorn, Wisconsin. 53121
Telephone: (262) 723-3434
Facsimile: (262) 723-8044
Email: doug@olsonsurveying.com
Website: www.olsonsurveying.com

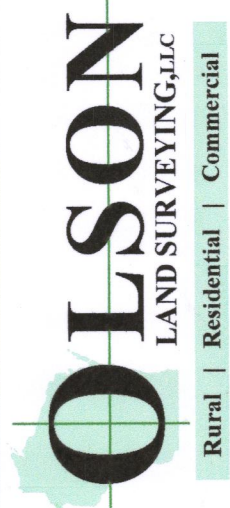

Legend of Symbols & Abbreviations	
North Arrow	North
South Arrow	South
West Arrow	West
East Arrow	East
Found Iron Pipe	Found Iron Pipe
Set Iron Pipe, 1" dia.	Set Iron Pipe, 1" dia.
Recorded Information	Recorded Information
Utility Pole	Utility Pole
Concrete Cover	Concrete Cover
Septic Vent	Septic Vent
Asphalt Surface	Asphalt Surface
Brick Pavers	Brick Pavers

Sheet 1 of 1 Sheets	Drawing Name:
Job Reference Number	2018.010
2018.010	

HCH1-16 416-3003