


# SURVEY WITH HOUSE LOCATION OF LOT 14 OF ARROWHEAD PARK ADDITION NUMBER 1

LOCATED IN SECTION 35, T4N, R16E, WALWORTH COUNTY, WISCONSIN

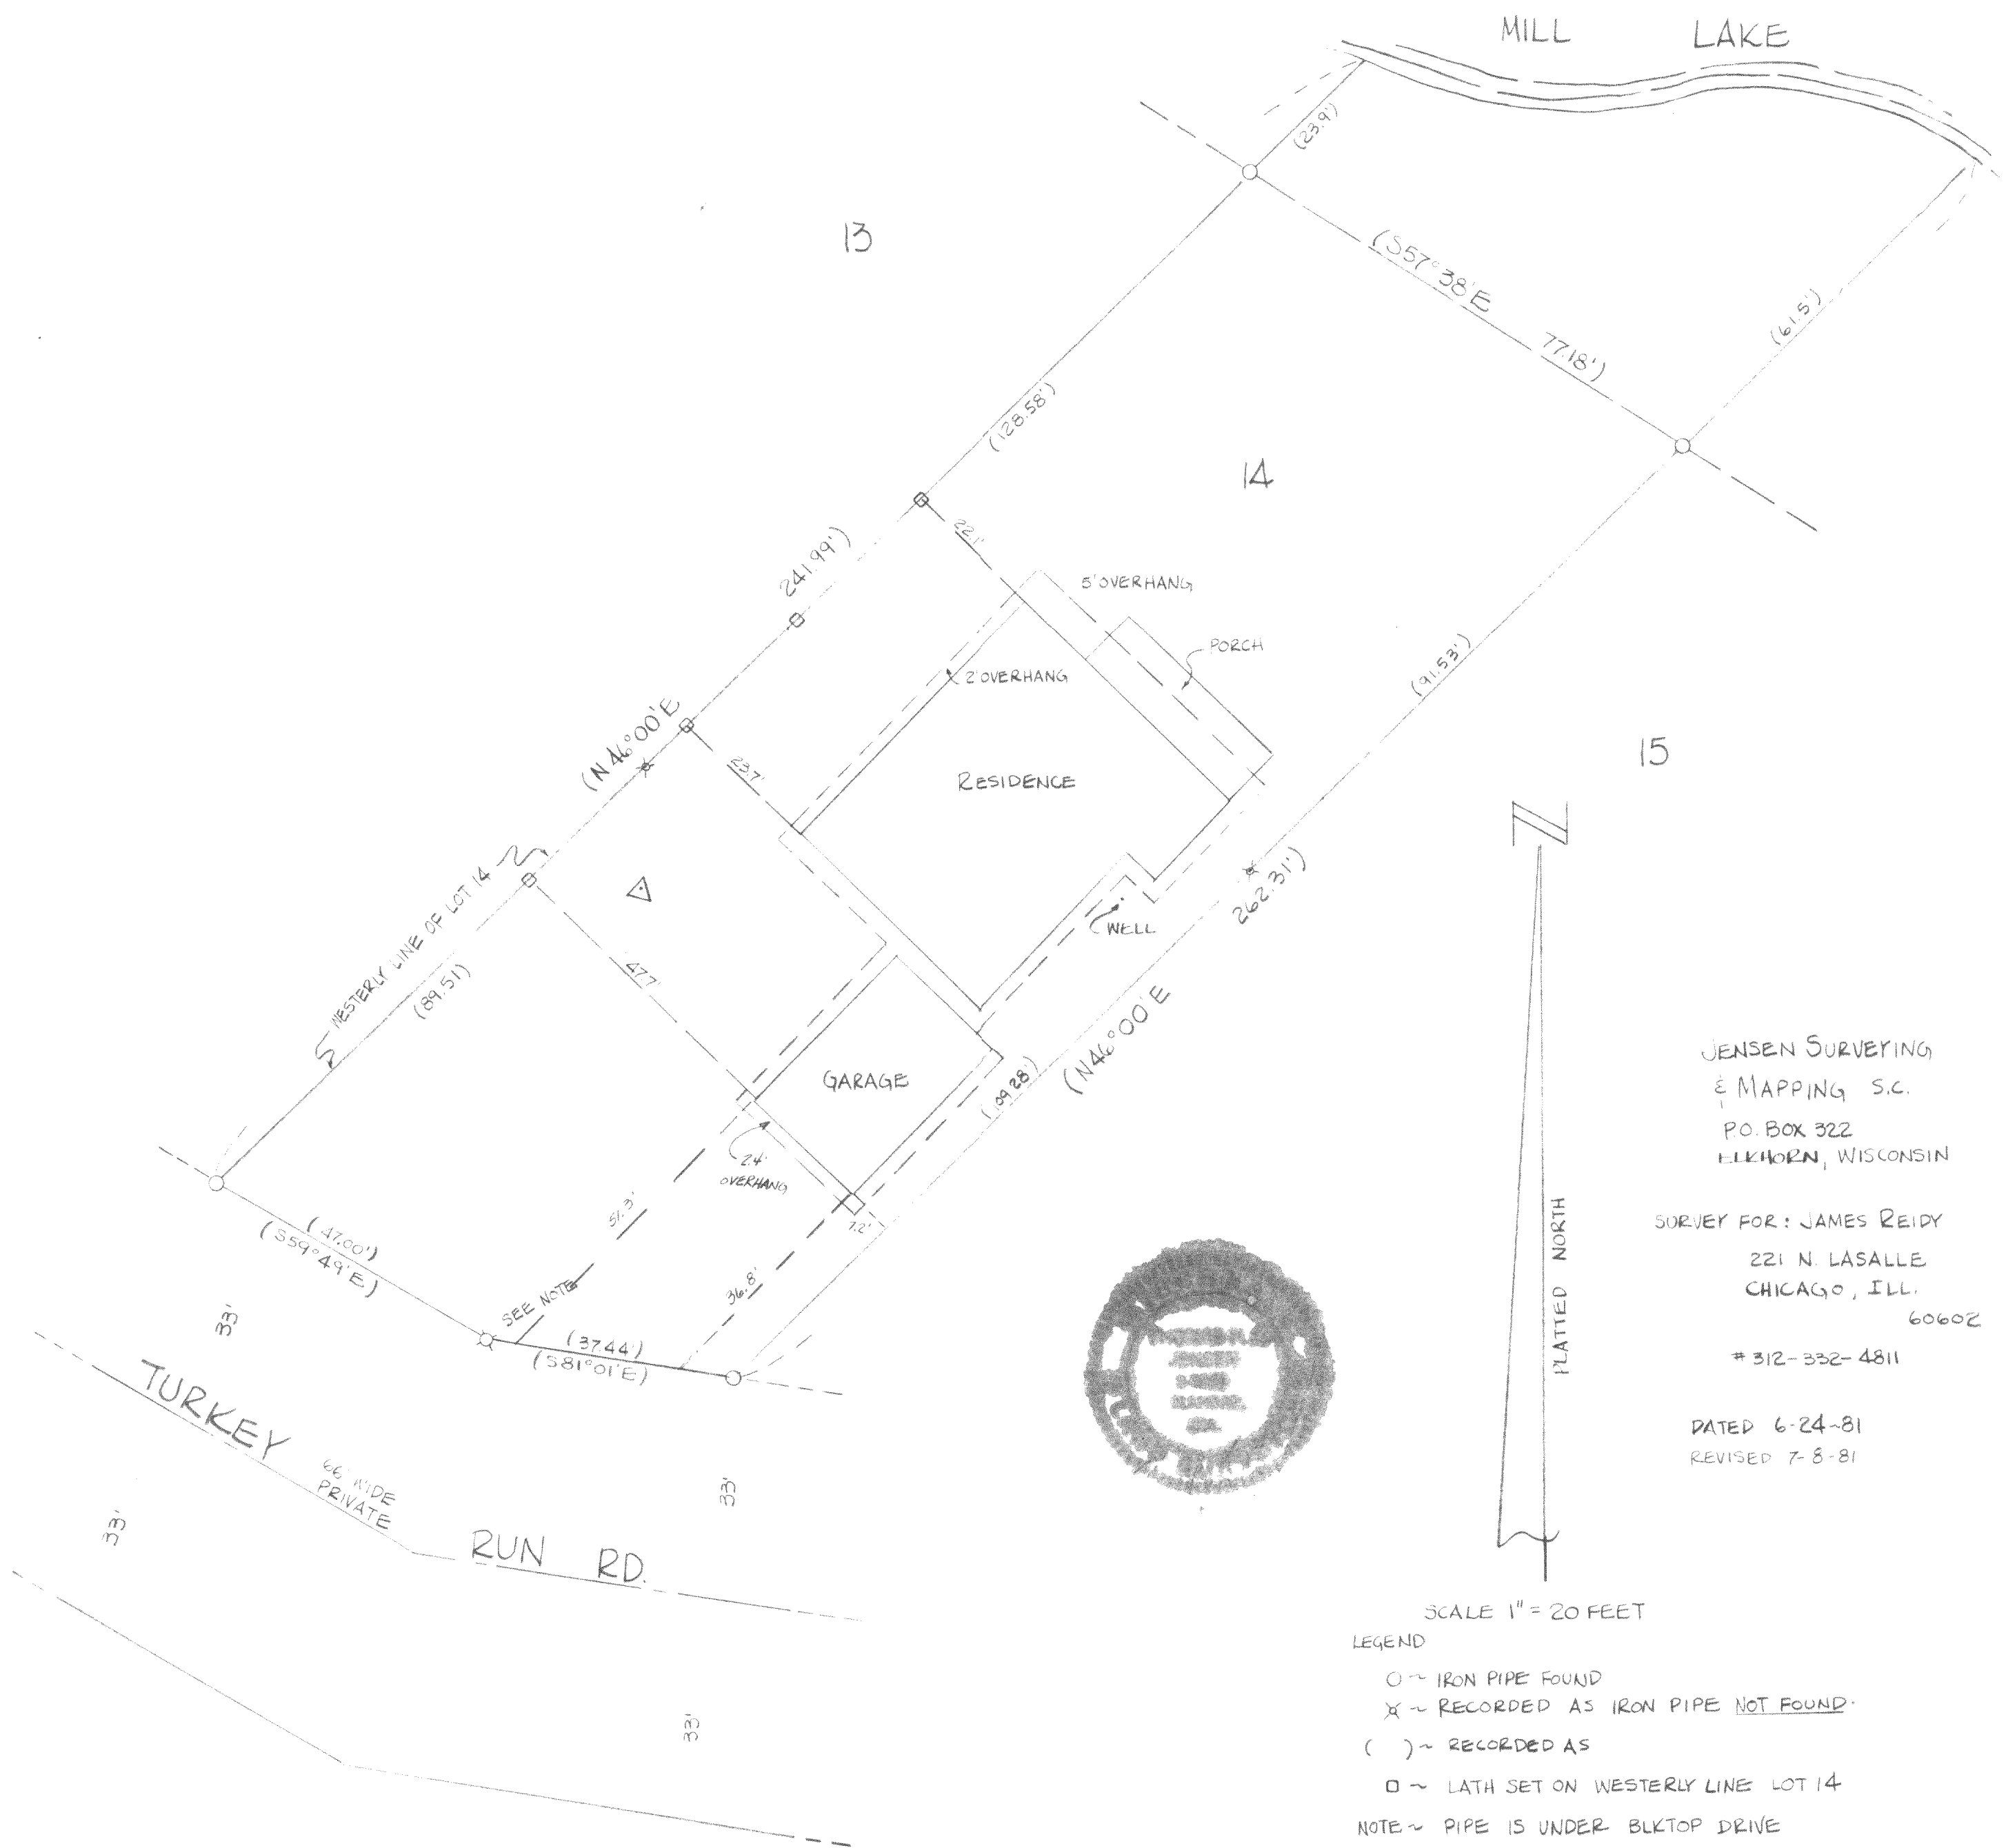

JENSEN SURVEYING  
& MAPPING S.C.  
P.O. BOX 322  
ELKHORN, WISCONSIN

SURVEY FOR: JAMES REIDY  
221 N. LASALLE  
CHICAGO, ILL.  
60602

# 312-332-4811

DATED 6-24-81  
REVISED 7-8-81

SCALE 1" = 20 FEET  
LEGEND  
O ~ IRON PIPE FOUND  
x ~ RECORDED AS IRON PIPE NOT FOUND  
( ) ~ RECORDED AS  
□ ~ LATH SET ON WESTERLY LINE LOT 14  
NOTE ~ PIPE IS UNDER BLKTOP DRIVE  
△ ~ SEPTIC VENT STACK