


KOLB LAND CONSULTING, INC.
LAND SURVEYING • SUBDIVIDING • LAND PLANNING

LAKE GENEVA, WISCONSIN 53147

WHITEWATER, WISCONSIN 53190

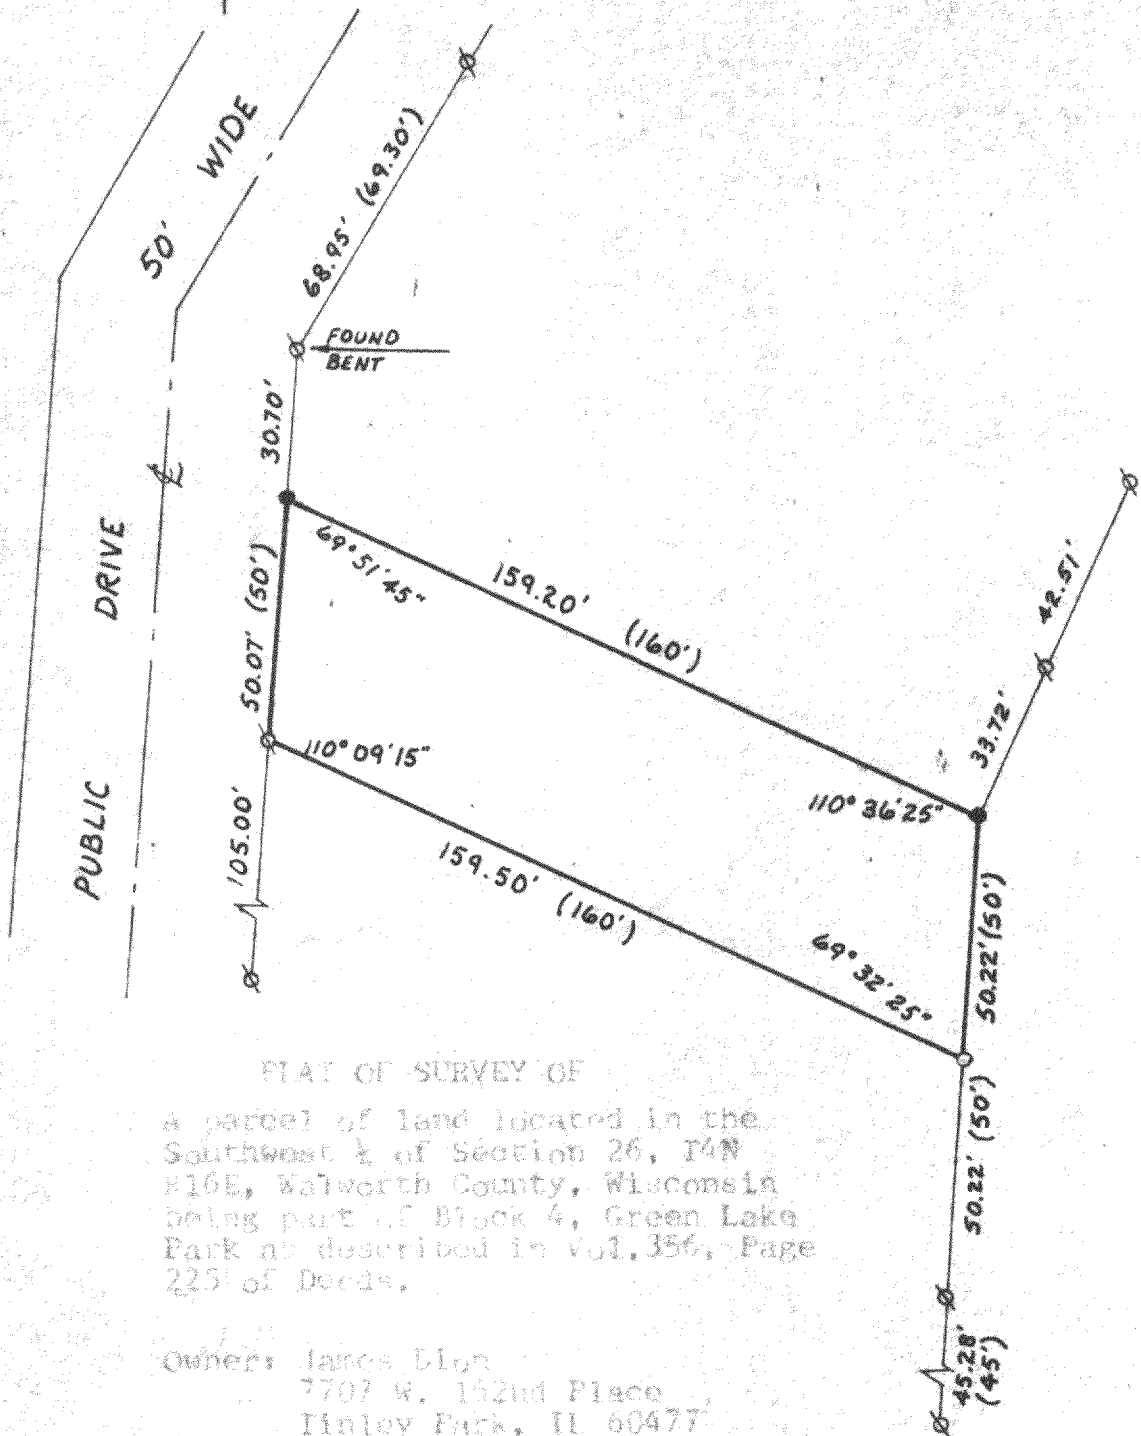

PLAT OF SURVEY OF
A parcel of land located in the
Southwest $\frac{1}{4}$ of Section 26, T4N
R16E, Walworth County, Wisconsin
being part of Block 4, Green Lake
Park as described in Vol. 356, Page
225 of Deeds.

Owner: James Lion
7707 W. 152nd Place
Tinley Park, IL 60477

N



SCALE: 1"=40'

LEGEND

- - CONCRETE MONUMENT FOUND
- ⊗ - IRON PIPE FOUND
- - IRON PIPE PLACED
- () - DESCRIBED AS

I, Eugene A. Blomquist, do hereby certify
that I have surveyed the property hereon
described according to the official records
and that the plat hereon is a correct
representation of the lot lines.



Eugene A. Blomquist
EUGENE A. BLOMQUIST
WISCONSIN REGISTERED LAND SURVEYOR, S-1279
DATE Nov. 14, 1979