


# FARRIS, HANSEN & COOPER, INC.

ENGINEERING, SURVEYING AND LAND PLANNING  
715 W. WALWORTH ST. - P.O. BOX 487 - ELKHORN, WI 53121

NOTE: The Southeasterly right-of-way line of West Shore Drive is assumed to bear N 29°00' E as shown on the plat of Morris Park Subdivision.

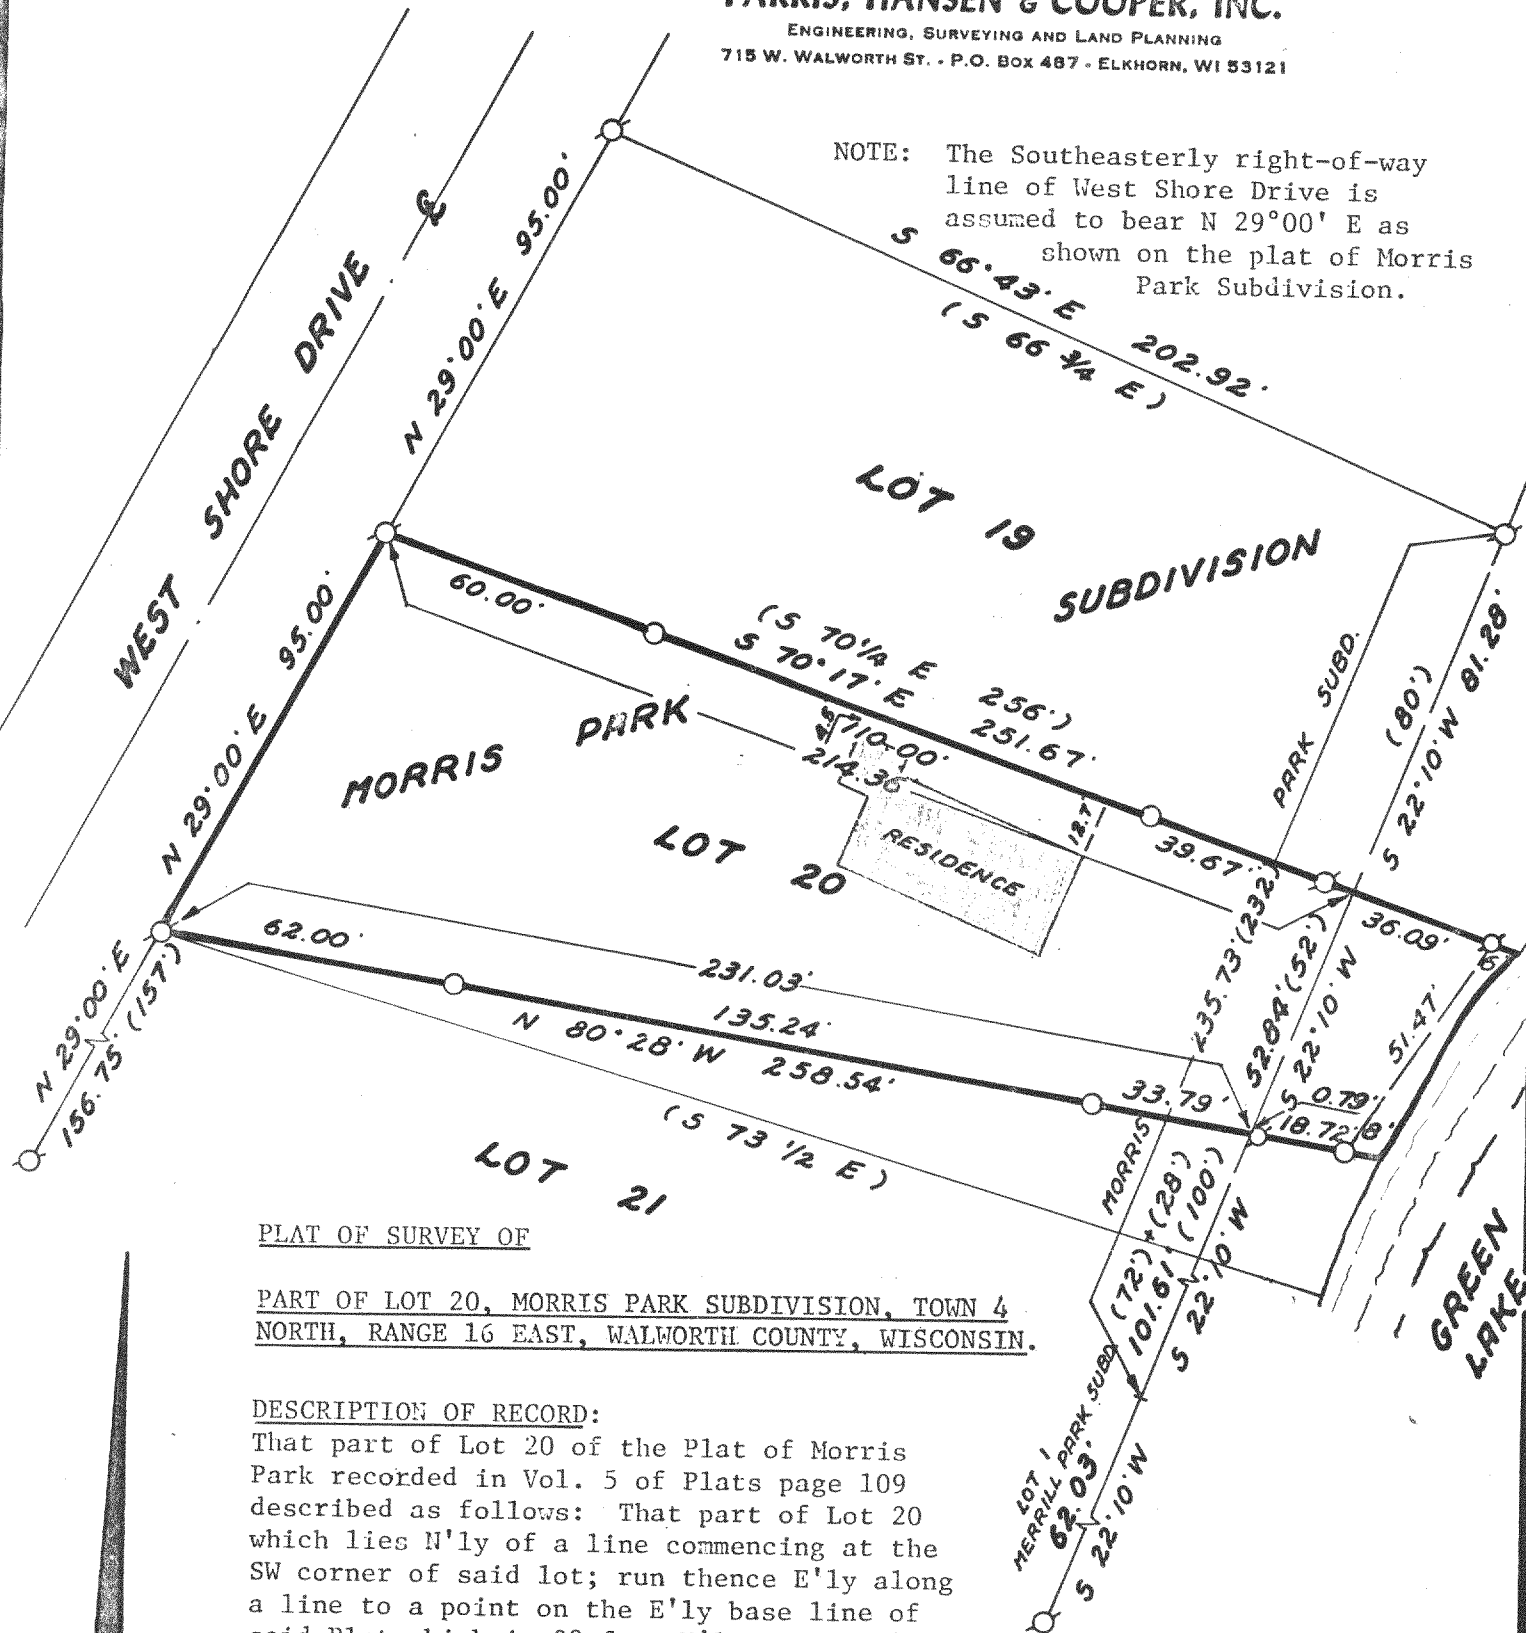

## PLAT OF SURVEY OF

PART OF LOT 20, MORRIS PARK SUBDIVISION, TOWN 4 NORTH, RANGE 16 EAST, WALWORTH COUNTY, WISCONSIN.

## DESCRIPTION OF RECORD:

That part of Lot 20 of the Plat of Morris Park recorded in Vol. 5 of Plats page 109 described as follows: That part of Lot 20 which lies N'ly of a line commencing at the SW corner of said lot; run thence E'ly along a line to a point on the E'ly base line of said Plat which is 28 feet N'ly of the S'ly line of said lot (measured along said base line) and continuing along said line to the low water line of Green Lake. Described on the tax roll as follows: MP 18 That part of Lot 20 Morris Park lying N of a line drawn from SW corner of Lot 20 to Ely Base L 28' N of SL Lot 20 Con't to lake shore making a parcel 52' on the shore and 95' in rear.

0 10 20 40



SCALE IN FEET  
1"=40'

## LEGEND

- Iron Pipe Found
- 1" Dia. x 24" Iron Pipe Set
- ( )—Record Dimension

ORDERED BY: George A. Lohrmann



I HEREBY CERTIFY that I have surveyed the property described hereon and that this Plat of Survey is a true and accurate representation of the lot lines and the building located thereon to the best of my professional knowledge and belief.

*Daniel D. Cooper*  
Daniel D. Cooper, RLS No. 1464  
Dated this 12 day of Oct 1979.

PROJ. NO. 1582

416-304