
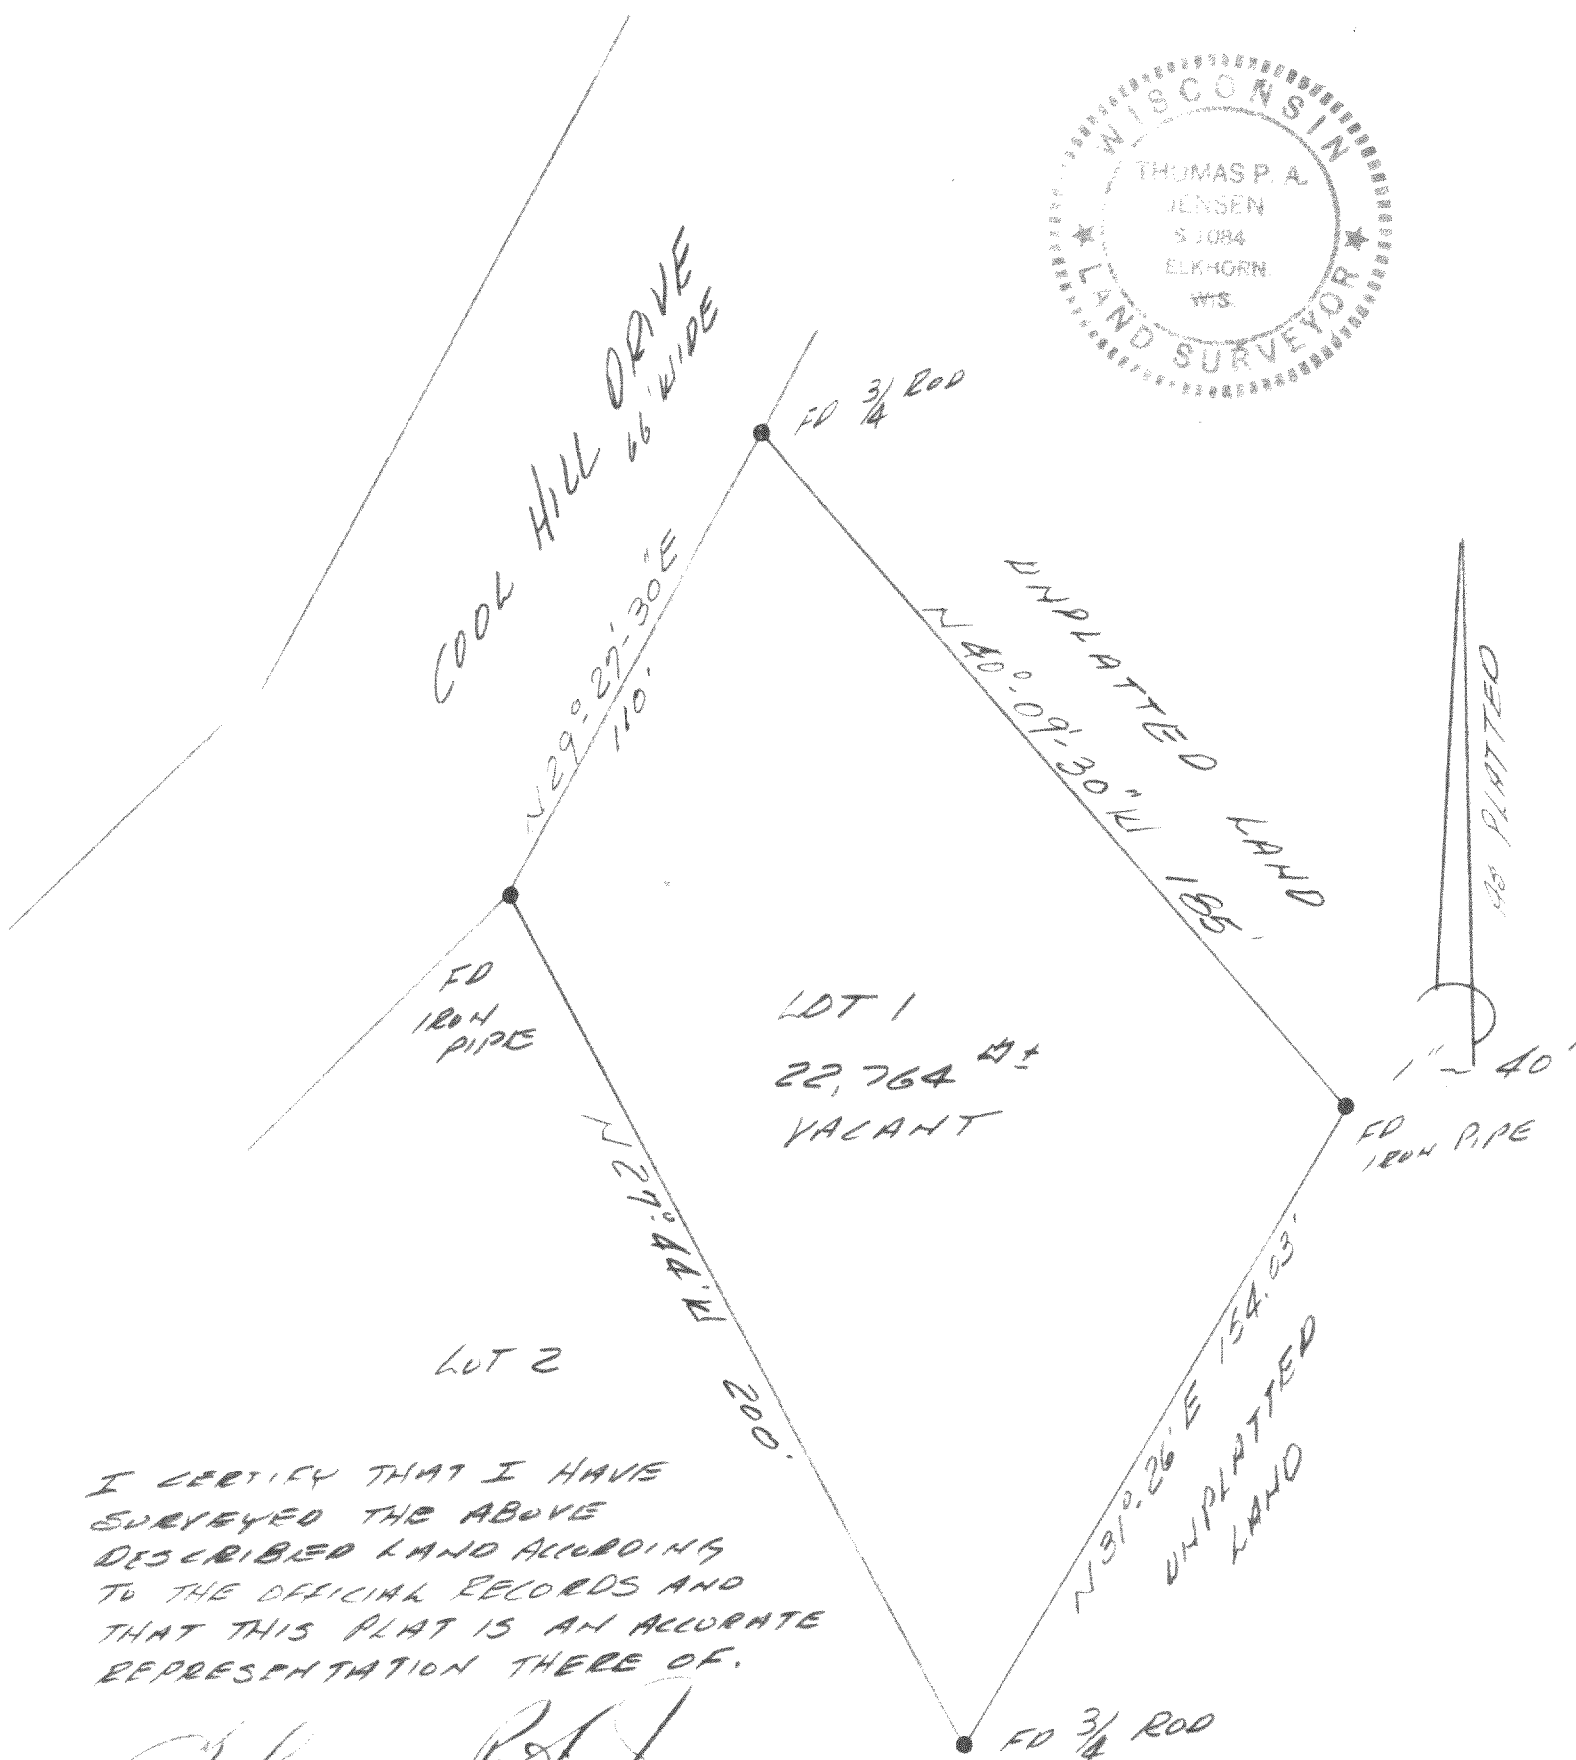



PLAT OF SURVEY OF LOT 1 BLOCK 8 COOL HILL
PARK ADDITION NO 1 LOCATED IN SECTIONS
34 & 35, T4N R16E AND IN SECTIONS 2 & 3 T3N
R16E, WALKWORTH CO. WIS.

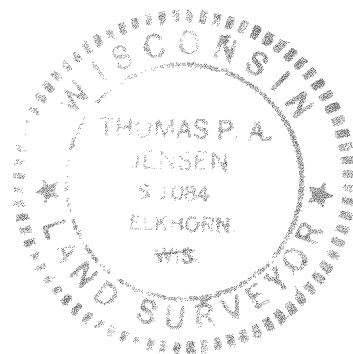

I CERTIFY THAT I HAVE
SURVEYED THE ABOVE
DESCRIBED LAND ACCORDING
TO THE OFFICIAL RECORDS AND
THAT THIS PLAT IS AN ACCURATE
REPRESENTATION THERE OF.

Thomas P. A. Jensen

THOMAS P. A. JENSEN 5-1084
JENSEN SURVEYING & MAPPING, SC.
ELKHORN, WIS. 53121
723-3434
OCT. 14, 1982

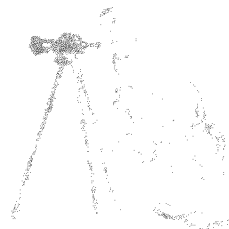

SURVEYED FOR: Colony Realty
ELK. WIS.
WCH-12

416-310 J 1982.039