



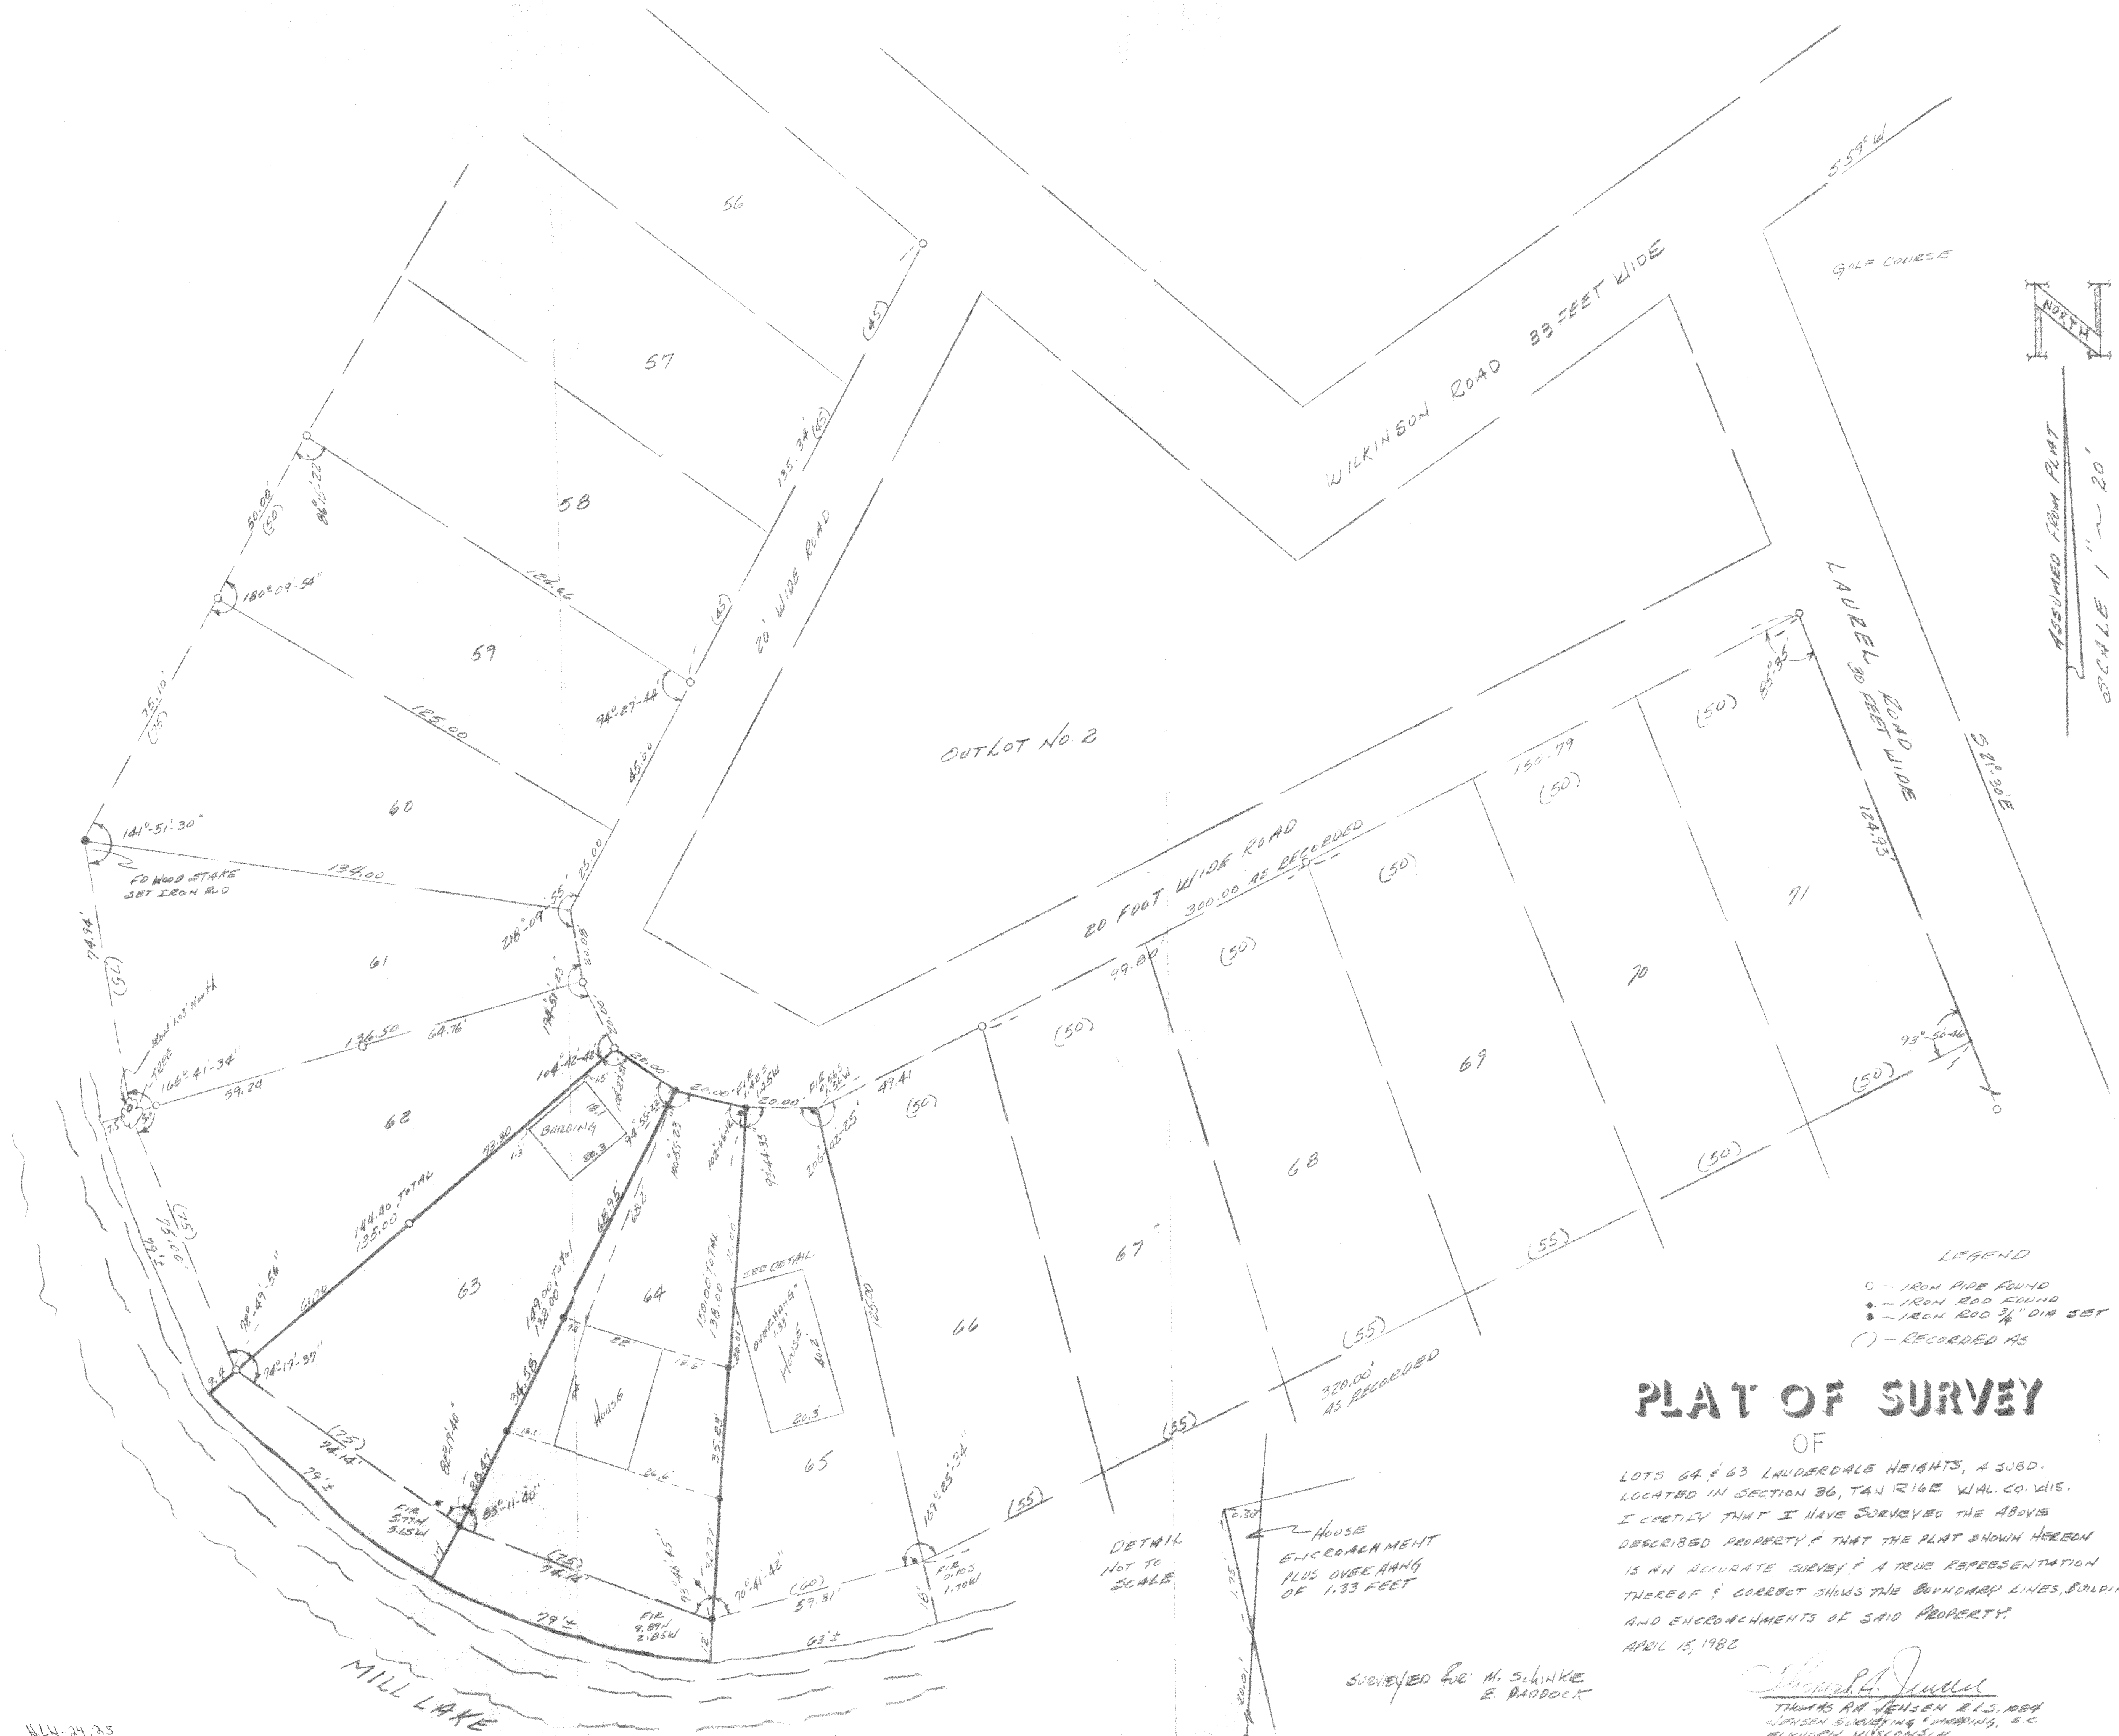

PLAT OF SURVEY OF

LOTS 64 & 63 LAUDERDALE HEIGHTS, A SUBD.
LOCATED IN SECTION 36, T4N R16E W4L. CO. WIS.
I CERTIFY THAT I HAVE SURVEYED THE ABOVE
DESCRIBED PROPERTY & THAT THE PLAT SHOWN HEREON
IS AN ACCURATE SURVEY & A TRUE REPRESENTATION
THEREOF & CORRECT SHOWS THE BOUNDARY LINES, BUILDINGS,
AND ENCROACHMENTS OF SAID PROPERTY.
APRIL 15, 1980

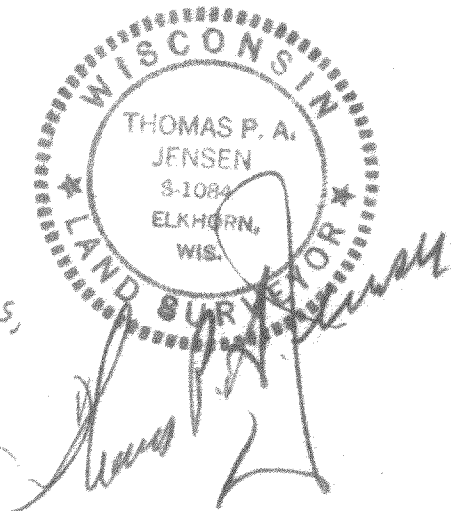

SURVEYED FOR: M. SCHINKE
E. PADDOCK

THOMAS P. JENSEN R.L.S., RES.
JENSEN SURVEYING & MAPPING, S.C.
ELKHORN, WISCONSIN