


SURVEY OF
 THE EAST LINE OF LOT 9, BLOCK 13 OF
 COOL HILL PARK ADDITION NO. 2, LOCATED IN
 THE SE 1/4 OF THE SE 1/4 OF SECTION 34, T4N, R16E,
 TOWN OF LAGRANGE, AND IN THE NE 1/4 OF THE NE 1/4 OF
 SECTION 3, T3N, R16E, TOWN OF SUGAR CREEK,
 WALWORTH COUNTY, WIS.

BUBBLING SPRINGS SECOND ADDITION


JULY 9, 1980

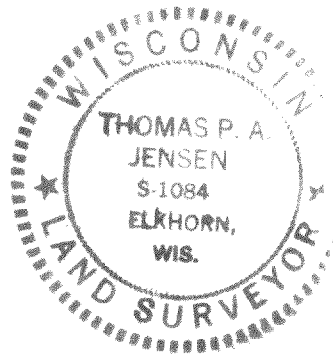

LOT 10

LOT 9

COOL HILL PARK ADDITION NO. 1

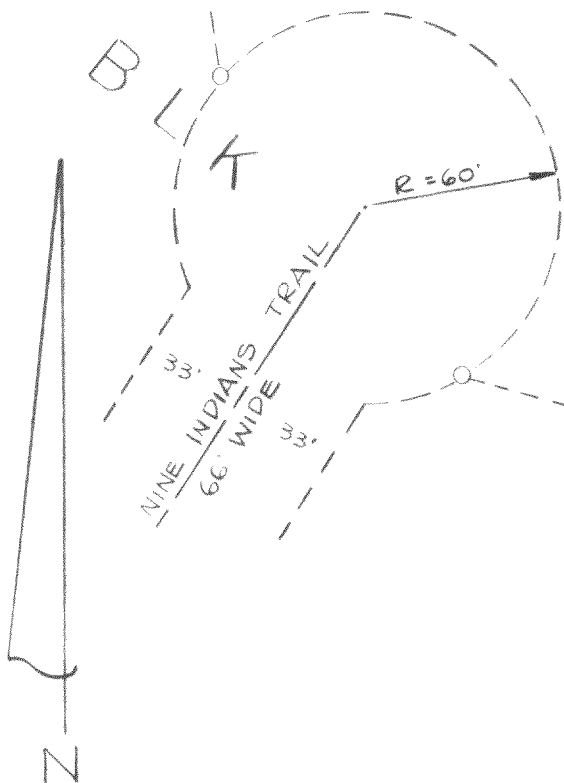

MP 12.98'
 161.40'
 365.41'
 90.02'
 MP
 101.01'
 MP

13

LOT 8

SCALE 1" = 60 FEET

LEGEND

- ~ 1 3/16" DIA. IRON BAR FOUND
- ~ 3/4" DIA. IRON ROD FOUND
- ~ 3/4" DIA. IRON ROD SET
- ~ 1" DIA. IRON PIPE FOUND

☁ - INDICATES LARGE TREES ON LINE

MP ~ METAL POST NEAR MONUMENT

SURVEYED FOR: CENTURY 21
 704 N. LINCOLN ST
 ELKHORN, WIS

OWNER: V. CALI

JENSEN SURVEYING & MAPPING
 P.O. BOX 322
 ELKHORN, WIS.

Thomas P. Jensen

NCH2-11 (S. Line)

1980.042