
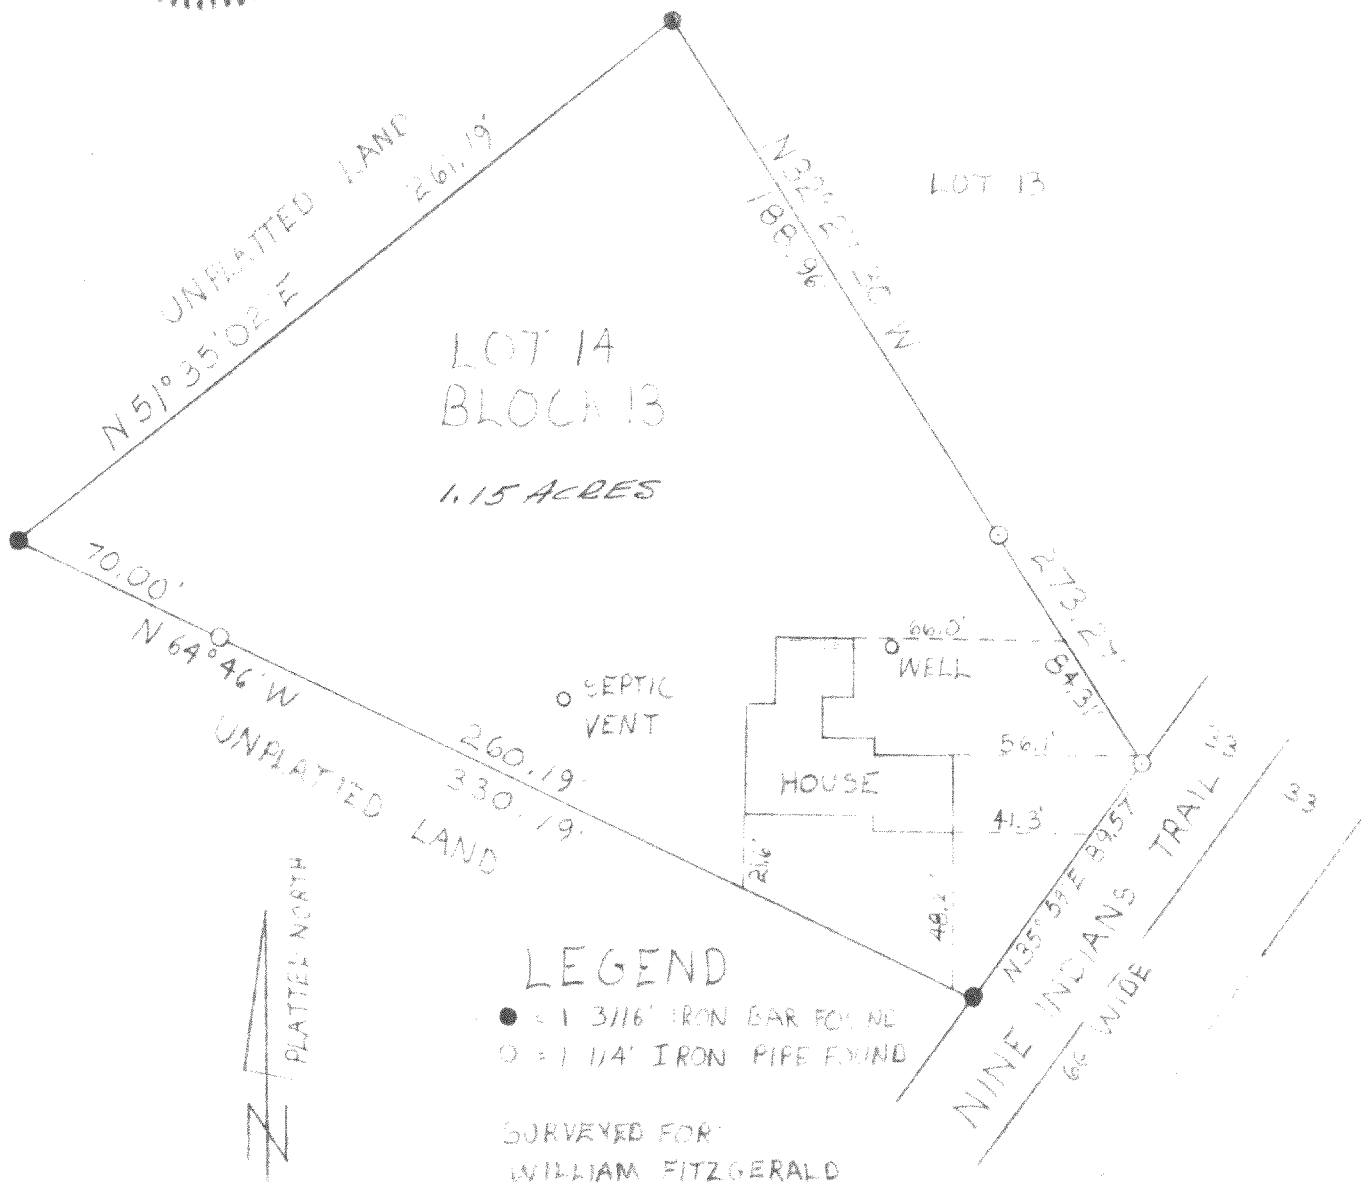


LOCATED IN THE SE 1/4 OF THE SE 1/4 OF SECTION 34 T4N
R16E TOWN OF LA GRANGE AND IN THE NE 1/4 OF THE NE 1/4
OF SECTION 3, T3N R16E, TOWN OF SUGAR CREEK,
WALWORTH COUNTY WISCONSIN

I CERTIFY THAT I HAVE SURVEYED THE DESCRIBED PROPERTY AND THAT THE PLAN SHOWN HEREIN IS AN ACCURATE SURVEY AND A TRUE REPRESENTATION THEREOF, CORRECTLY SHOWS THE BOUNDARY LINES OF SAID PROPERTY & ALL BUILDINGS THEREON.

THOMAS R. JENSEN 5-1084
JENSEN SURVEYING & MAPPING
P.O. BOX 322
ELKHORN WISCONSIN
MAY 10, 1980

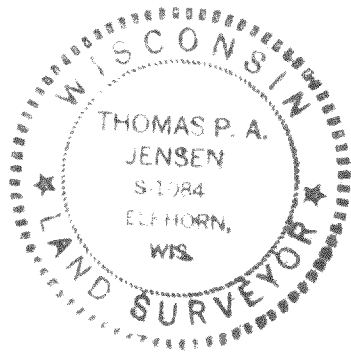

SCALE = 50'

SURVEY ORDERED BY:
D. C. STEPHANI
678 MAIN ST
GLEN ELEN, ILL. 60137

1980.042