

of

a subdivision located in the Southwest 1/4 of the Southeast 1/4 of Section 36,
Town 4 North, Range 16 East, Town of LaGrange, Walworth County, Wisconsin.

Coordinates are referenced to the Wisconsin State Plane Coordinate System, South Zone, (NAD-27)



Notes:

- 1) This Plat of Survey is not certified unless signed and sealed in red ink.
- 2) This survey is subject to Wisconsin lien laws. This Plat of Survey is the notice of intent to file lien. Lien waiver required.
- 3) The Survey Date shown on this Plat of Survey is the completion date of the field work.

Copyright © 2019 by Olson Land Surveying, LLC.

All rights reserved. No part of this survey plat may be reproduced or transmitted in any form by any means - graphic, electronic, or mechanical, including photocopying, tracing, or information storage and retrieval systems - without permission in writing from Douglas G. Olson, Olson Land Surveying, LLC.

I hereby certify that I have surveyed the above described property in compliance with Chapter A-E 7 of the Wisconsin Administrative Code and that the map hereon is correct to the best of my professional knowledge and belief and shows the size and location of the property, its exterior boundaries, the location and dimensions of all visible structures thereon, boundary fences, apparent easements and roadways and visible encroachments, if any.

This survey is made for the exclusive use of the present owners of the property, and also those who purchase, mortgage or guarantee title thereto, within one year from the date hereof.

Douglas G. Olson
Wisconsin Professional Land Surveyor - 2093


Survey date: October 8, 2019.

Revisions: No. 1 - County Topo
No. 2 - Proposed House
No. 3 - Removed incorrect setback
line per W.D.O.T. email of
11-05-19.
No. 4 - Clarification of Setbacks
No. 5 - Proposed House Moved
No. 6 - House under construction

Sheet 1 of 1 Sheets

Drawing Name:

Scale in Feet

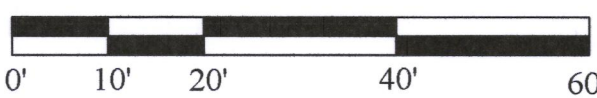 
$$1'' = 20$$


416-3149

Legend of Symbols & Abbreviations

- ☒ Found County Section Corner
☒ Found Iron Pipe ☒ Steel Plug in Concrete
☒ Found Iron Rod ☒ Set Mag Nail
☒ Set Iron Pipe, 1" dia. ☒ Set Wood Lath
 () Recorded Information
☒ Utility Pole
☒ Utility Pedestal
☒ Concrete Cover
☒ Septic Vent
☒ Asphalt Surface
☒ Concrete Surface
☒ Gravel Surface
☒ Brick Pavers

N North
S South
E East
W West
in Bearings
° Degrees
' Minutes
" Seconds
in Distances
' Feet
" Inches
No. Number
NW. Northwest
NE. Northeast
Dia. Diameter



OLSON
LAND SURVEYING, LLC

Rural | Residential | Commercial

45 South Wisconsin Street | P.O. Box 322
Elkhorn, Wisconsin. 53121
Telephone: (262) 723-3434
Facsimile: (262) 723-8044
Email: doug@olsonsurveying.com
Website: www.olsonsurveying.com

Email: doug@olsonsurveying.com
Website: www.olsonsurveying.com