


DUNHAM SURVEYING, S.C.
SURVEYING & SUBDIVIDING
DELAVAN, WISCONSIN 53115

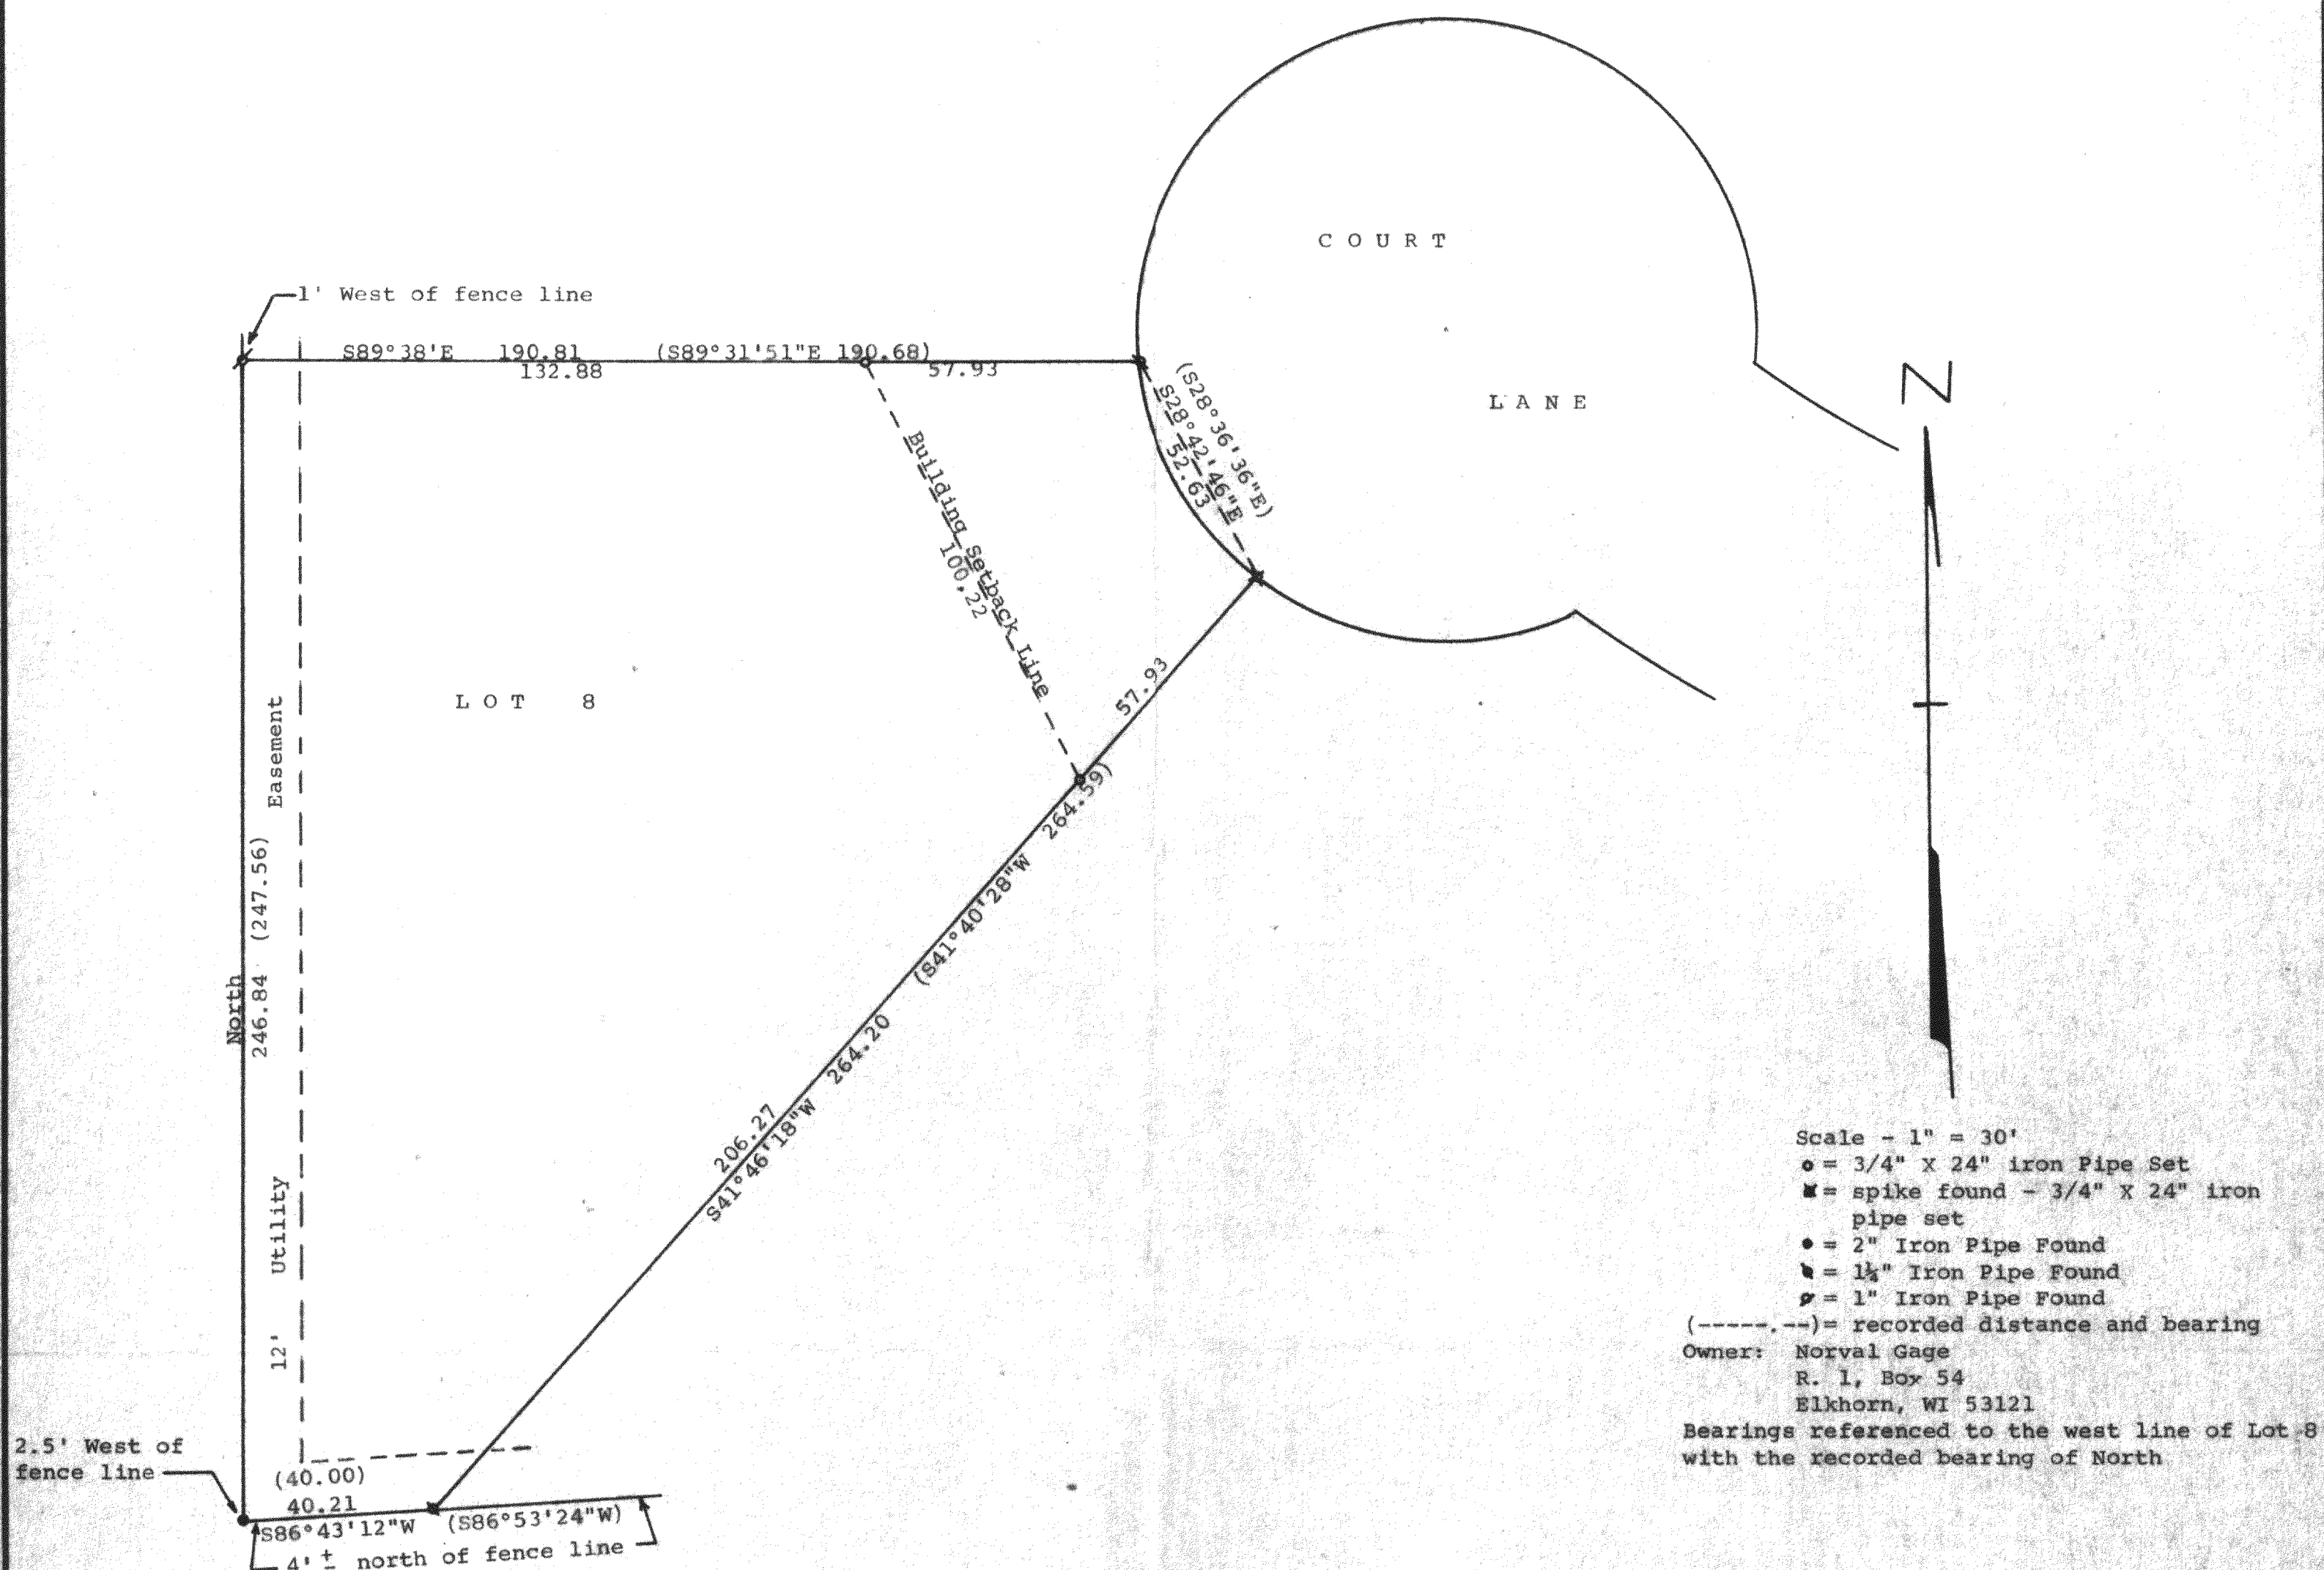

STATE OF WISCONSIN) SS
COUNTY OF WALWORTH)

I, George T. Dunham, Surveyor, certify that I have surveyed the property described as follows:

Lot 8 in Block 2 of Pebble Beach Subdivision located in the Northeast 1/4 of Section 26 and in the Northwest 1/4 of Section 25, T 4 N, R 16 E, Walworth County, Wisconsin

and that the map shown above is a true representation thereof and shows the size and location of the property, its exterior boundaries, the location of all visible structures and dimensions of all principal buildings thereon, boundary fences, apparent easements, roadways and visible encroachments, if any, and that I have surveyed the property hereon described according to the official records, to the best of my knowledge and belief.

October 5, 1983

George T. Dunham
George T. Dunham, Surveyor

