


PLAT OF SURVEY OF A LOT LINE ADJUSTMENT OF LOTS 1 & 2
CERTIFIED SURVEY MAP NUMBER 848 VOL 4 PGS 35+36
LOCATED IN THE NW 1/4 OF THE NE 1/4 OF SECTION 35 T4N R16E,
TOWN OF LAGRANGE, WALWORTH COUNTY, WISCONSIN; DESCRIBED AS FOLLOWS:

COMMENCE AT THE SE CORNER OF LOT 2 OF SAID CERTIFIED SURVEY MAP; THENCE N 1° 49' 16" W 187.70 FEET TO POINT OF BEGINNING; THENCE N 1° 49' 16" W 112.97 FEET TO A POINT ON A MEANDER LINE; SAID POINT LOCATED S 1° 49' 16" E 2 FEET FROM THE SHORE OF MIDDLE LAKE; THENCE S 75° 55' 23" W ALONG THE SAID MEANDER LINE, 16.50 FEET TO A POINT, SAID POINT LOCATED S 10° 12' 01" E, 14 FEET FROM THE SHORE OF MIDDLE LAKE, THENCE S 10° 12' 01" E 110.65 FEET TO THE P.O.B. ALSO ALL THE LAND BETWEEN THE ABOVE DESCRIBED MEANDER LINE & THE SHORE OF MIDDLE LAKE. THE ABOVE DESCRIBED PARCEL IS A LOT LINE ADJUSTMENT BETWEEN TWO ADJOINING LAND OWNERS.

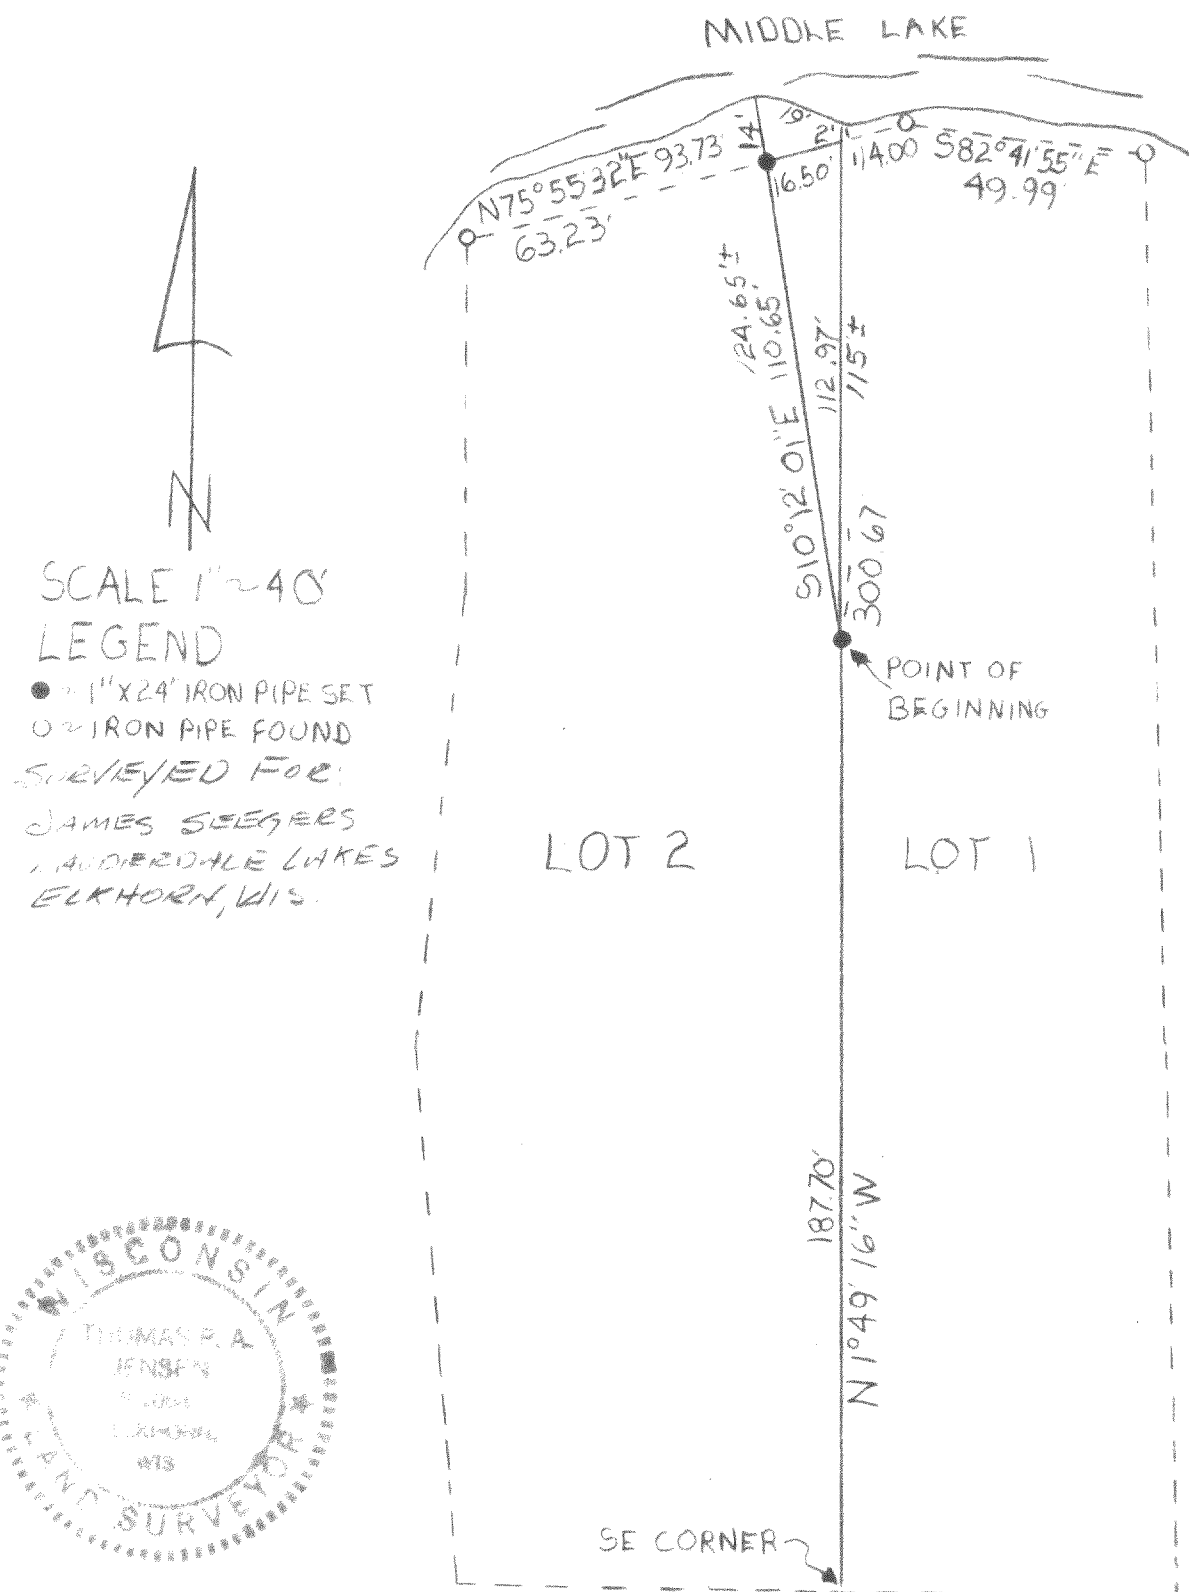

I CERTIFY THAT I SURVEYED THE ABOVE DESCRIBED PROPERTY AND THAT THE PLAT SHOWN HEREON IS AN ACCURATE SURVEY AND A TRUE REPRESENTATION THEREOF AND CORRECTLY SHOWS THE BOUNDARY LINES AND ALL DIVISIONS THEREOF.

THOMAS P. JENSEN S-1084
JENSEN SURVEYING & MAPPING
ELKHORN, WISCONSIN

SEPT. 24, 1979

416-318-T