



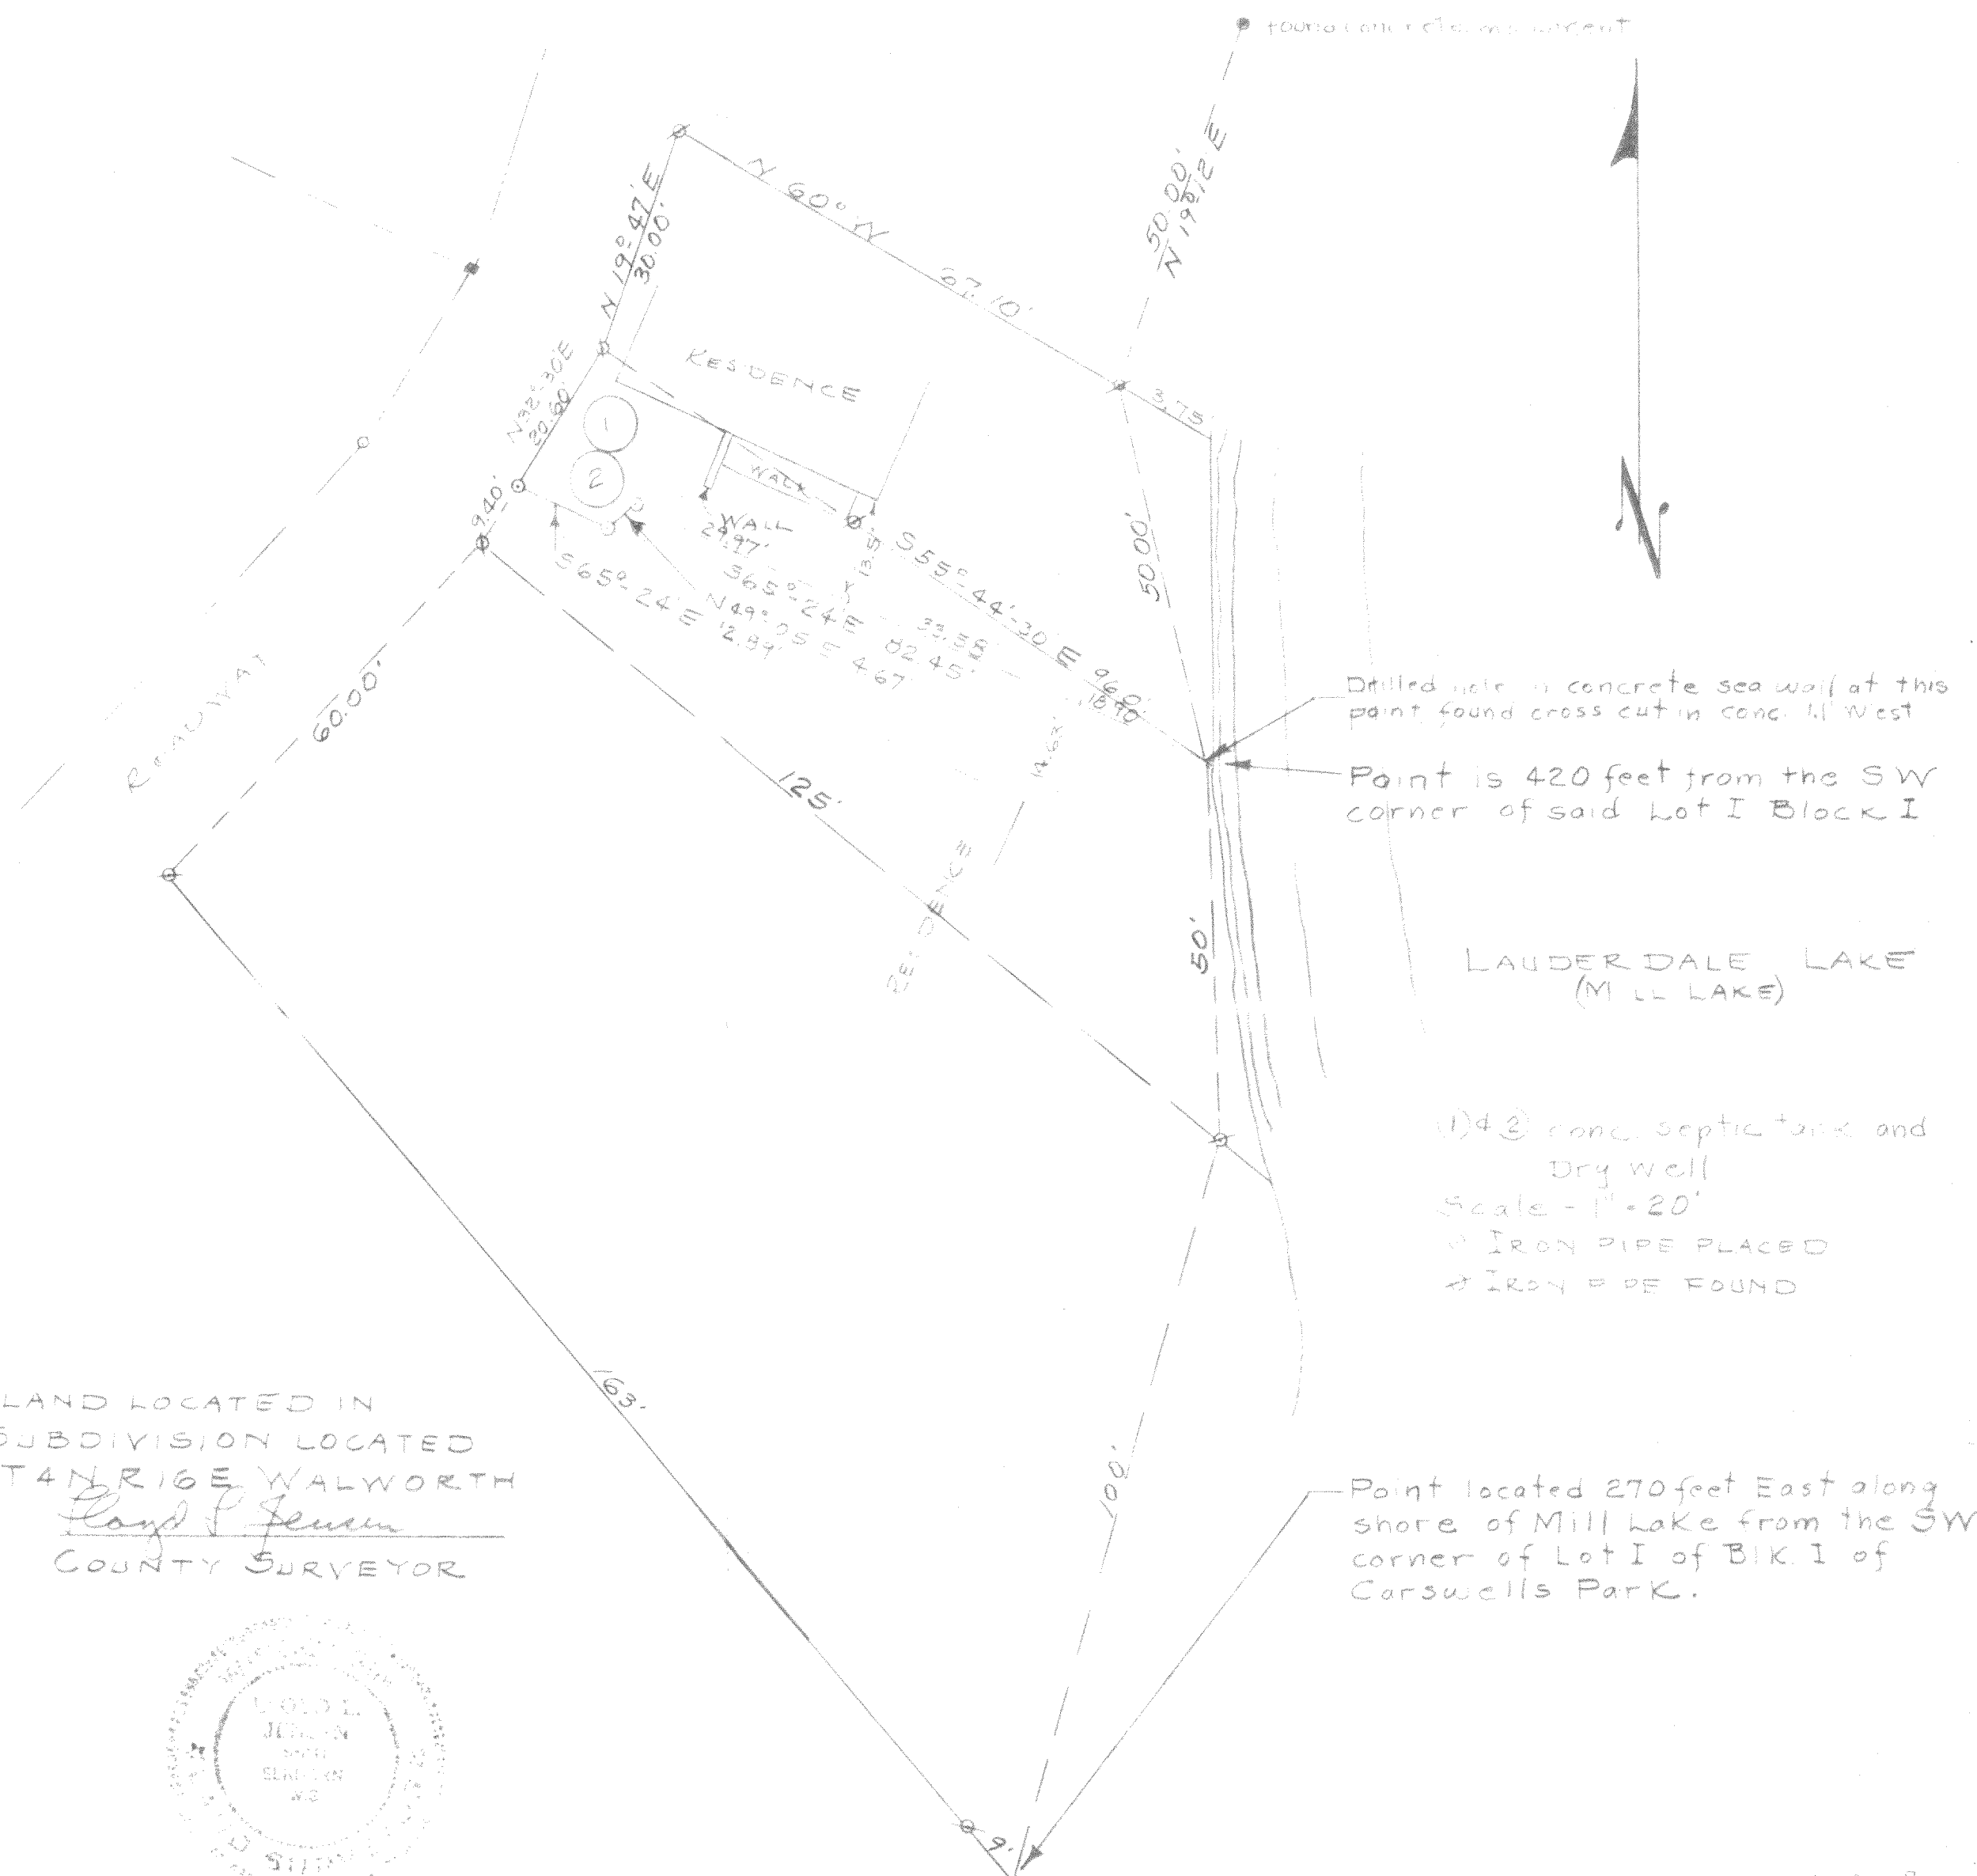


PLAT OF A SURVEY OF LAND LOCATED IN
 CARSWELLS PARK, A SUBDIVISION LOCATED
 IN SECTIONS 35 & 36 T4N R16E WALWORTH
 COUNTY WIS.
 JUNE 1978

Lloyd P. Jensen
 COUNTY SURVEYOR

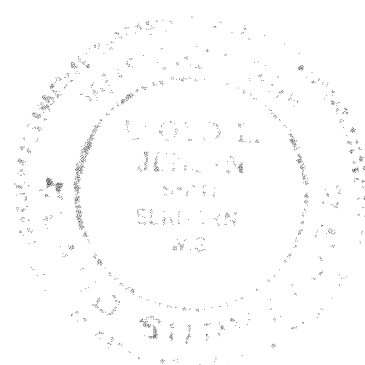


The northerly line of the Kopeny property was assumed to bear N 60° W as recorded in earlier surveys in this area.

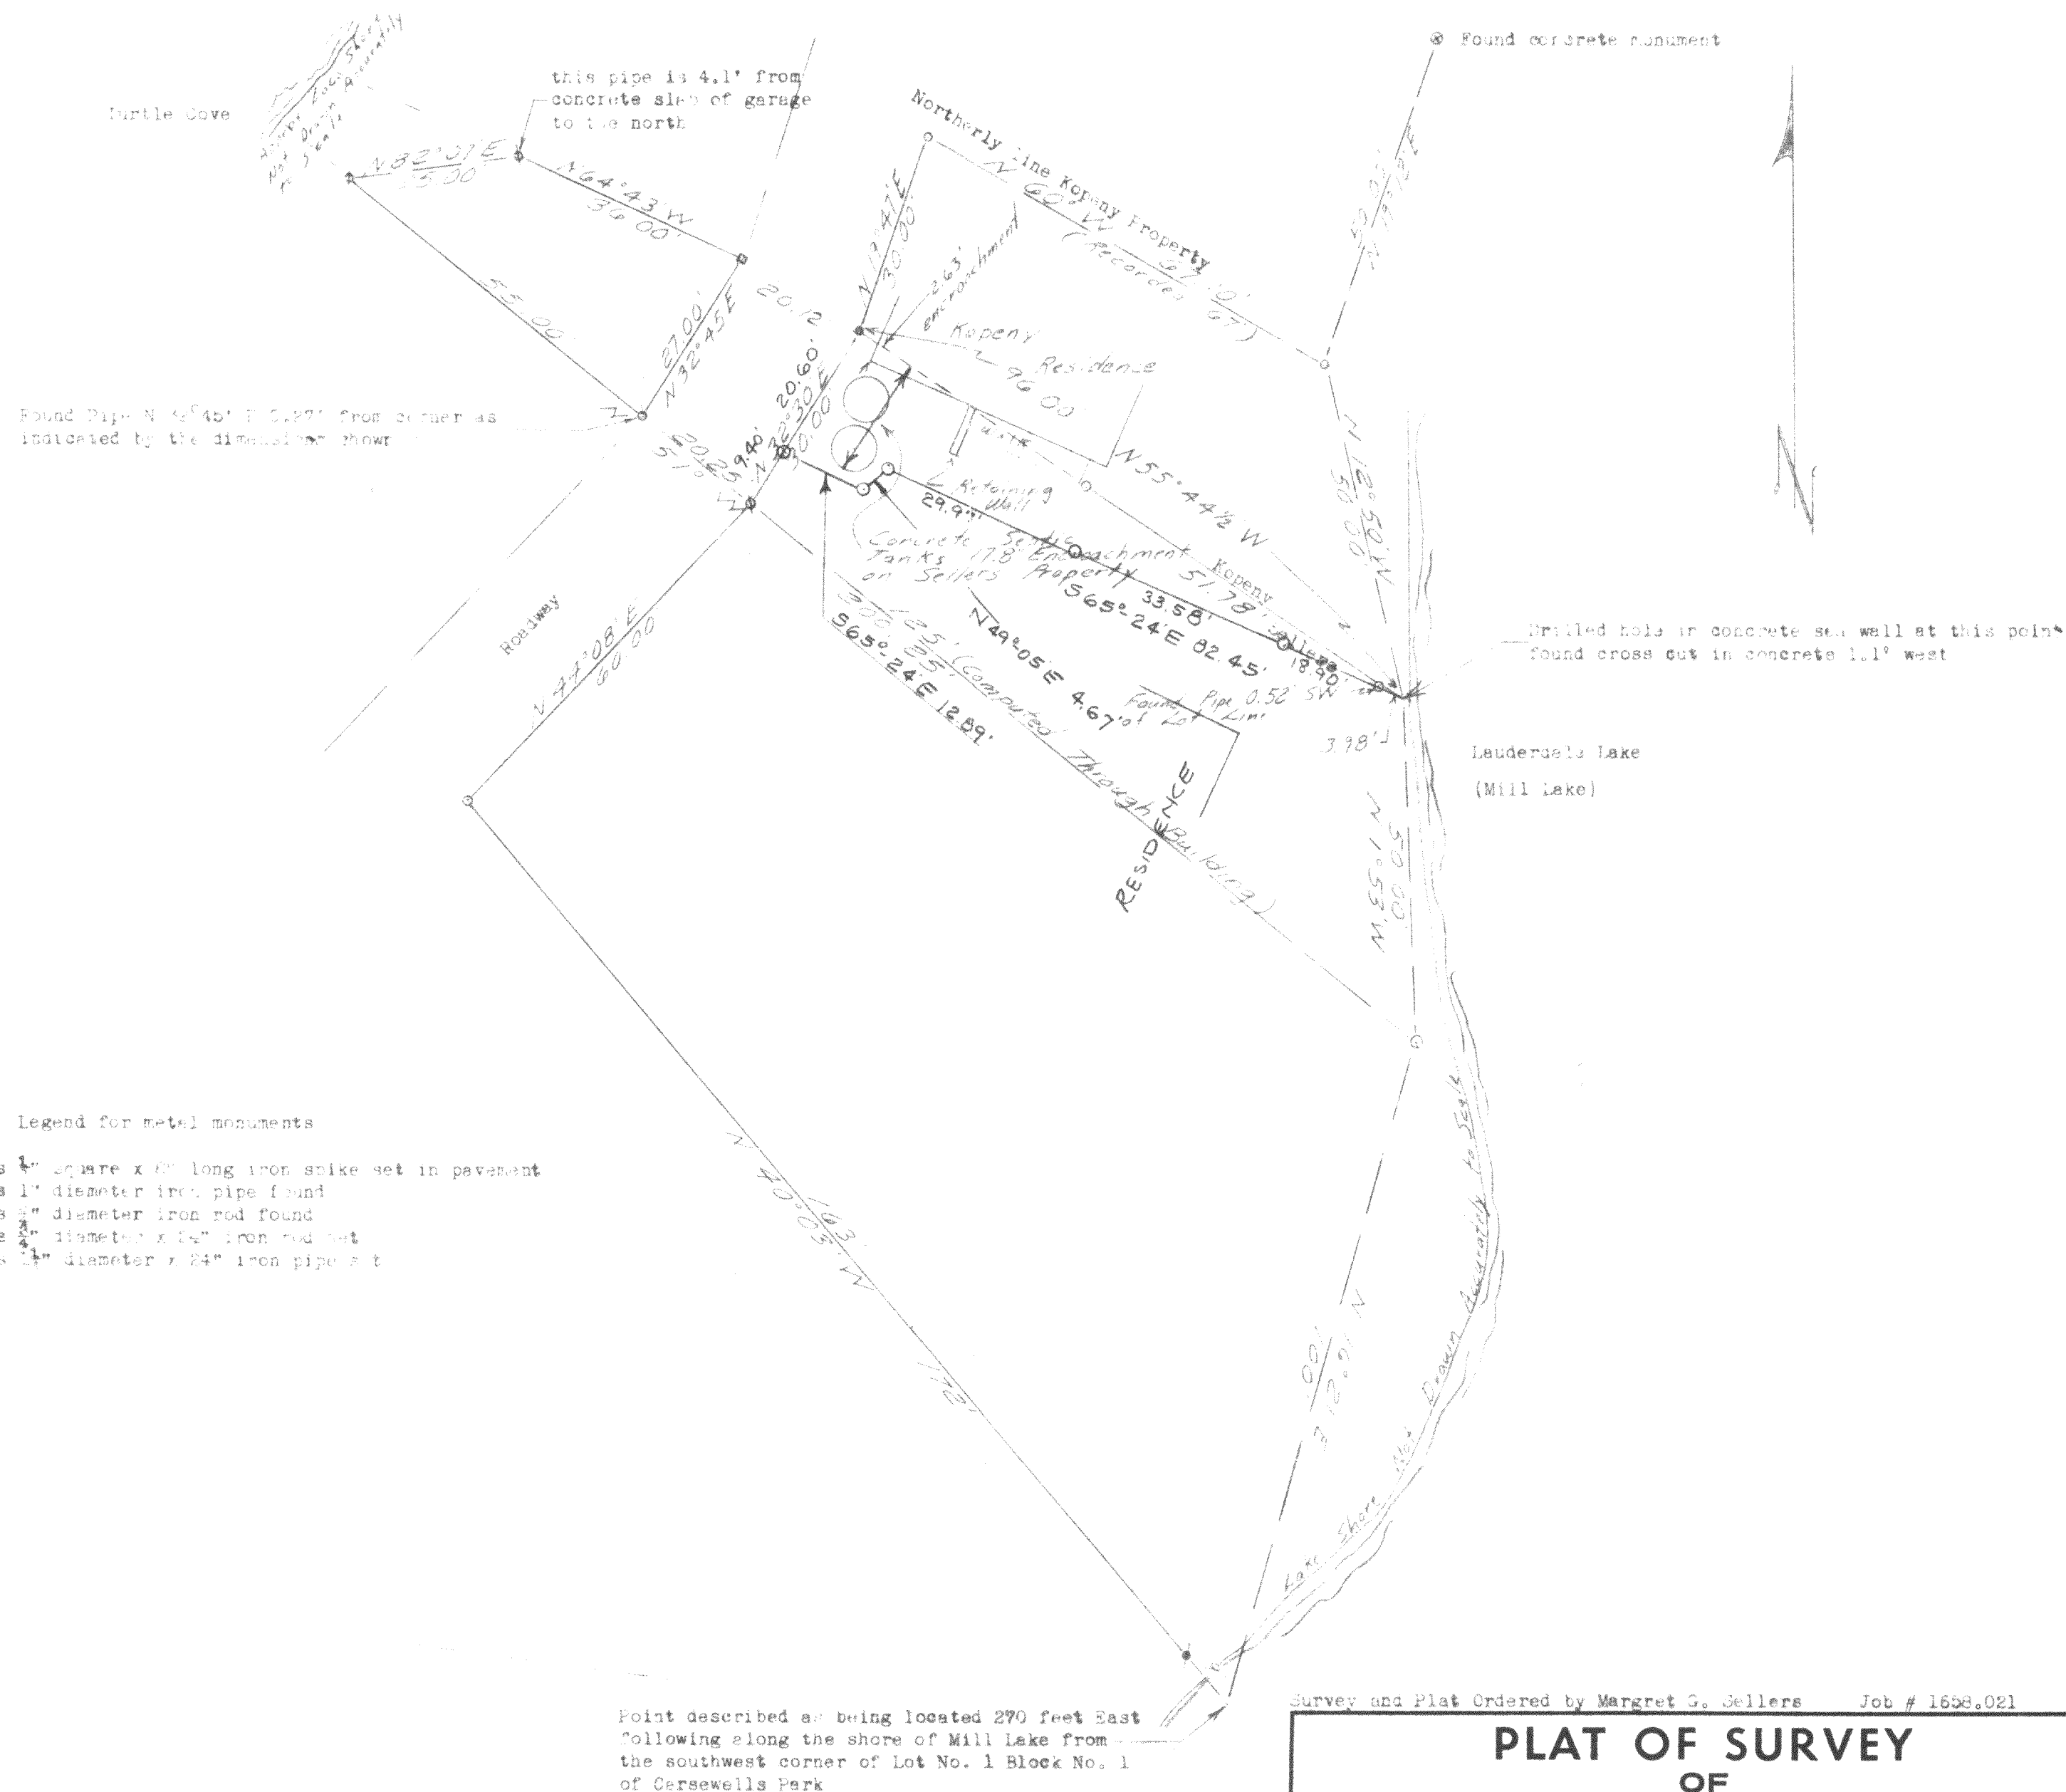

I, Lloyd L. Jensen, surveyor, do hereby certify that under my direction the lands shown hereon have been surveyed and mapped, and that this Plat of Survey is a true and accurate representation of the lot lines to the best of my knowledge and belief.

Dated this 9th day of Sept., 1976
REVISED JUNE 1978

Lloyd L. Jensen
Lloyd L. Jensen S - 211

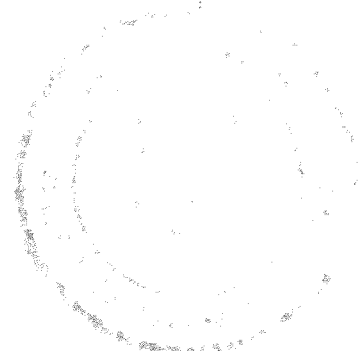

NCA-8