


PLAT OF SURVEY

OF LOT 1 OF CERTIFIED SURVEY MAP No. 848 Vol. 4 Pgs. 35 & 36
AND A PARCEL OF LAND DESCRIBED IN A PLAT OF SURVEY OF A
LOT LINE ADJUSTMENT DATED SEPT. 24 1979, ALL LOCATED
IN THE N.W. 1/4 OF THE N.E. 1/4 OF SECTION 35, T4N, R16E, TOWN
OF LAGRANGE, WALWORTH COUNTY, WIS.

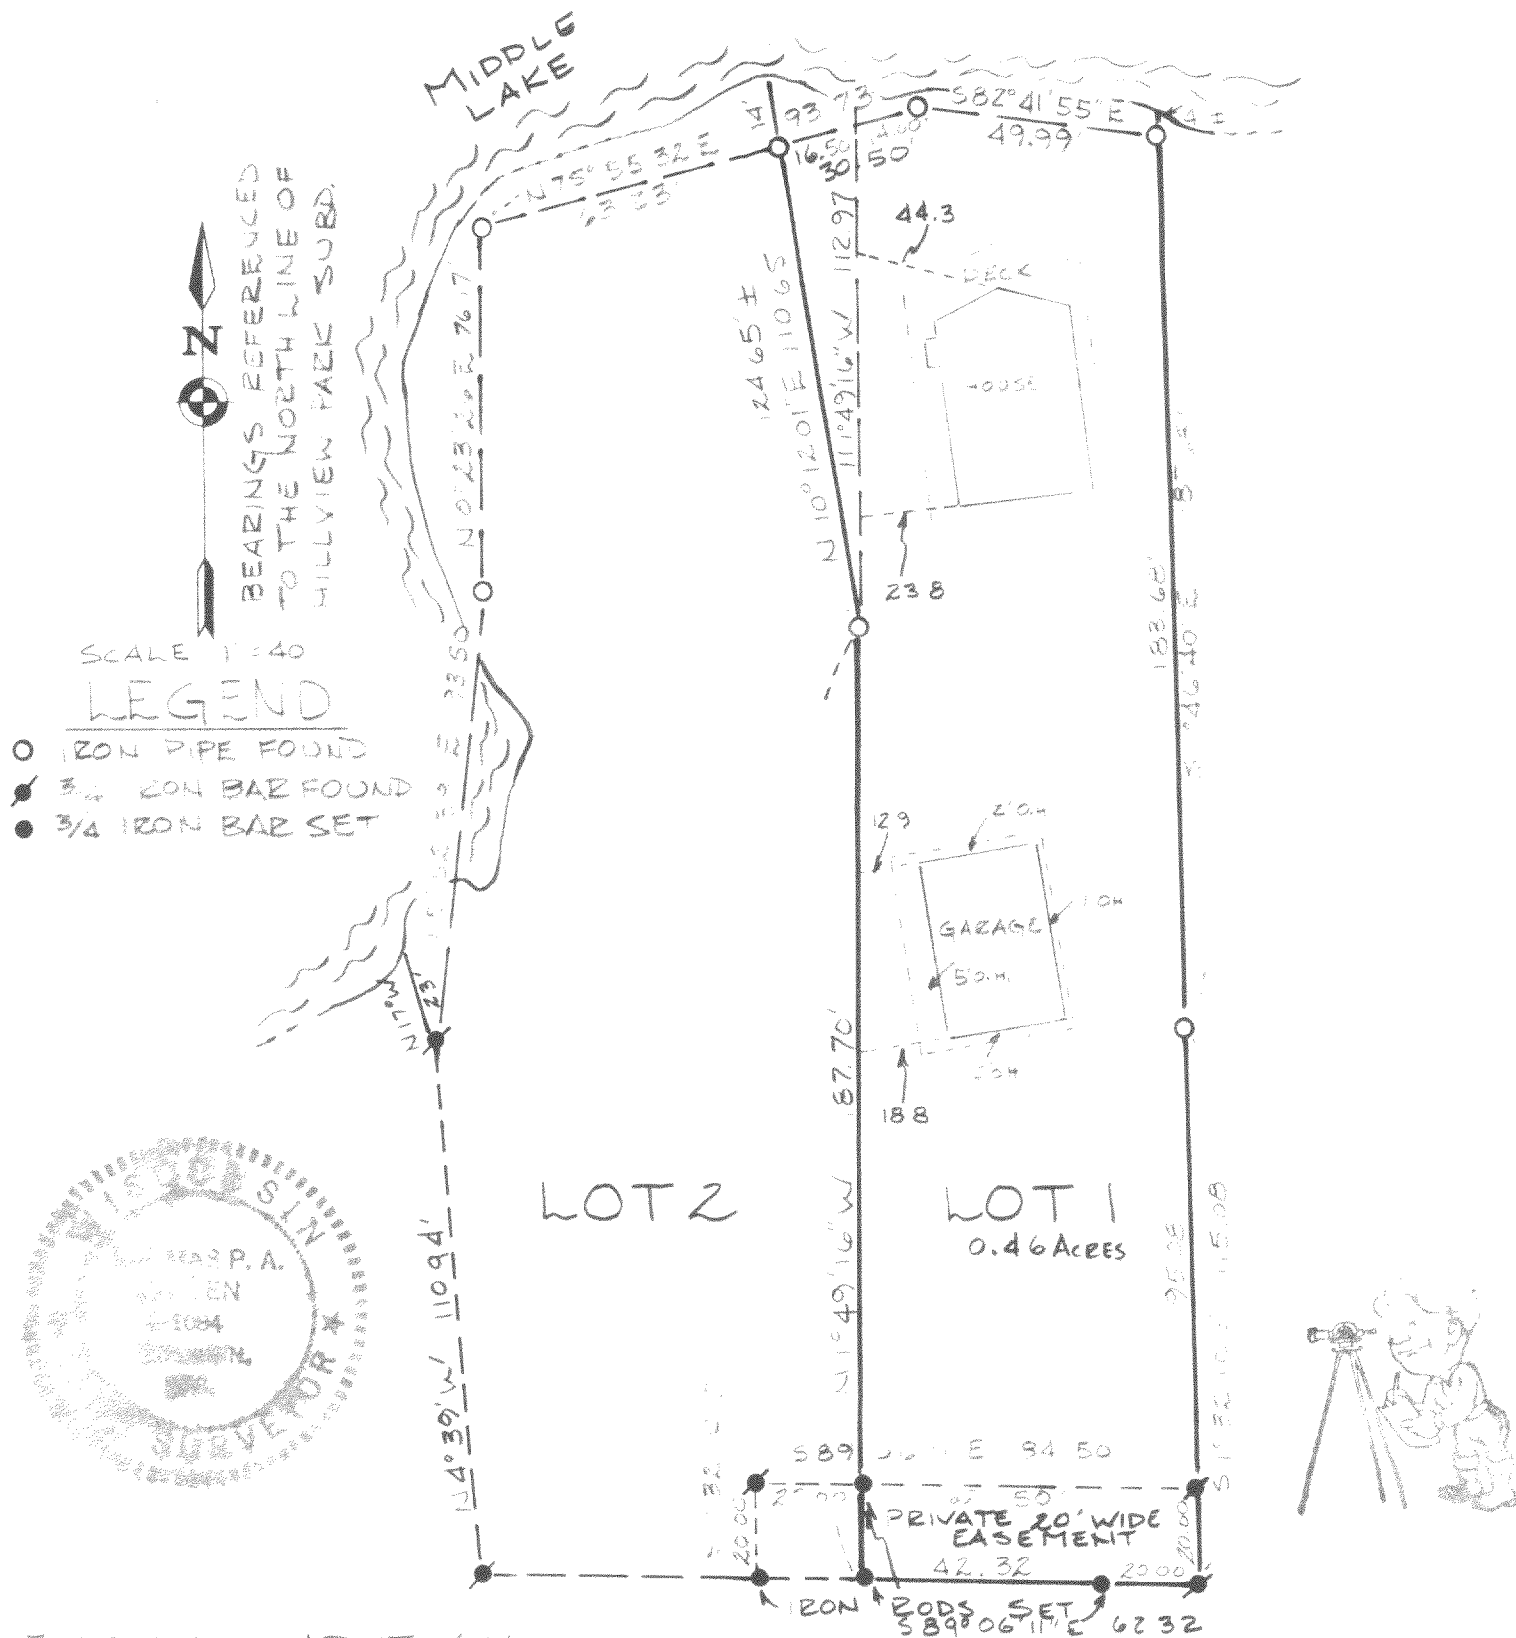

JENSEN SURVEYING & MAPPING S.C.

P.O. BOX 322

ELKHORN, WIS 53121

SURVEYED BY: THOMAS P.A. JENSEN R.L.S. # 1084

SURVEYED FOR: DR. JAMES SEEGER
27#1 BOX 646, ELKHORN, WI

DESCRIPTION OF LOT LINE ADJUSTMENT

COMMENCE AT SE CORNER OF LOT 2 OF SAID CERTIFIED SURVEY MAP;
THENCE N 1°49'16"W 187.70 FEET TO THE POINT OF BEGINNING; THENCE
N 1°49'16"W 112.97 FEET TO A POINT ON A MEANDER LINE, SAID POINT LOCATED
S 1°49'16"E 200 FEET FROM THE SHORE OF MIDDLE LAKE; THENCE S 75°55'23"W,
ALONG SAID MEANDER LINE, 16.50 FEET TO A POINT, SAID POINT BEING
S 10°12'01"E 14.00 FEET FROM THE SHORE OF MIDDLE LAKE; THENCE S 10°12'01"E
110.65 FEET TO THE POINT OF BEGINNING. ALSO ALL THE LAND BETWEEN
THE ABOVE DESCRIBED MEANDER LINE AND THE SHORE OF MIDDLE LAKE
THE ABOVE DESCRIBED PARCEL IS A LOT LINE ADJUSTMENT BETWEEN TWO ADJOINING OWNERS

I HEREBY CERTIFY THAT, I HAVE SURVEYED THE ABOVE DESCRIBED PROPERTY
THAT THE PLAT SHOWN HEREON IS AN ACCURATE SURVEY, A TRUE
REPRESENTATION THEREOF, CORRECTLY SHOWS THE EXTERIOR BOUNDARY
LINES ON SAID PROPERTY AND THE CORRECT MEASUREMENTS THEREOF
AND THE BUILDINGS THEREON.

MAPPING DATE: MAY 19, 1983

Thomas P.A. Jensen
THOMAS P.A. JENSEN R.L.S. # 1084