


PLAT OF SURVEY

LOT 2 OF CERTIFIED SURVEY MAP No. 848 Vol. 4 Pgs 35 & 36
EXCEPT A PARCEL OF LAND DESCRIBED IN A PLAT OF SURVEY OF
A LOT LINE ADJUSTMENT DATED SEPT. 24 1979 ALL LOCATED IN
THE N.W. 1/4 OF THE N.E. 1/4 OF SECTION 35, T4N, R16E, TOWN OF LAGRANGE,
WALWORTH COUNTY, WIS.

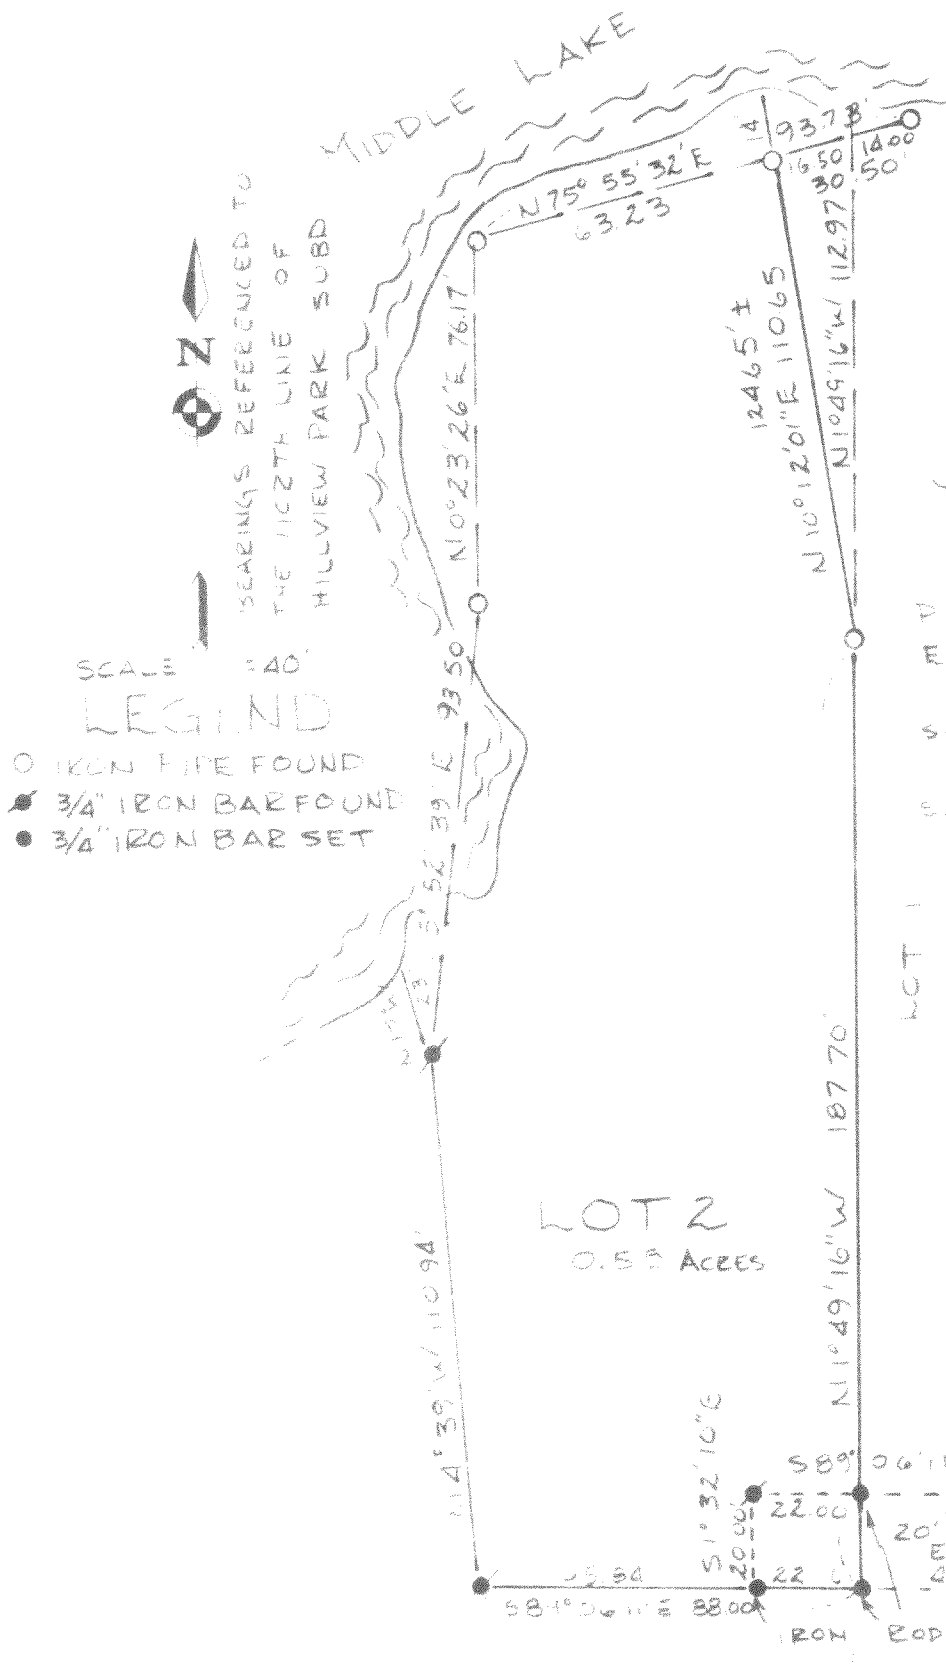

JENSEN SURVEYING MAPPING S.C.

PO BOX 322
ELKHORN, WIS 53121

SURVEYED BY: THOMAS PA JENSEN
RLS #1084

SURVEYED FOR: DON STARKEY
4345 N. CHEROKEE AVE
NORRIDGE ILL
60634

LOT 2
0.53 ACRES

DESCRIPTION OF LOT LINE ADJUSTMENT

COMMENCE AT THE S.E. CORNER OF LOT 2 OF SAID CERTIFIED SURVEY
MAP; THENCE N 1° 49' 16" W 187.70 FEET TO THE POINT OF BEGINNING; THENCE
N 1° 49' 16" W 112.97 FEET TO POINT ON A MEANDER LINE, SAID POINT
BEING S 1° 49' 16" E 2.00 FEET FROM THE SHORE OF MIDDLE LAKE; THENCE
S 75° 55' 23" W 16.50 FEET TO A POINT
SAID POINT BEING S 10° 12' 01" E 14.00 FEET FROM THE SHORE OF MIDDLE
LAKE; THENCE S 10° 12' 01" E 110.65 FEET TO THE POINT OF BEGINNING, ALSO
ALL THE LAND BETWEEN THE ABOVE DESCRIBED MEANDER LINE AND
THE SHORE OF MIDDLE LAKE THE ABOVE DESCRIBED PARCEL IS A LOT LINE
ADJUSTMENT BETWEEN TWO ADJOINING LAND OWNERS.

I HEREBY CERTIFY THAT I HAVE SURVEYED THE ABOVE DESCRIBED PROPERTY
AND THE PLAT SHOWN HEREON IS AN ACCURATE SURVEY, A TRUE
REPRESENTATION THEREOF, CORRECTLY SHOWS THE EXTERIOR BOUNDARY
LINES ON SAID PROPERTY AND THE CORRECT MEASUREMENTS THEREOF.

NA 848-2

THOMAS PA JENSEN RLS #1084
DATE MAY 2 1983 416-323J