

PLAT OF SURVEY


of
Lot 13 of BUBBLING SPRINGS SUBDIVISION, located in the N.W. 1/4 of the S.W. 1/4, the N.E. 1/4 of the S.W. 1/4, and the N.W. 1/4 of the S.E. 1/4 of Section 34, T. 4 N., R. 16 E., Walworth County, Wisconsin.



Surveyed for: DANIEL EBERHARDT
 P.O. Box 289
 Elkhorn, Wisconsin 53121

I hereby certify that I have surveyed the above described property, that the plat shown hereon is an accurate survey, a true representation thereof, correctly shows the exterior boundary lines on said property and the correct measurements thereof.

Dated this 31st day of August, 1983.

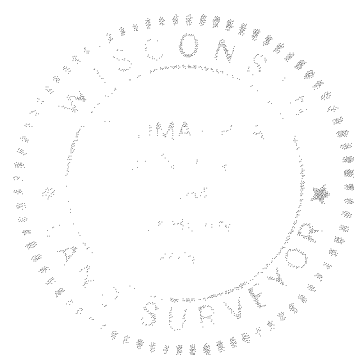

Thomas P.A. Jensen
 THOMAS P.A. JENSEN 5-1084

JENSEN SURVEYING & MAPPING, S.C.
 P.O. Box 322 45 S. Wisconsin Street
 Elkhorn, Wisconsin 53121
 Phone: (414) 723-3434

Note! Garage and House located September 15, 1983.

1983.051

ARS-13

416-325-J 1983.051