
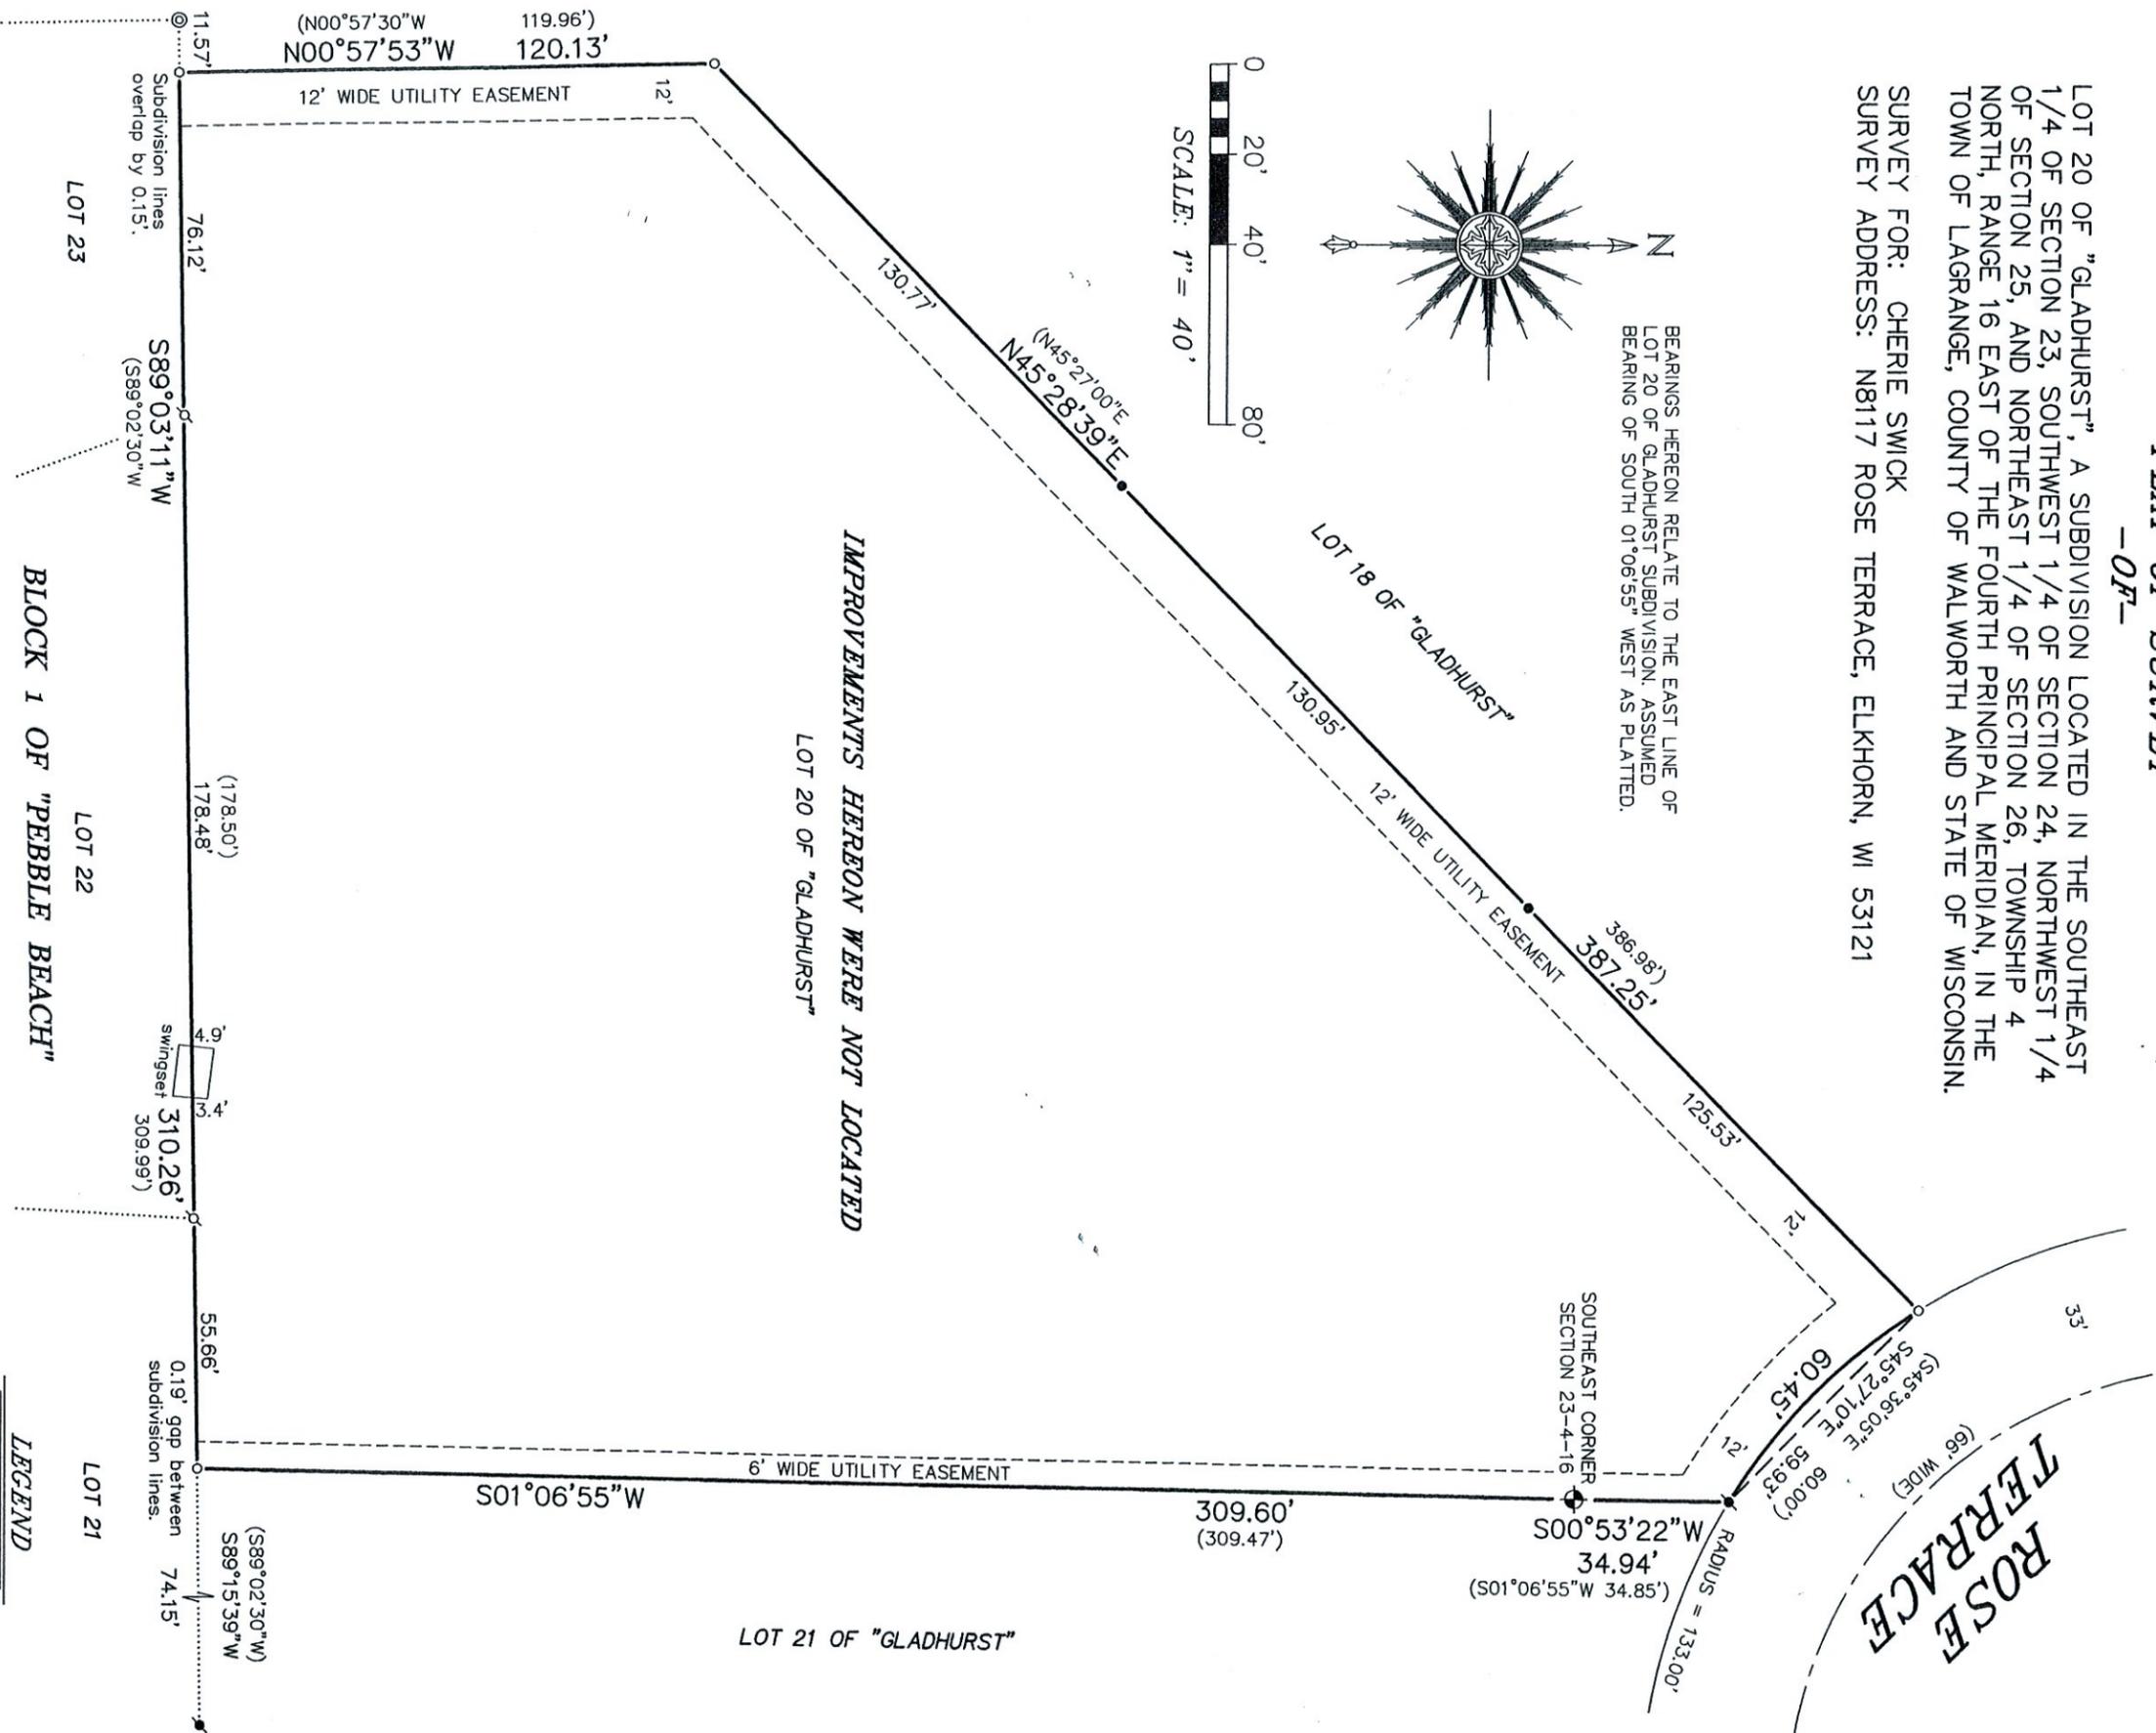


**PLAT OF SURVEY**  
-OF-

LOT 20 OF "GLADHURST", A SUBDIVISION LOCATED IN THE SOUTHEAST 1/4 OF SECTION 23, SOUTHWEST 1/4 OF SECTION 24, NORTHWEST 1/4 OF SECTION 25, AND NORTHEAST 1/4 OF SECTION 26, TOWNSHIP 4 NORTH, RANGE 16 EAST OF THE FOURTH PRINCIPAL MERIDIAN, IN THE TOWN OF LAGRANGE, COUNTY OF WALWORTH AND STATE OF WISCONSIN.

SURVEY FOR: CHERIE SWICK  
SURVEY ADDRESS: N8117 ROSE TERRACE, ELKHORN, WI 53121

BEARINGS HEREON RELATE TO THE EAST LINE OF LOT 20 OF GLADHURST SUBDIVISION. ASSUMED BEARING OF SOUTH 01°06'55" WEST AS PLATTED.

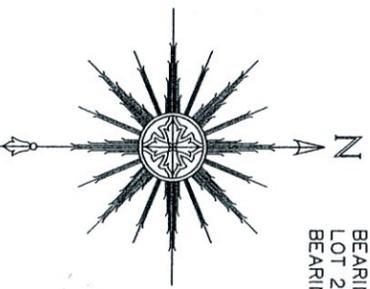

NOTE: REFER TO A CURRENT TITLE REPORT FOR EASEMENTS, RESTRICTIONS OR COVENANTS WHICH MAY AFFECT THE USE OF THIS PROPERTY.

"I HEREBY CERTIFY THAT I HAVE SURVEYED THE ABOVE DESCRIBED PROPERTY AND THAT THE ABOVE MAP IS A CORRECT REPRESENTATION THEREOF AND SHOWS THE SIZE AND LOCATION OF THE PROPERTY, ITS EXTERIOR BOUNDARIES, BOUNDARY FENCES, APPARENT EASEMENTS, ROADWAYS AND ENCROACHMENTS, IF ANY."

"THIS SURVEY IS MADE FOR THE USE OF THE PRESENT OWNERS OF THE PROPERTY, AND THOSE WHO PURCHASE, MORTGAGE, OR GUARANTEE THE TITLE THERETO WITHIN ONE YEAR FROM DATE HEREOF."



- LEGEND**
- ◆ FOUND BRASS CAPPED CONCRETE MONUMENT
  - ⊙ FOUND 2-3/8" O.D. IRON PIPE
  - FOUND 1-5/16" O.D. IRON PIPE
  - ♂ FOUND 1-1/2" O.D. IRON PIPE
  - ♂ FOUND 5/8" DIA. IRON ROD
  - SET 1-5/16" O.D. IRON PIPE
  - ( ) RECORDED AS

**SATTER SURVEYING, LLC**  
LAND SURVEYS, MAPPING AND PLANNING  
272 ORIGEN STREET  
BURLINGTON, WI 53105  
262-661-4239

THIS IS NOT AN ORIGINAL PRINT  
UNLESS THIS SEAL IS RED.

*Thomas L. Satter*  
THOMAS L. SATTER  
S-2850  
JUNE 8, 2021  
DATE  
042113  
JOB NUMBER