


N
Scale: 1"=10'

LEGEND:
● = Found Iron Pipe (FIP)

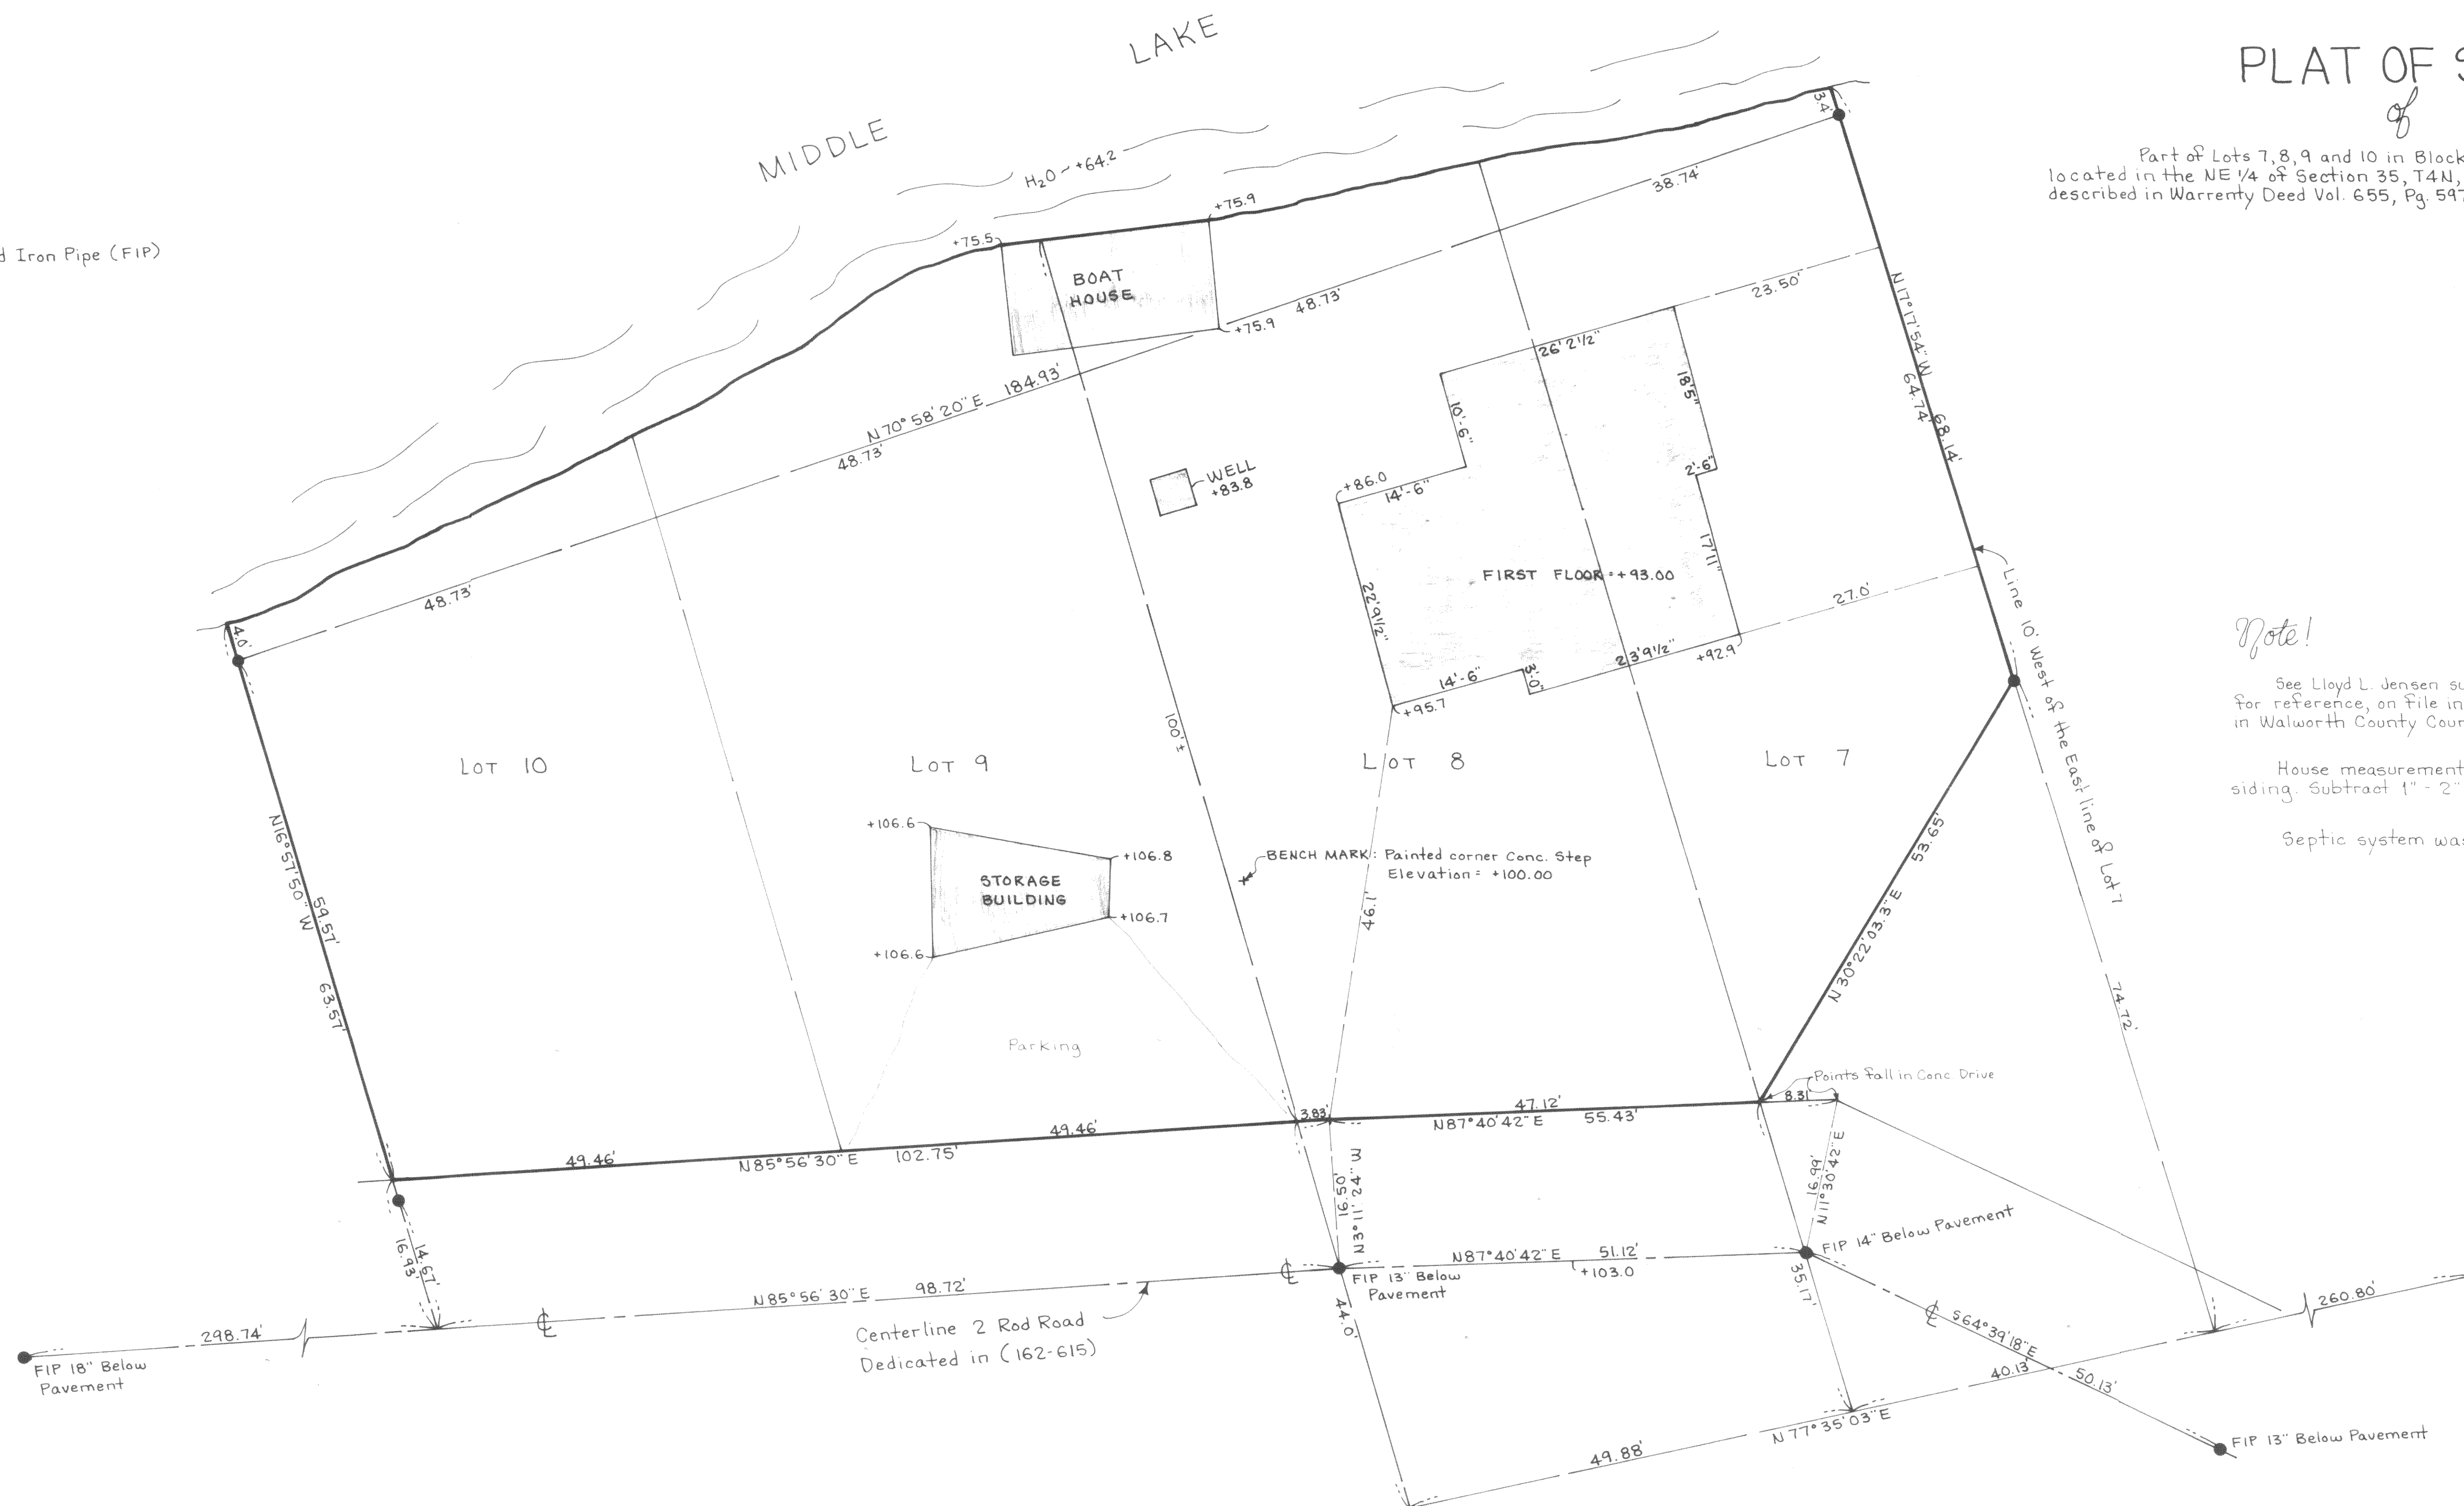

PLAT OF SURVEY

Part of Lots 7, 8, 9 and 10 in Block 2 of CARSWELL'S PARK SUBDIVISION, located in the NE 1/4 of Section 35, T4N, R16E, Walworth County, Wisconsin, as described in Warranty Deed Vol. 655, Pg. 597 Myers to Myers.

Note!

See Lloyd L. Jensen survey and map 416-4, dated May 1935 for reference, on file in Walworth County Surveyor's Office in Walworth County Court House.

House measurements are from wood siding to wood siding. Subtract 1" - 2" to determine foundation.


Septic system was not visible.

I hereby certify that I have surveyed the above described property, that the plat shown hereon is an accurate survey, a true representation thereof, correctly shows the exterior boundary lines on said property and the correct measurements thereof and all buildings thereon.

Dated this 24th day of March, 1984.

Thomas P. A. Jensen
THOMAS P. A. JENSEN
S-1084

JENSEN SURVEYING & MAPPING, S.C.
P.O. Box 322 45 S. Wisconsin St.
Elkhorn, Wisconsin 53121
Phone: (414) 723-3434

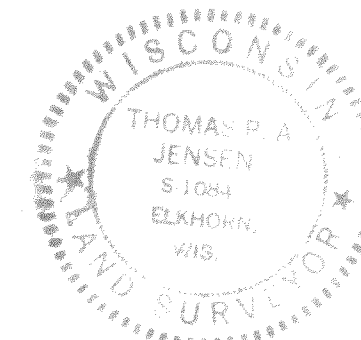

Survey Ordered by: STEVE GUERRANT
824 Prospect
Winnetka, Illinois 60093

Surveyed For: MRS. ARNO R. MYERS JR.
333 Leicester
Kenilworth, Illinois 60043