
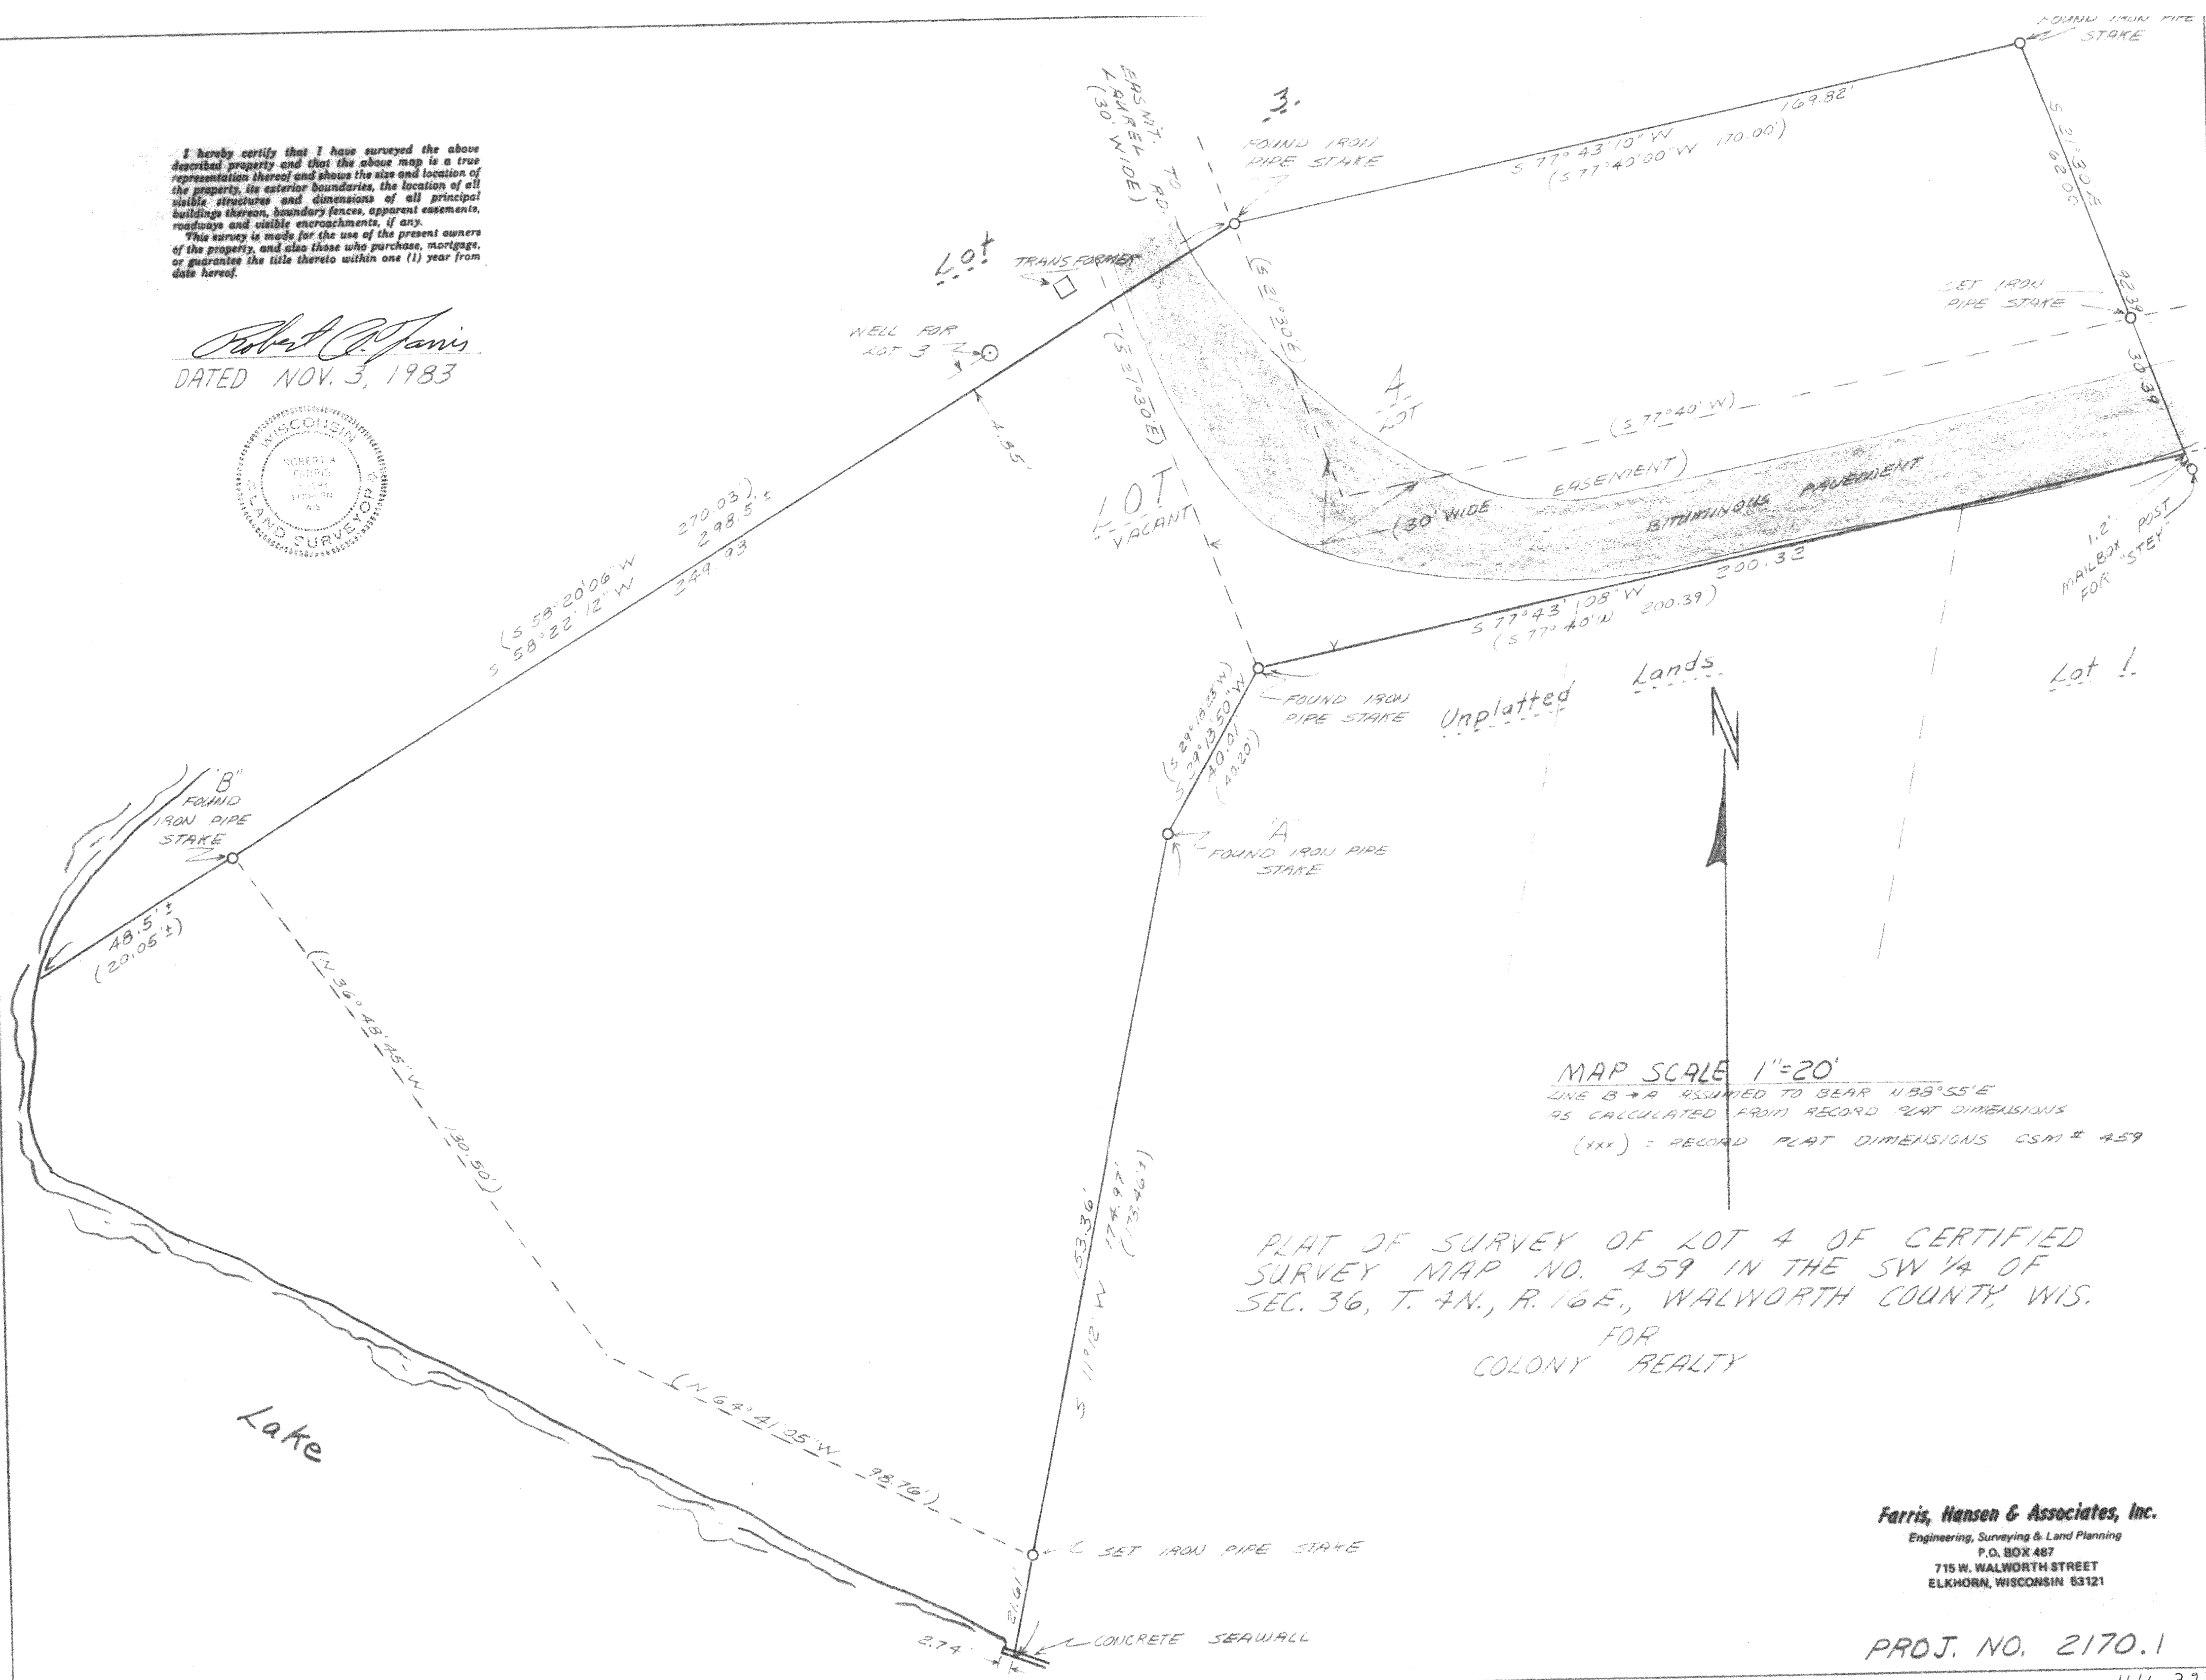


Robert A. Jarvis
DATED NOV. 3, 1983

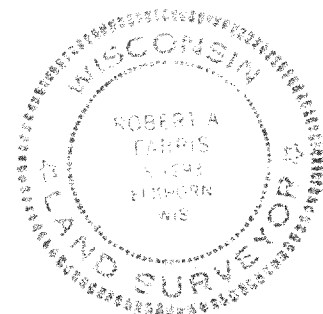

Farris, Hansen & Associates, Inc.
Engineering, Surveying & Land Planning
P.O. BOX 487
715 W. WALWORTH STREET
ELKHORN, WISCONSIN 53121

PROJ. NO. 2170.1