

PLAT OF SURVEY



OF

LOT 5, BLOCK 1 OF COOL HILL PARK, A SUBDIVISION
LOCATED IN THE NW 1/4 AND THE SW 1/4 OF SECTION 35, T4N, R16E, WALWORTH
COUNTY, WISCONSIN.

SURVEYED FOR:
LANHAM REALTY
39 W. WASHINGTON ST.
ELKHORN, WI, 53121

SURVEYED BY:
JENSEN SURVEYING & MAPPING, S.C.
P.O. BOX 322
ELKHORN, WI. 53121
PHONE: (414) 723-3434

MAPPING DATE:
APRIL 25, 1984
REVISED MAY 9, 1984

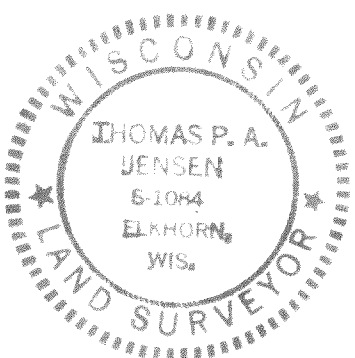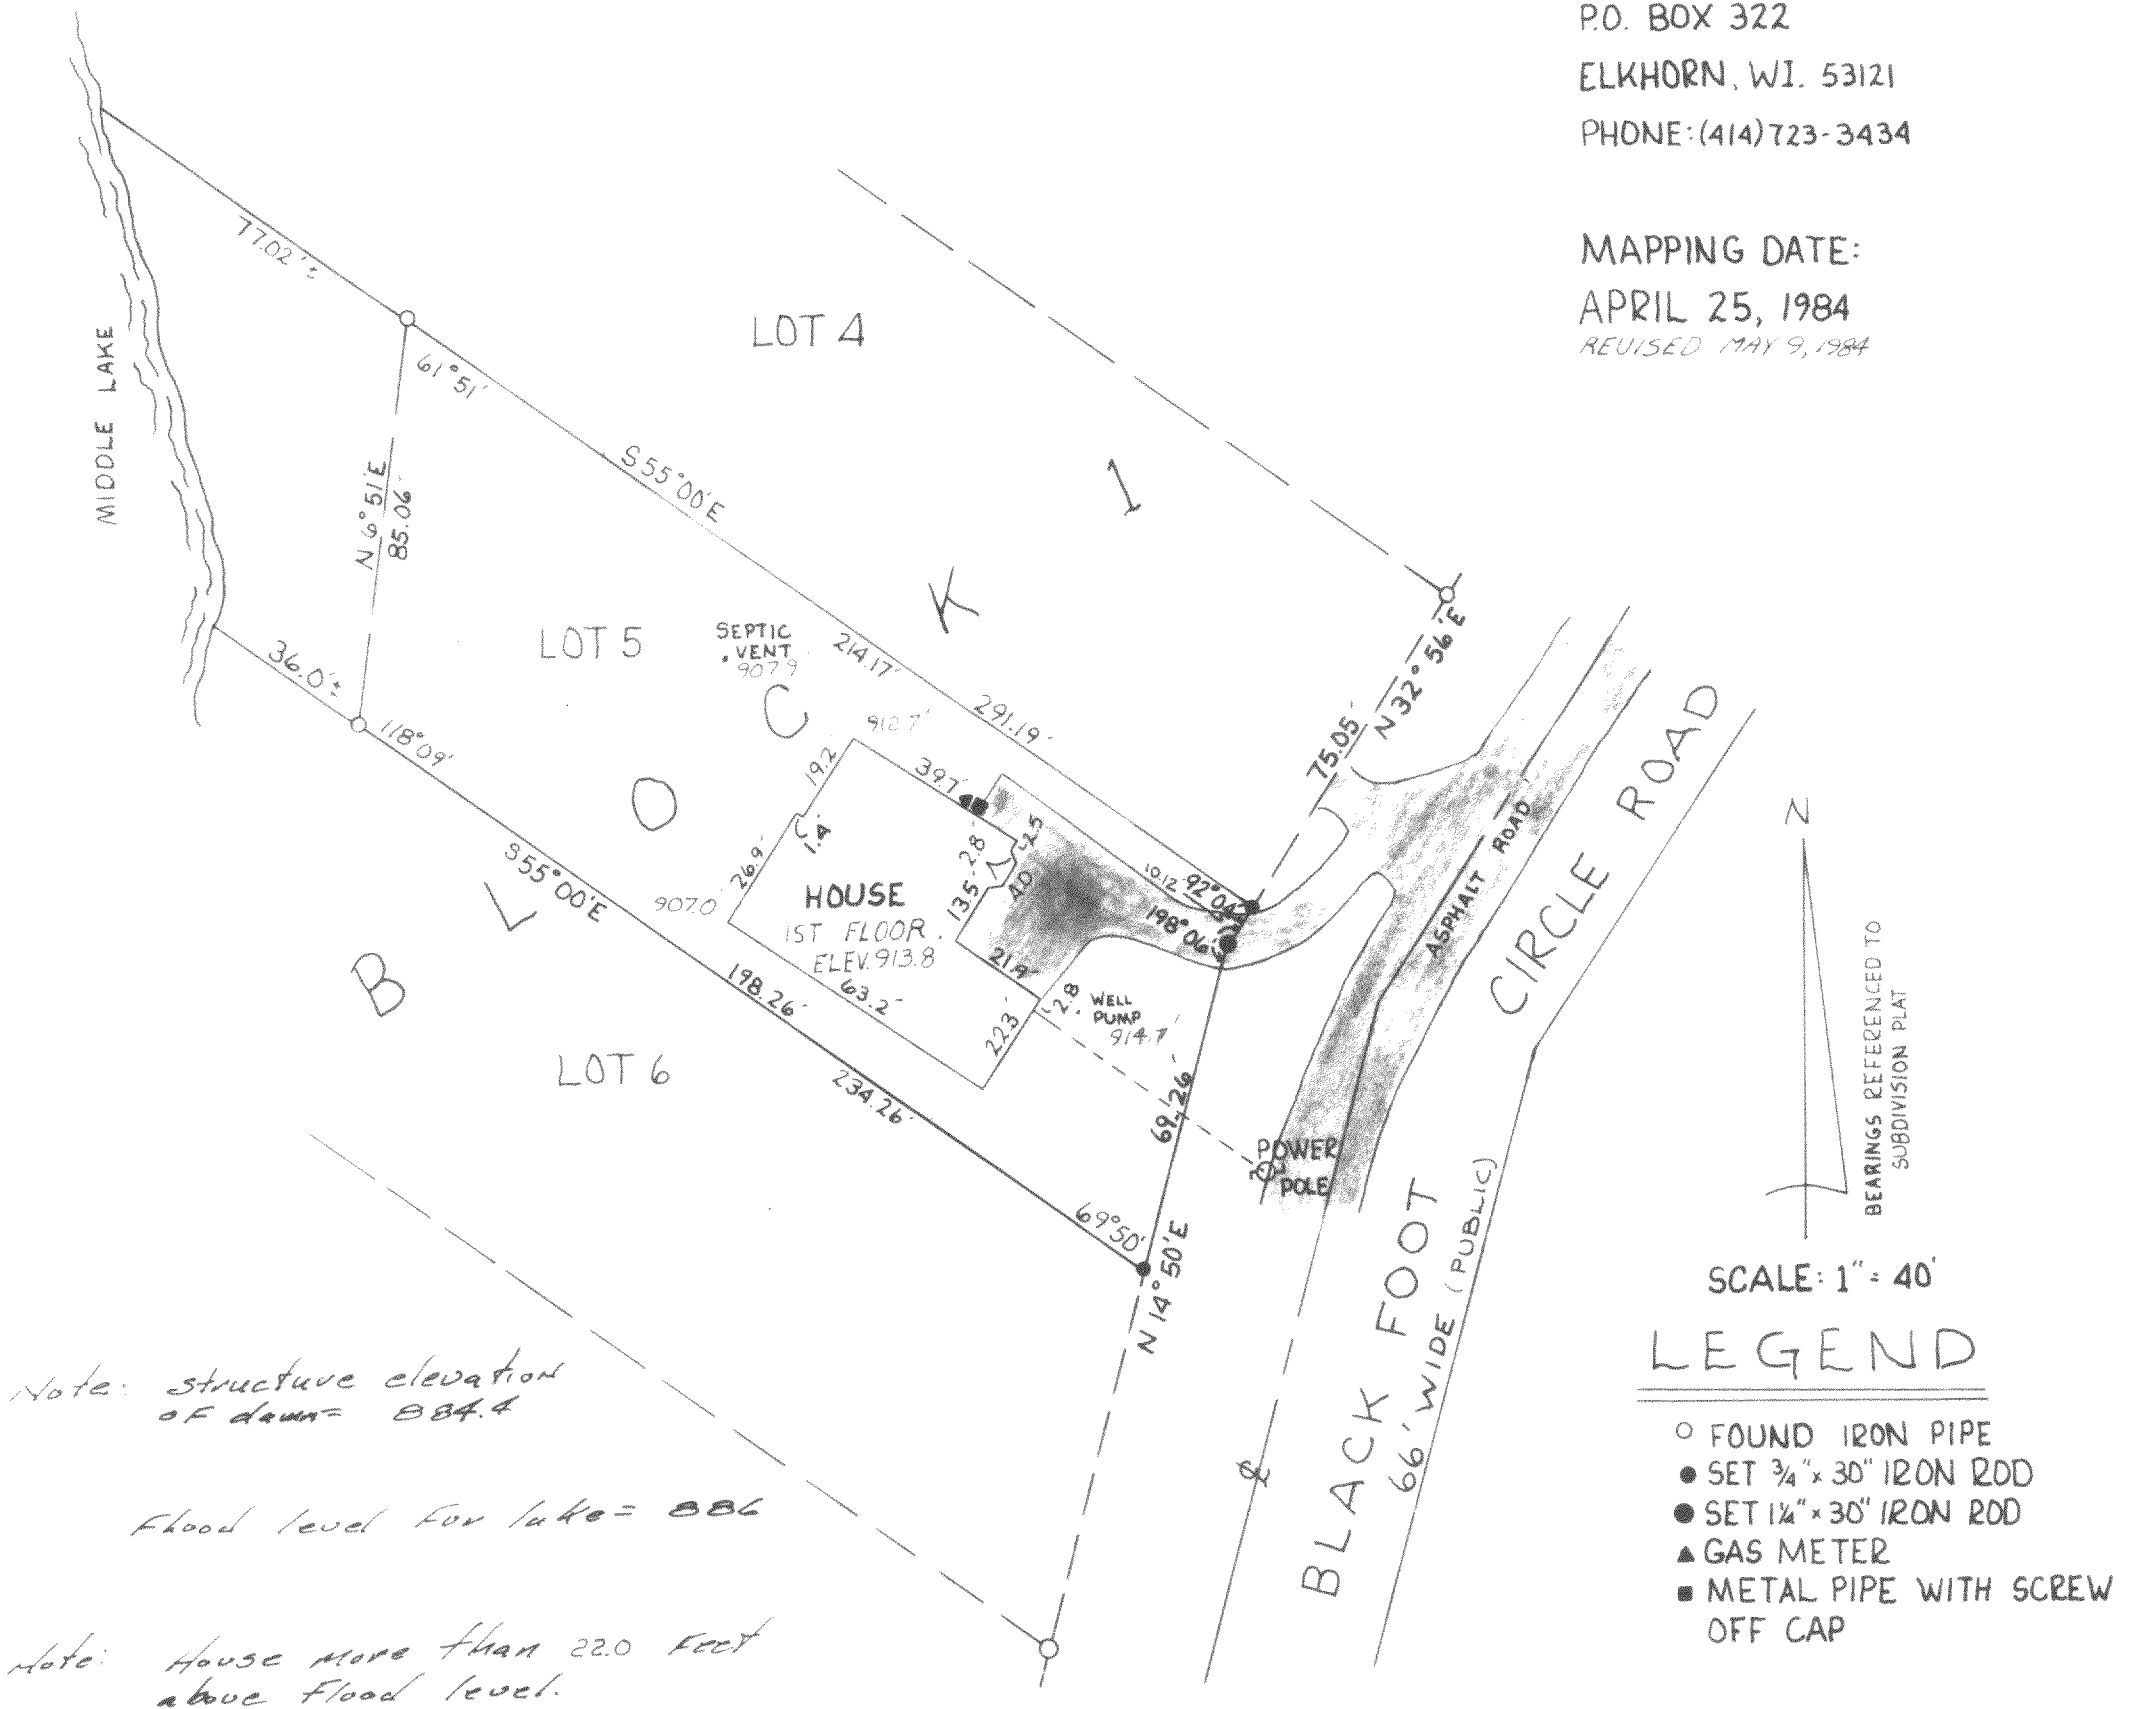

I HEREBY CERTIFY THAT THE ABOVE DESCRIBED PROPERTY HAS
BEEN SURVEYED UNDER MY DIRECTION, THAT THE PLAT SHOWN HERON
IS AN ACCURATE SURVEY, A TRUE REPRESENTATION THEREOF, CORRECTLY
SHOWS THE EXTERIOR BOUNDARY LINES ON SAID PROPERTY AND THE CORRECT
MEASUREMENTS THEREOF AND THE BUILDINGS THEREON.

Thomas P. A. Jensen

THOMAS P.A. JENSEN

RLS. NO. 1084

416-328-J

1984.023A

HCW-5