


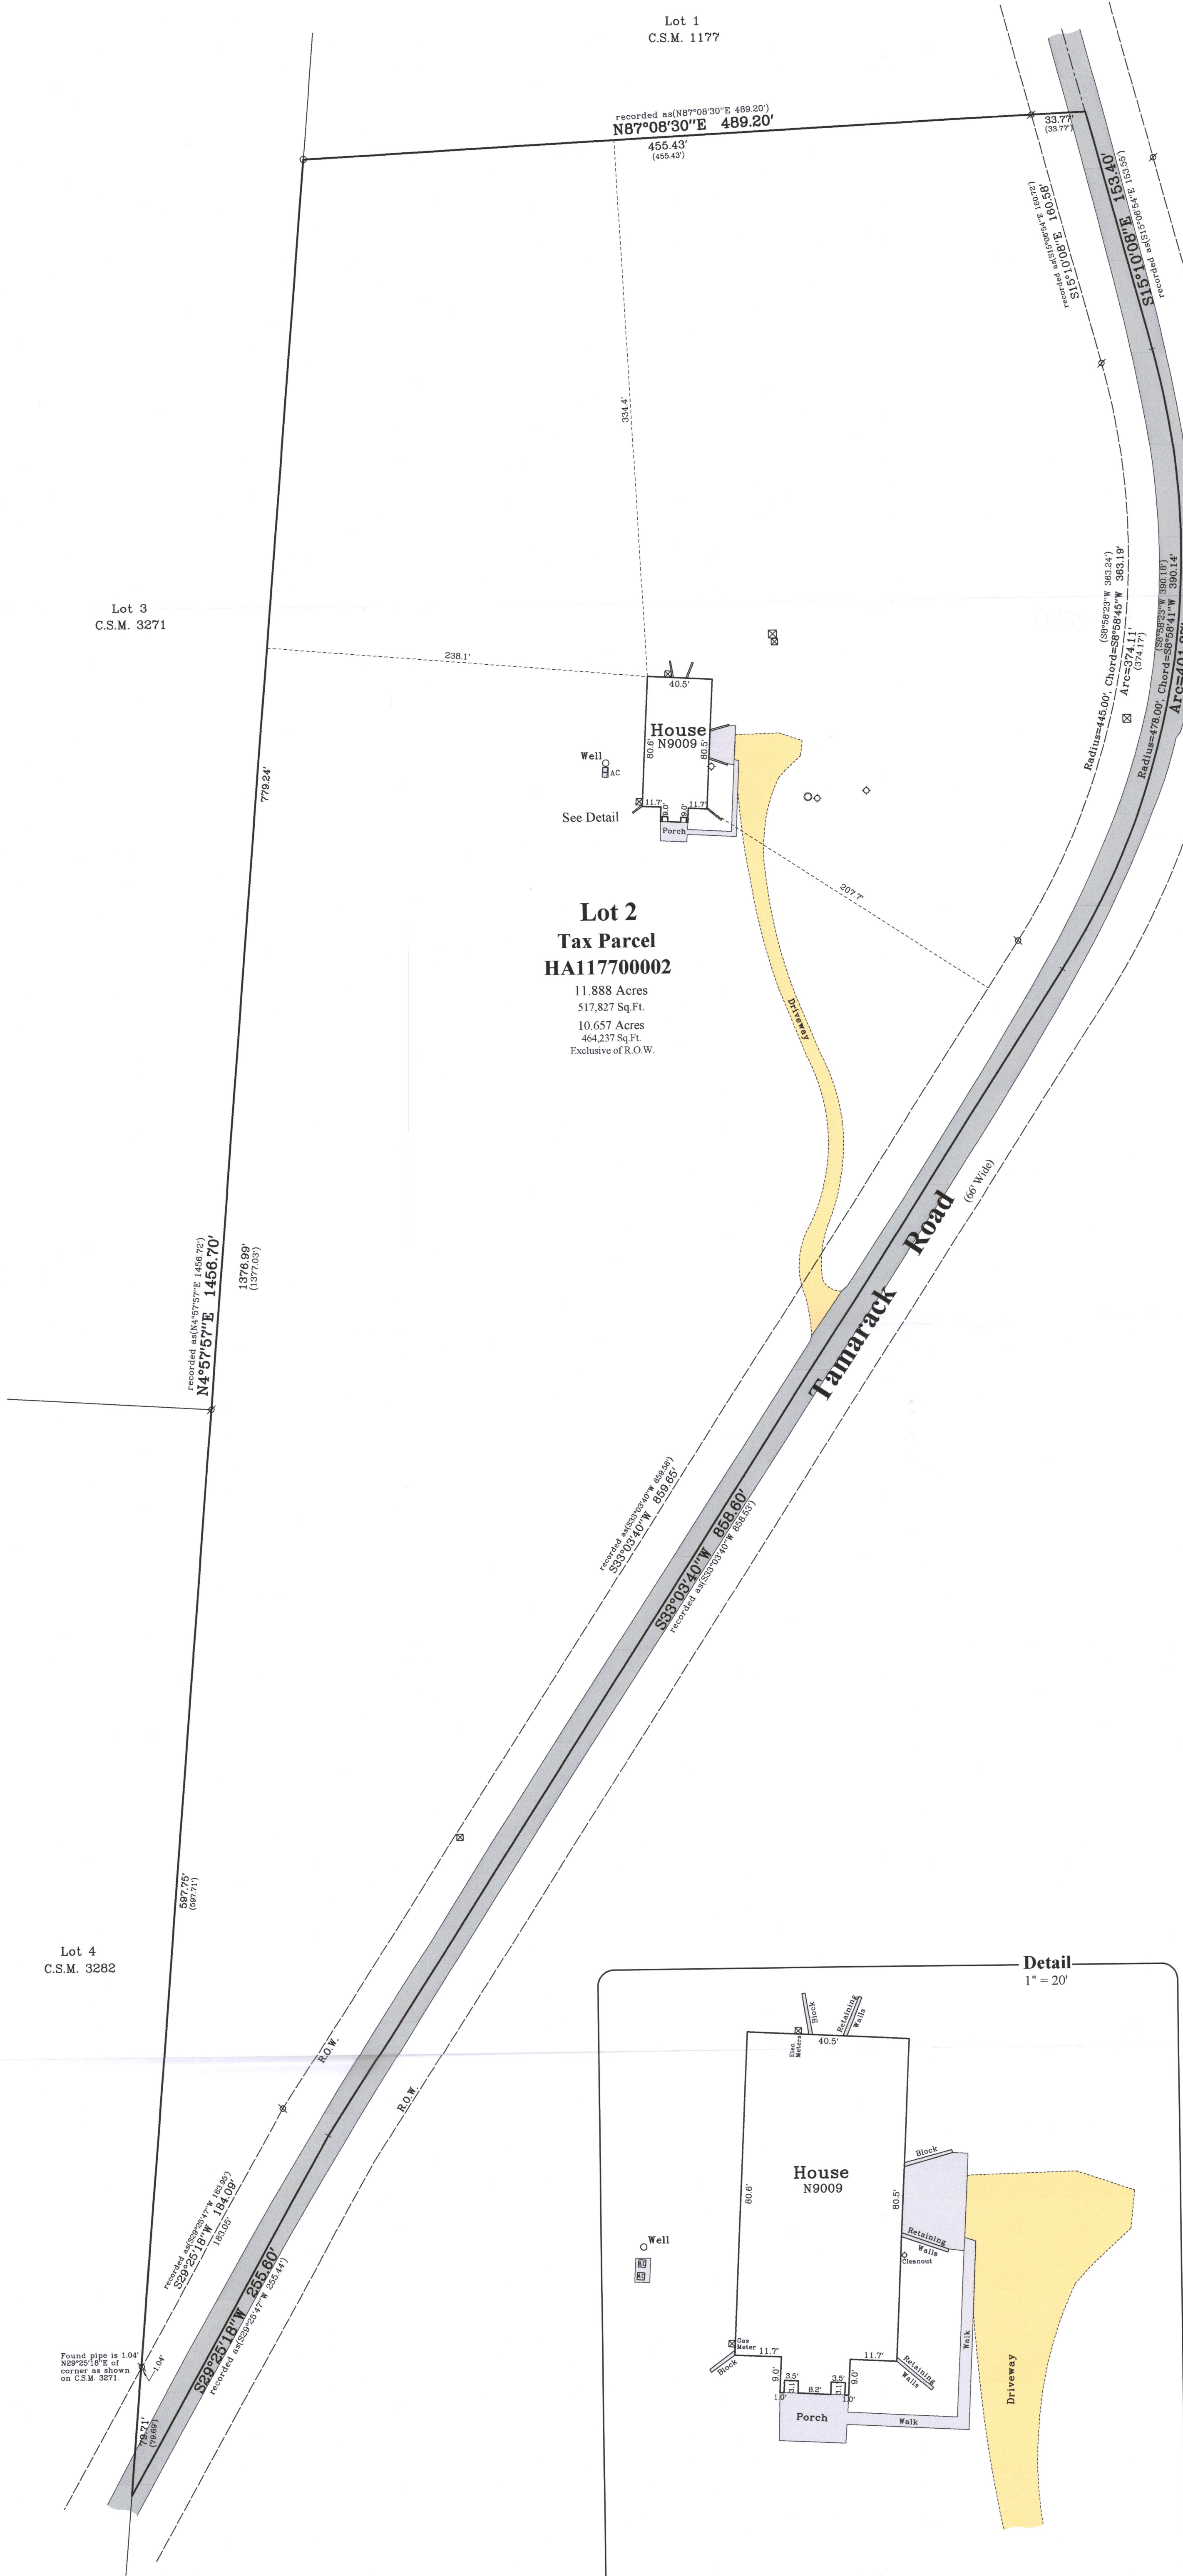


Whitetail Trail

Plat of Survey


of

Lot 2 of Certified Survey Map No. 1177,
recorded in Vol. 5 of Certified Survey Maps of Walworth County on Page 242
and located in the Northeast 1/4 and the Southeast 1/4 of the Southwest 1/4
of Section 11, Town 4 North, Range 16 East, Town of LaGrange, Walworth
County, Wisconsin.


Surveyed for: **Keefe Real Estate, Inc.**
204 East Commerce Court
Elkhorn, Wisconsin. 53121

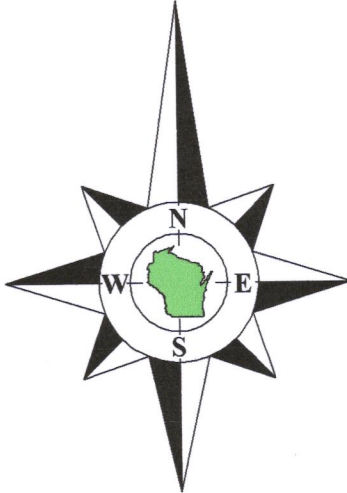

Bearings referenced to the West line of Certified Survey Map No. 1177,
recorded as N4°57'37"E. An approximate rotation of 4°11'32" from the
Wisconsin State Plane Coordinate System, South Zone, (NAD-27).

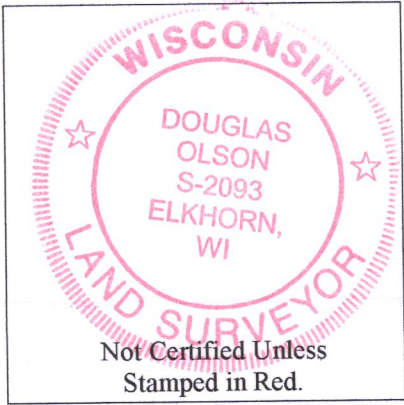

- Notes:**
- 1) This Plat of Survey is not certified unless signed and sealed in red ink.
 - 2) This survey is subject to Wisconsin lien laws. This Plat of Survey is the notice of intent to file lien. Lien waiver required.
 - 3) The Survey Date shown on this Plat of Survey is the completion date of the field work.

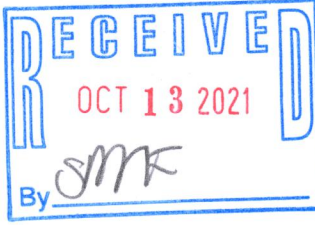

Copyright © 2021 by Olson Land Surveying, LLC.

All rights reserved. No part of this survey plat may be reproduced or transmitted in any form by any means - graphic, electronic, or mechanical, including photocopying, tracing, or information storage and retrieval systems - without permission in writing from Douglas G. Olson, Olson Land Surveying, LLC.

I hereby certify that I have surveyed the above described property in compliance with Chapter A-E 7 of the Wisconsin Administrative Code and that the map hereon is correct to the best of my professional knowledge and belief and shows the size and location of the property, its exterior boundaries, the location and dimensions of all visible structures thereon, boundary fences, apparent easements and roadways and visible encroachments, if any.
This survey is made for the exclusive use of the present owners of the property, and also those who purchase, mortgage or guarantee title thereto, within one year from the date hereof.

Douglas G. Olson
Wisconsin Professional Land Surveyor - 2093

Sheet 1 of 1 Sheets

Drawing Name:

Job Reference Number

2021.088

Legend of Symbols & Abbreviations

Found County Section Corner

Found Iron Pipe

Found Iron Rod

Set Iron Pipe, 1" dia.

Recorded Information

Utility Pole

Utility Box or Pedestal

Concrete Cover

Septic Vent

Gravel Surface

Concrete Surface

Gravel Surface

Brick Pavers

N North

S South

E East

W West

In Bearings

Degrees

Minutes

Seconds

In Distances

Feet

No. Number

NW Northwest

NE Northeast

Dis. Diameter

OLSON

LAND SURVEYING, LLC

Rural | Residential | Commercial

45 South Wisconsin Street | P.O. Box 322

Elkhorn, Wisconsin. 53121

Telephone: (262) 723-3434

Facsimile: (262) 723-8044

Email: doug@olsonsurveying.com

Website: www.olsonsurveying.com

Scale in Feet

1" = 50'

0'

25'

50'

100'

150'

Survey date: August 13, 2021.
Revisions:

416-8329