


DUNHAM SURVEYING, S.C.
SURVEYING & SUBDIVIDING
DELAVAN, WISCONSIN 53115

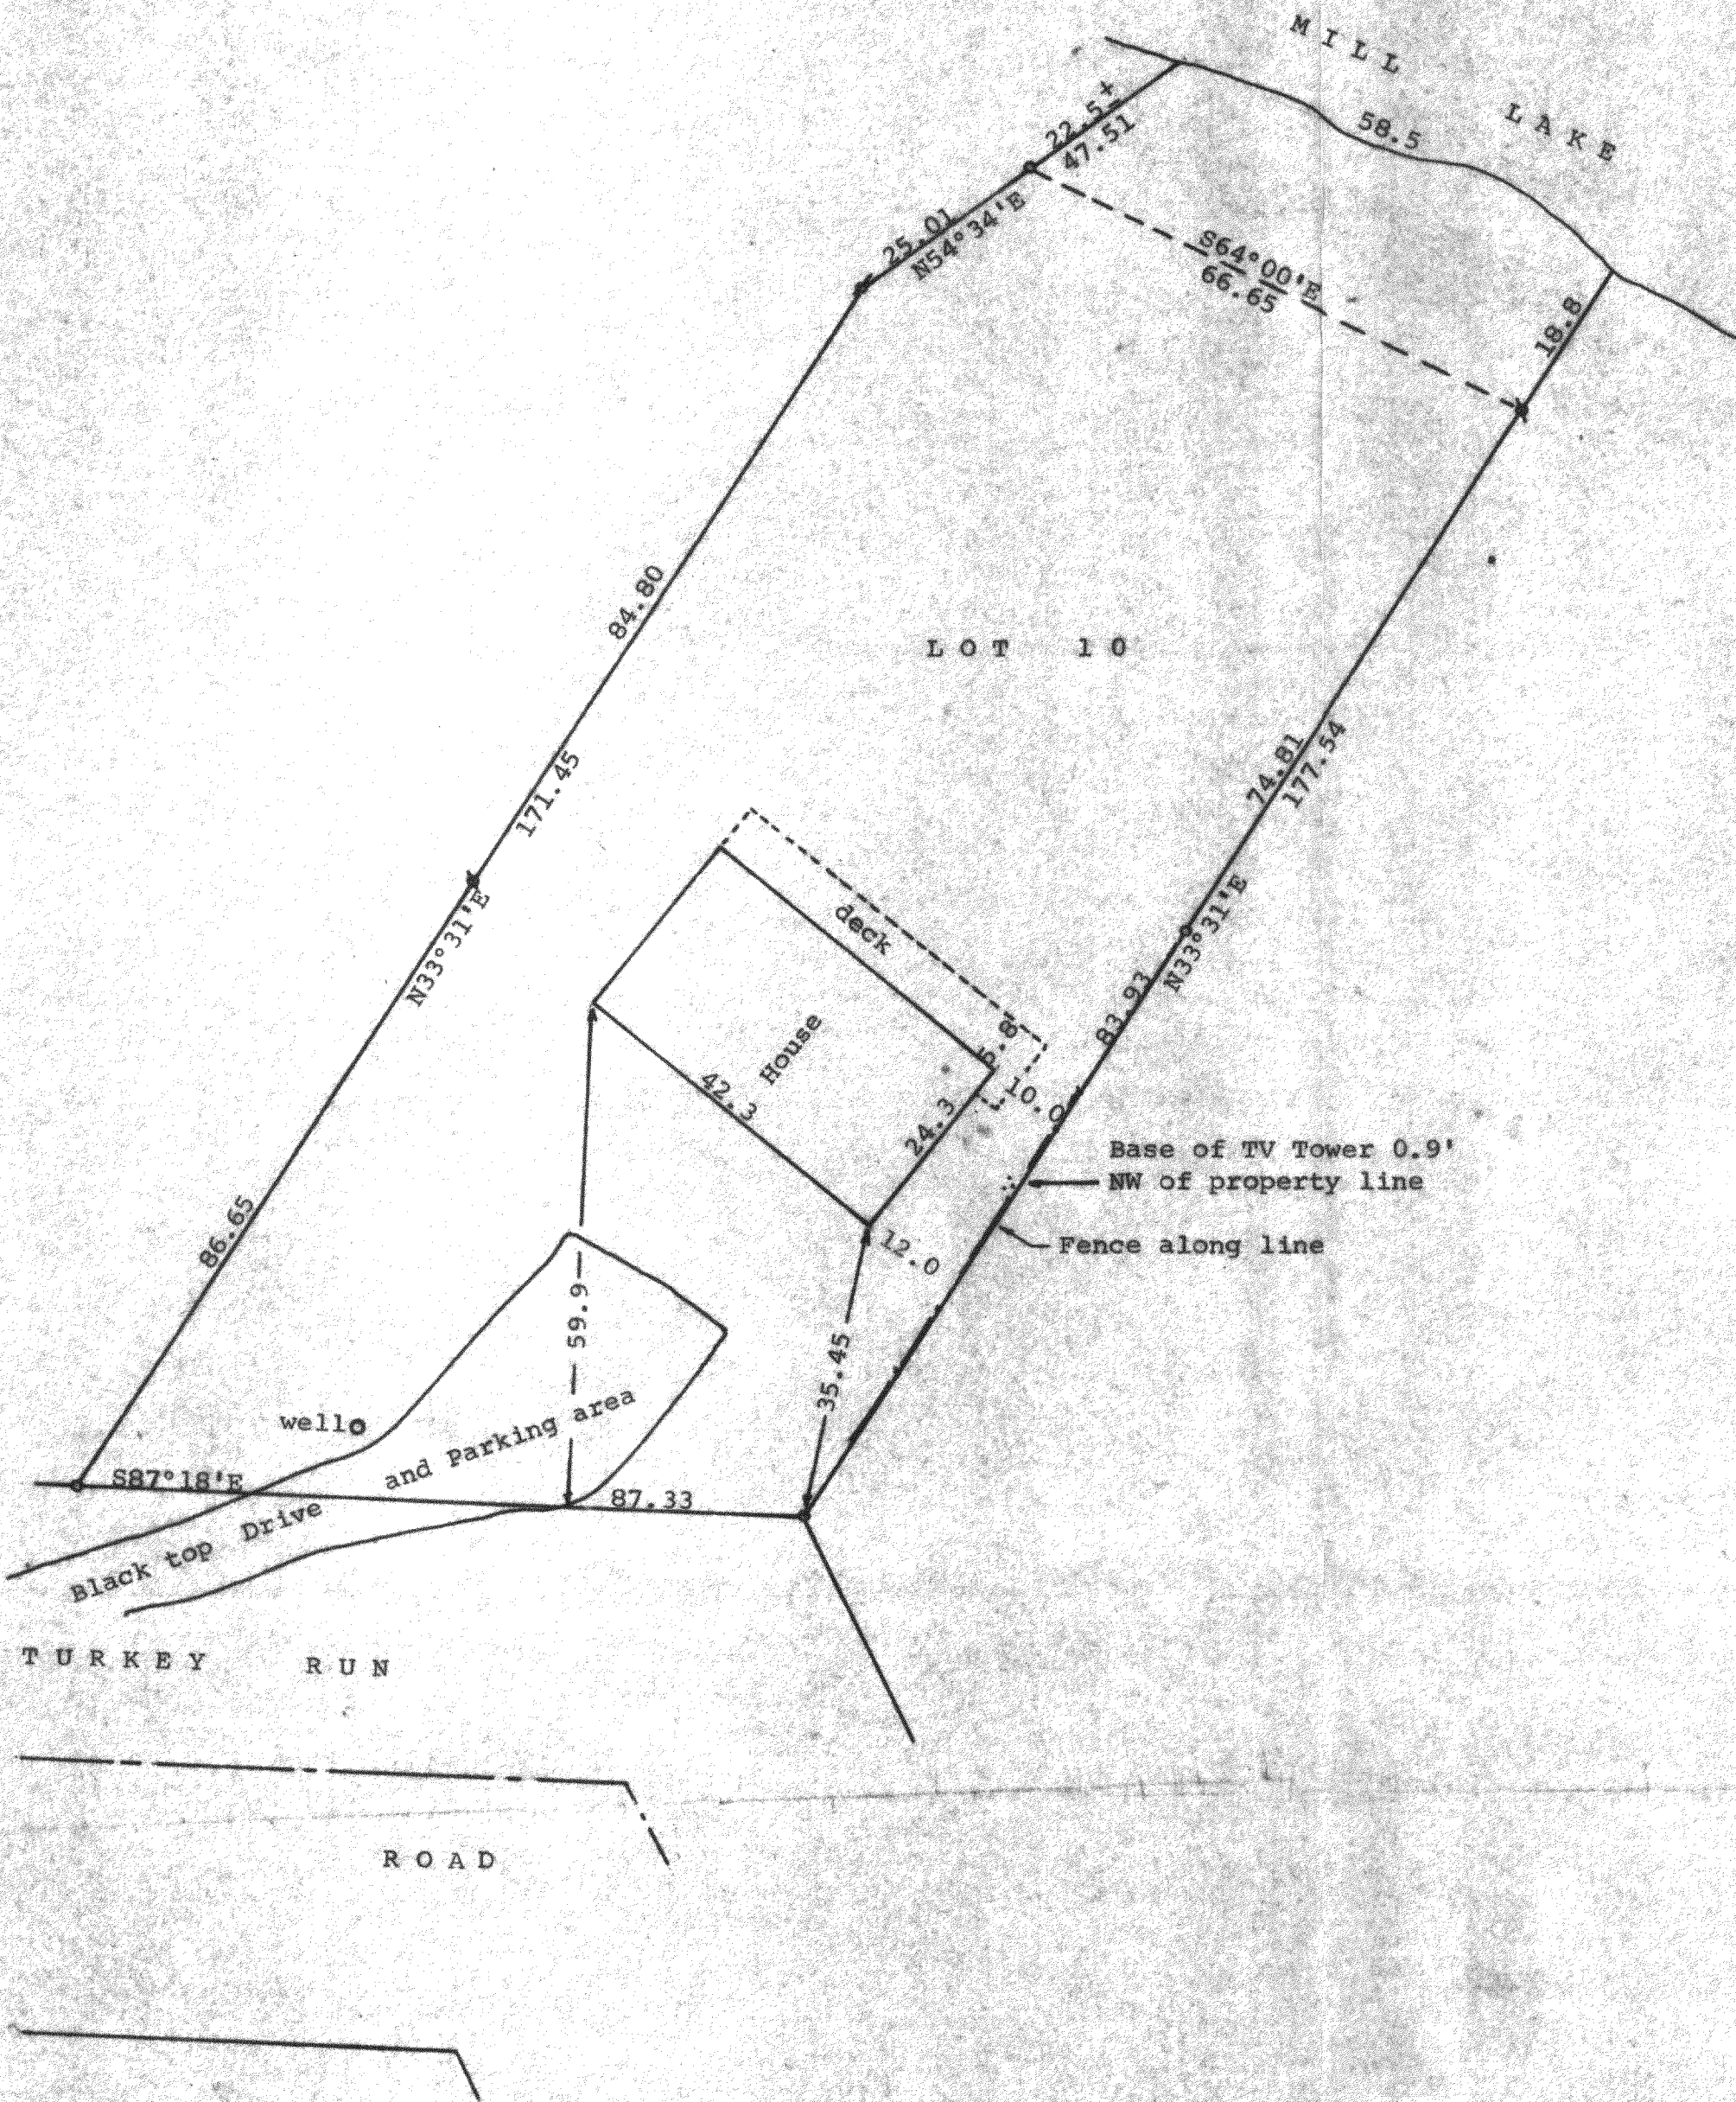

Scale - 1" = 20'

o = 1" Iron Pipe Found

⌘ = 3/4" Iron Pipe Found

⌘ = 1 1/4" Iron Pipe Found

Bearings used are those of record.

Owner: Gerald Vannoy

STATE OF WISCONSIN) SS
COUNTY OF WALWORTH)

I, George T. Dunham, Surveyor, certify that I have surveyed the property described as follows:

Lot 10 of Arrowhead Park, a subdivision located in Government Lot 3 in the Northwest 1/4 of the Southeast 1/4 of Section 35, T 4 N, R 16 E, Walworth County, Wisconsin, and that the plat shown above is a true representation thereof and shows the size and location of the property, its exterior boundaries, the location of boundary fences, apparent easements, roadways and visible encroachments, if any, and that I have surveyed the property hereon described according to the official records to the best of my knowledge and belief.

April 10, 1984

George T. Dunham
George T. Dunham, Surveyor

