


PLAT OF SURVEY – GARAGE ASBUILT PART OF LOT 5 & LOT 6 OF MORRIS PARK SUBDIVISION

LOCATED IN PART OF THE NW 1/4 OF THE SW 1/4
OF SECTION 26, TOWN 4 NORTH, RANGE 16 EAST,
TOWN OF LAGRANGE, WALWORTH COUNTY, WISCONSIN

WEST SHORE
DRIVE

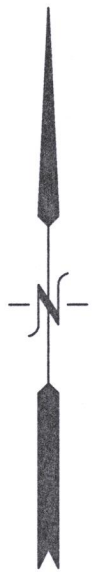

BENCHMARK: SET
NAIL IN UTILITY POLE
ELEV=913.44

LOT 6

LANDS
SURVEYED
21,056 SQ. FT.
(0.48 ACRES)

LOT 5

GREEN LAKE

NOTE: COPIES OF THIS MAP TO WHICH THE FOLLOWING CERTIFICATE WILL APPLY SHOW
THE SURVEYOR'S ORIGINAL SEAL AND SIGNATURE IN RED INK. COPIES BY ANY OTHER
MEANS MAY HAVE ALTERATIONS WHICH DO NOT REPRESENT THE SURVEYOR'S WORK
PRODUCT.

I HEREBY CERTIFY THAT THE ABOVE DESCRIBED PROPERTY HAS BEEN SURVEYED
UNDER MY DIRECTION AND THAT THE ABOVE MAP IS A TRUE REPRESENTATION
THEREOF AND SHOWS THE SIZE AND LOCATION OF THE PROPERTY AND ITS EXTERIOR
BOUNDARIES. THIS SURVEY IS MADE FOR THE USE OF THE PRESENT OWNERS OF THE
PROPERTY, AND ALSO THOSE WHO PURCHASE, MORTGAGE, OR GUARANTEE THE TITLE
THERE TO WITHIN ONE YEAR FROM THE DATE HEREOF.

DATED: 07/21/2020

REV: 10-1-21 ASBUILT GARAGE

CHRISTOPHER A. HODGES P.L.S. S-2760



PERMIT PLAT
N7898 WEST SHORE DRIVE
ELKHORN, WI 53121

WORK ORDERED BY –
THELEN TOTAL CONSTRUCTION
P.O. BOX 17
ELKHORN, WI 53121

FARRIS, HANSEN & ASSOCIATES, INC.
ENGINEERING – ARCHITECTURE – SURVEYING
7 RIDGWAY COURT P.O. BOX 437
ELKHORN, WISCONSIN 53121
OFFICE: (262) 723-2098 FAX: (262) 723-5886

REVISIONS
05/18/2020 – LB
PREP. WORK

06/22/2020 – LB
TOPO. SURVEY

07/21/2020 – LB
PERMIT

8-9-21
Locate Drywell

6/14/21
Rev Garage 30' wide

7-19-21
GARAGE DRIVE &
GRAVEL TO SEED

PROJECT NO.
10269

DATE:
05/18/2020

SHEET NO.
1 OF 1

X:\PROJECTS\10269\ACAD\10269.DWG

HMP-4

416-3307