

MIDDLE LAKE
WATER ELEV.=884.5'

FEMA FLOODPLAIN LINE
PER PANEL 55127C00065D
DATED 10/2/2009
ELEV.=885.6'
(RUNS ALONG SHORELINE)

WOOD DECK

SET 3/4" REBAR N 24°06' E,
0.31' FROM MEANDER CORNER

Scale: 1" = 10'

DISTANCE UNITS BASED ON THE UNITED STATES SURVEY FOOT

BEARINGS BASED ON THE WISCONSIN COUNTY COORDINATE
SYSTEM, WALWORTH ZONE. THE EAST LINE OF LOT 118
BEARING S 0°57'02" E

VERTICAL DATUM BASED ON NAVD-88 (2012)

PLAT OF SURVEY



LOT 118 OF BUBBLING SPRINGS SUBDIVISION
2nd ADDITION, T. 4 N., R. 16 E., OF THE 4TH P.M.,
WALWORTH COUNTY, WISCONSIN

MONUMENT KEY

- Iron Rebar Set
3/4" x 24" (1.5 Lbs./Ft.)
- ⊙ Iron Pipe Found
- Nail w/ Washer Set
- Bolt Found
- (XXX.XX) Record Information

LEGEND

- Existing Telephone Pedestal
- OH — Existing Overhead Power
- ⊙ Existing Utility Pole
- ⊙ Existing Utility Vault
- PW Existing Well
- ST Existing Septic Tank
- ⊙ Existing Septic Vent
- ⊙ Deciduous Tree
- X — Existing Fence
- ⊙ Existing Flag Pole
- ⊙ Existing Mailbox

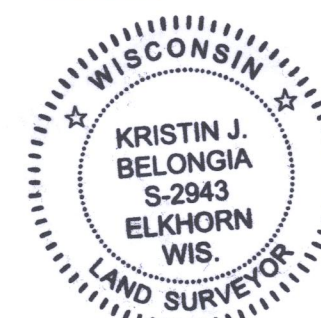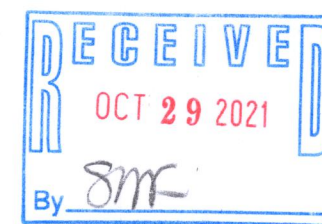

Kristin J. Belongia, P.L.S.
Wisconsin Professional Land Surveyor S-2943

State of Wisconsin } ss
County of Rock

If the surveyor's signature is not red in color,
the plan is a copy that should be assumed to
contain unauthorized alterations.
The certification contained on this document
shall not apply to any copies.

I hereby certify that I have supervised the survey of the property described above and to the best
my knowledge and belief, the plat drawn hereon complies with Chapter A-E 7 of the State of
Wisconsin Administrative Code, Minimum Standards for Property Surveys and correctly
represents said survey and its location.
Given under my hand and seal this 29th day of September, 2021 at Beloit, Wisconsin.
Last day of field work September 21, 2021.
Revised October 14, 2021 to show setback information.

ORDER NO: 34048

BOOK: SEE FILE
FIELD CREW: DGM
DRAWN BY: KJB
SHEET 1 OF 1

FOR THE EXCLUSIVE USE OF:

ANTHONY & KRISTIE JACKSON
W5702 NORTH DRIVE
ELKHORN, WI 53121

PLAT OF SURVEY

Batterman
engineers surveyors planners

2857 Bartells Drive
Beloit, Wisconsin 53511
608.365.4464
www.rhbatterman.com

