


FARRIS, HANSEN & ASSOCIATES, INC.  
7 RIDGEWAY COURT, ELKHORN, WIS.  
414-723-2098

UNPLATTED LANDS

ENCROACHMENT  
VISIBLE DRAIN TILE OUTLET  
SAID TO BELONG TO  
OWNER NORTH OF LOT 1

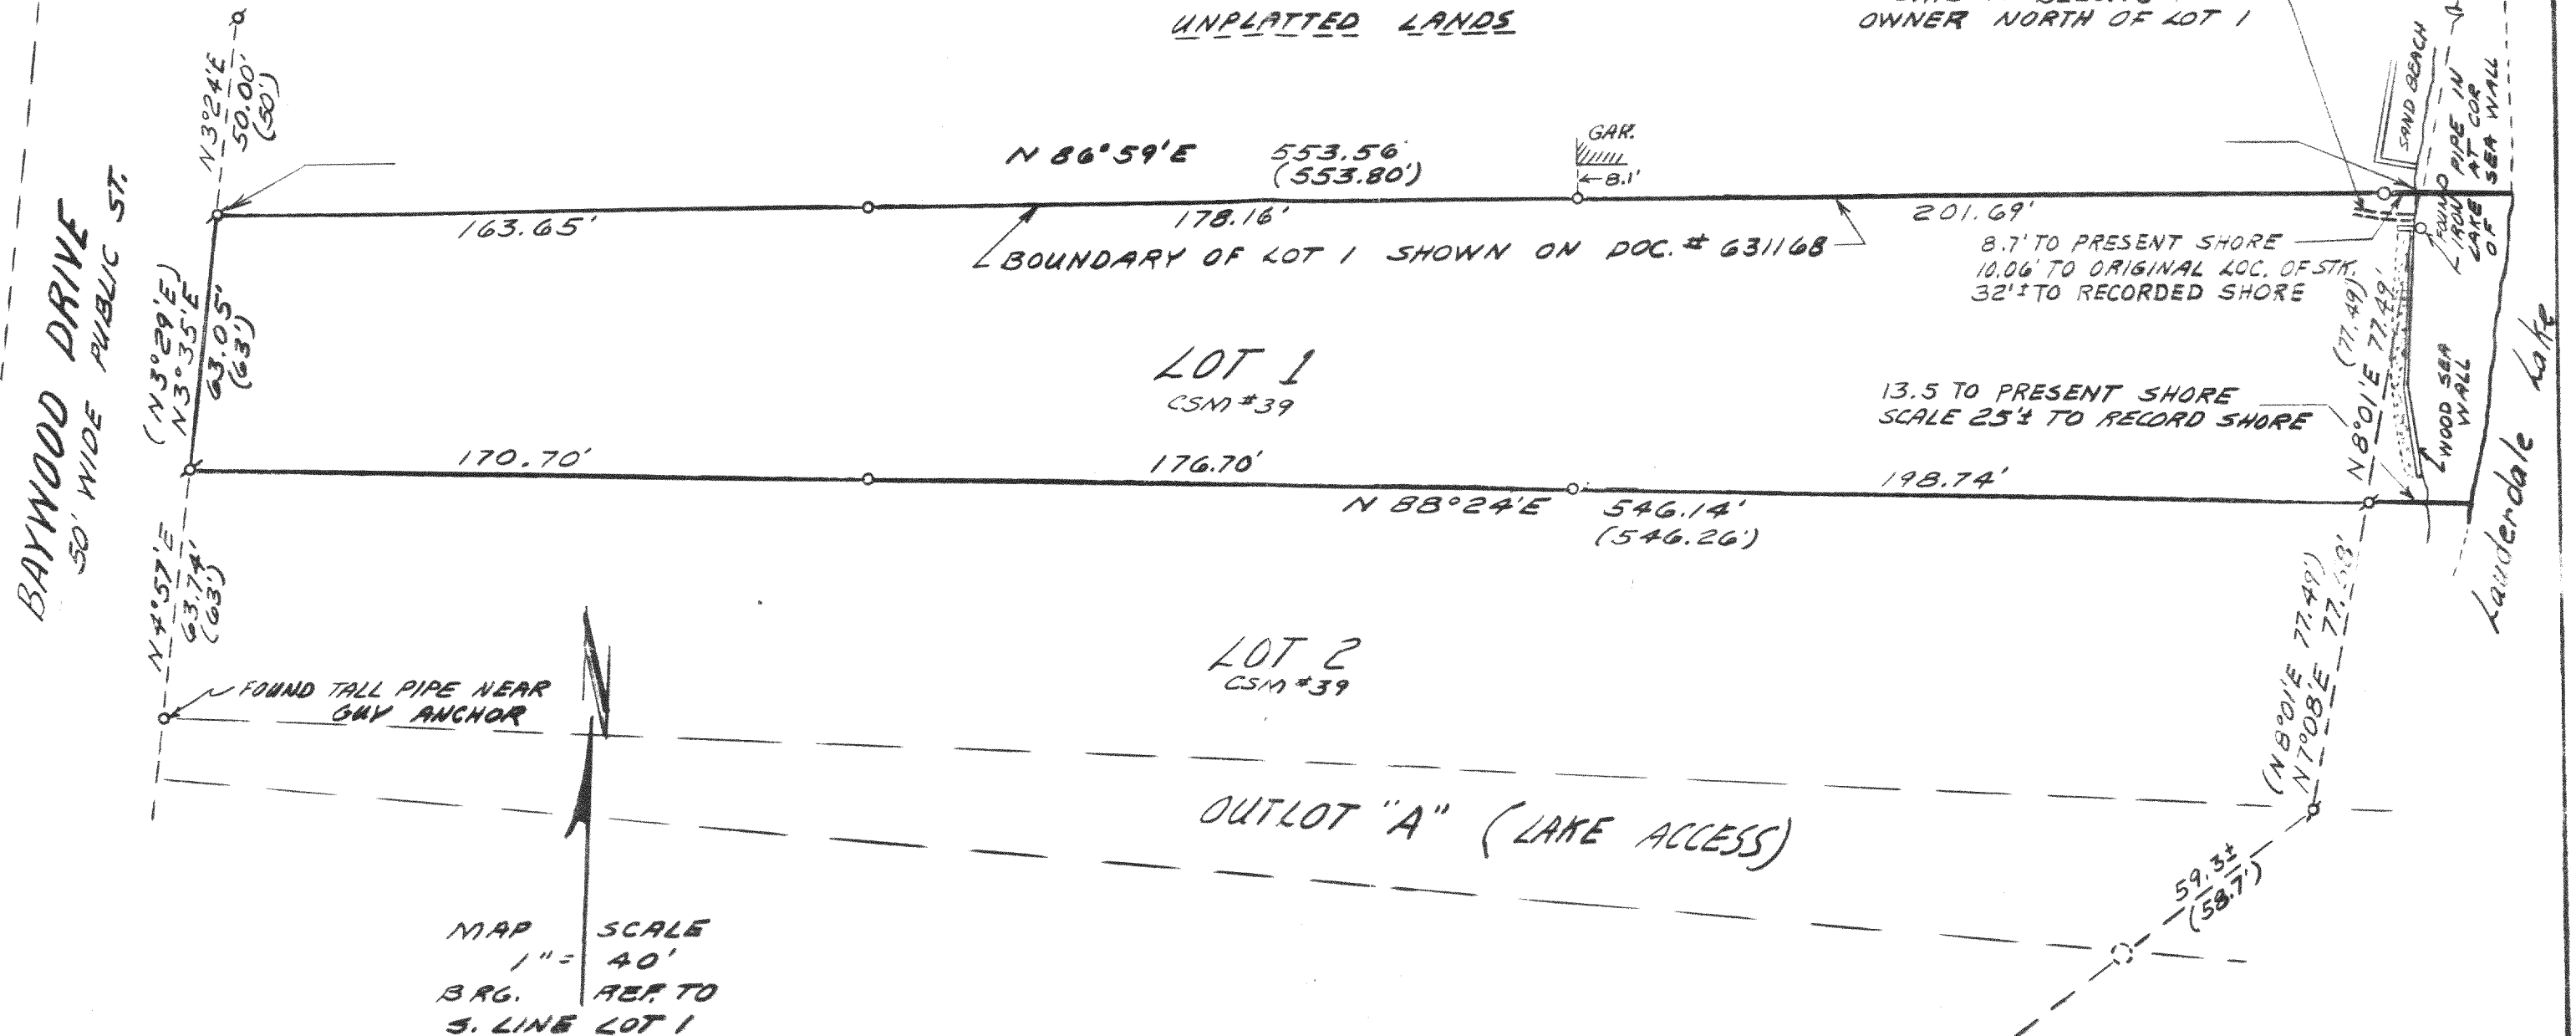


PLAT OF SURVEY LOT 1 CSM # 39 ACCORDING  
TO THE ORIGINAL PLAT RECORDED IN VOL. 1 OF  
CSM'S PAGE 39 AS DOC. # 631168

WORK ORDERED BY: FRANCES FLOOD

I HEREBY CERTIFY THAT THIS PLAT IS A TRUE AND ACCURATE  
REPRESENTATION OF THE BOUNDARY LINES OF THE ABOVE  
DESCRIBED PROPERTY TO THE BEST OF MY PROFESSIONAL  
KNOWLEDGE AND BELIEF.

Robert A. Farris  
DATED APR. 11, 1985

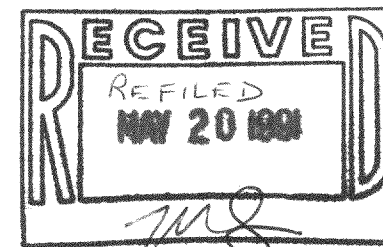

1<sup>ST</sup> COPY FILED ON 7-30-85 (LOST)

Legend  
Ø = FOUND IRON PIPE STAKE  
O = SET IRON PIPE STAKE 1"X24"  
⊙ = METAL DETECTOR INDICATES IRON  
OBJECT BENEATH SOO  
(xxx) = RECORDED DIMENSION  
xxx = MEASURED DIMENSION

TAX KEY # HA - 39 - 1

PROJECT NO. 2379

SURVEY # 416 - 340 F

RECEIVED  
JUL 30 1985  
GK. L

FOUND PIPE IN LAKE (DISTURBED) ~~OK~~

ENCROACHMENT  
VISIBLE DRAIN TILE OUTLET  
SAID TO BELONG TO \_\_\_\_\_  
OWNER NORTH OF LOT 1

## UNPLATTED LANDS

BAYWOOD DRIVE  
50' WIDE PUBLIC ST.

FOUND TALL PIPE NEAR  
GUY ANCHOR

|         |         |
|---------|---------|
| MAP     | SCALE   |
| 1" =    | 40'     |
| B.R.G.  | REF. TO |
| S. LINE | LOT 1   |

PLAT OF SURVEY LOT 1 CSM # 39 ACCORDING  
TO THE ORIGINAL PLAT RECORDED IN VOL. 1 OF  
CSM'S PAGE 39 AS DOC. # 631168


WORK ORDERED BY: FRANCES FLOOD

I HEREBY CERTIFY THAT THIS PLAT IS A TRUE AND ACCURATE REPRESENTATION OF THE BOUNDARY LINES OF THE ABOVE DESCRIBED PROPERTY TO THE BEST OF MY PROFESSIONAL KNOWLEDGE AND BELIEF.

Robert A. Harris  
DATED APR. 11, 1985

LOT 2  
CSM #39

OUTLOT "A" (LAKE ACCESS)

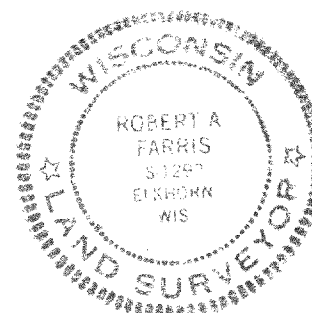

*Legend*

Ø = FOUND IRON PIPE STAKE  
O = SET IRON PIPE STAKE 1"X24"  
⊙ = METAL DETECTOR INDICATES IRON OBJECT BENEATH SOD

(x) = RECORDED DIMENSION  
xx = MEASURED DIMENSION

PROJECT NO. 2379

416-340-F ✓ ✓

W A 39-1