




North Road

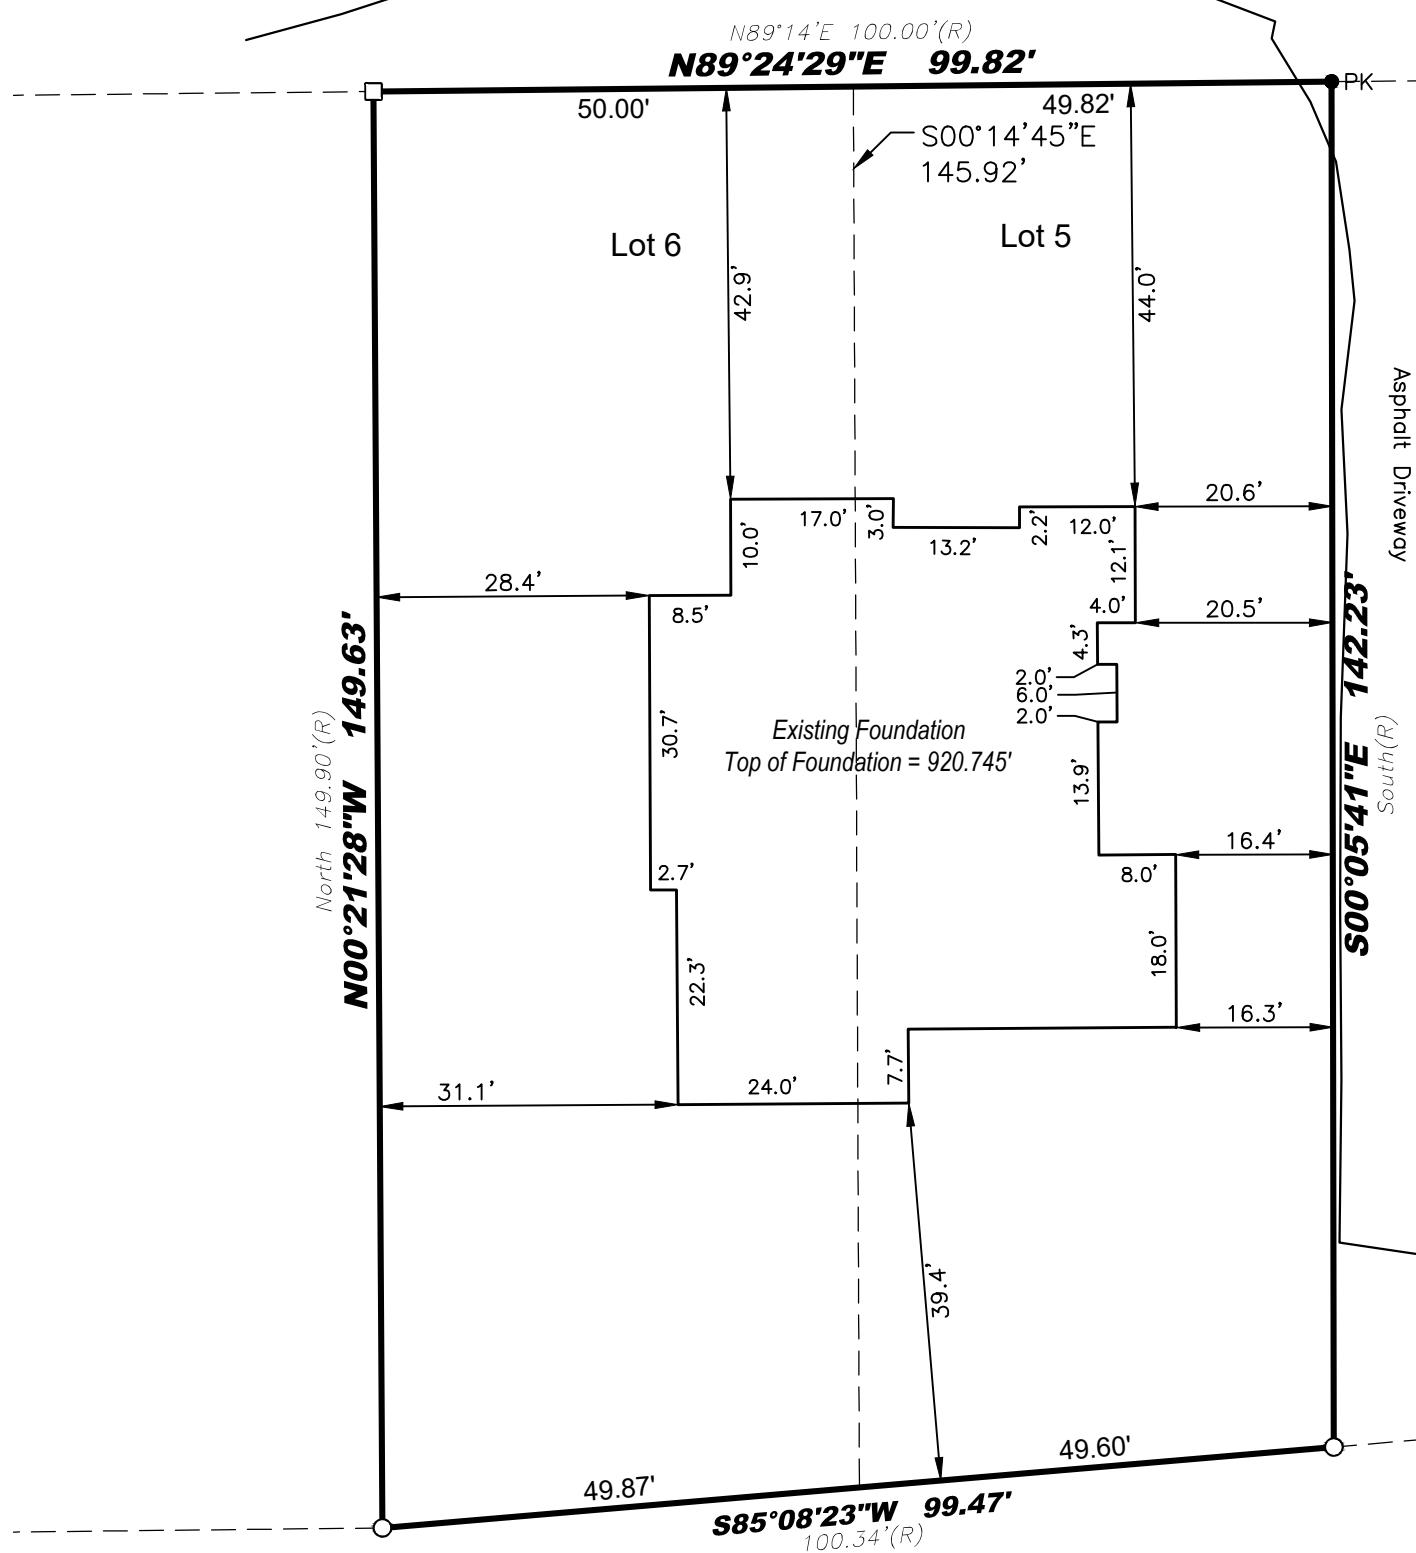

Legend:

- Found Iron Rod
- Found 1" Iron Pipe
- PK Found PK Nail



I HEREBY CERTIFY THAT I HAVE SURVEYED THE ABOVE-DESCRIBED PROPERTY AND IN MY PROFESSIONAL OPINION THIS MAP IS A TRUE REPRESENTATION THEREOF AND IS MADE IN ACCORDANCE WITH THE RECORDS OF THE REGISTER OF DEEDS AS NEARLY AS PRACTICAL. THIS SURVEY COMPLIES WITH WISCONSIN ADMINISTRATIVE CODE AE-7 EXCEPT FOR THOSE ITEMS WAIVED, IF ANY, AND IS BOUND BY WISCONSIN STATE STATUTE 893.37 THAT DEFINES STATUTE OF LIMITATIONS IN REGARD TO SURVEYS.

NO TITLE POLICY HAS BEEN PROVIDED TO THE SURVEYOR REGARDING THE PROPERTY IDENTIFIED ON THIS MAP. THEREFORE THIS PLAT OF SURVEY DOES NOT GUARANTEE THE EXISTENCE, SIZE AND LOCATION OF ANY EASEMENTS, ENCUMBRANCES, RESTRICTIONS OR OTHER FACTS THAT COULD OTHERWISE BE DISCLOSED IN AN ALTA/NSPS SURVEY.

RICK R. HILLMANN S-3005



LYNCH & ASSOCIATES
ENGINEERING CONSULTANTS, LLC
5482 S. WESTRIDGE DRIVE
NEW BERLIN, WI 53151
440 MILWAUKEE AVENUE
BURLINGTON, WI 53105
(262) 402-5040



SCALE

PLAT OF SURVEY FOUNDATION AS-BUILT for Emily Voigt

Property Description:
Lots 5 and 6, Block 7 of Cooper's Mid Lakes Subdivision, Northwest $\frac{1}{4}$ Section 35, Township 4 North, Range 16 East, Town of Lagrange, Walworth County, State of Wisconsin.

Tax ID: HCO 00017B1

Lagrange, WI