


PLAT OF SURVEY  
-OF-

LOT 60 OF "1ST ADDITION TO BUBBLING SPRINGS  
SUBDIVISION", A SUBDIVISION LOCATED IN THE  
SOUTHEAST 1/4 OF SECTION 34, AND THE SOUTHWEST  
1/4 AND THE NORTHWEST 1/4 OF SECTION 35, TOWNSHIP  
4 NORTH, RANGE 16 EAST OF THE FOURTH PRINCIPAL  
MERIDIAN, IN THE TOWN OF LAGRANGE, COUNTY OF  
WALWORTH AND STATE OF WISCONSIN.


SURVEY FOR: BRENT KENYON  
SURVEY ADDRESS: W5713 RIDGE ROAD  
ELKHORN, WI 53121

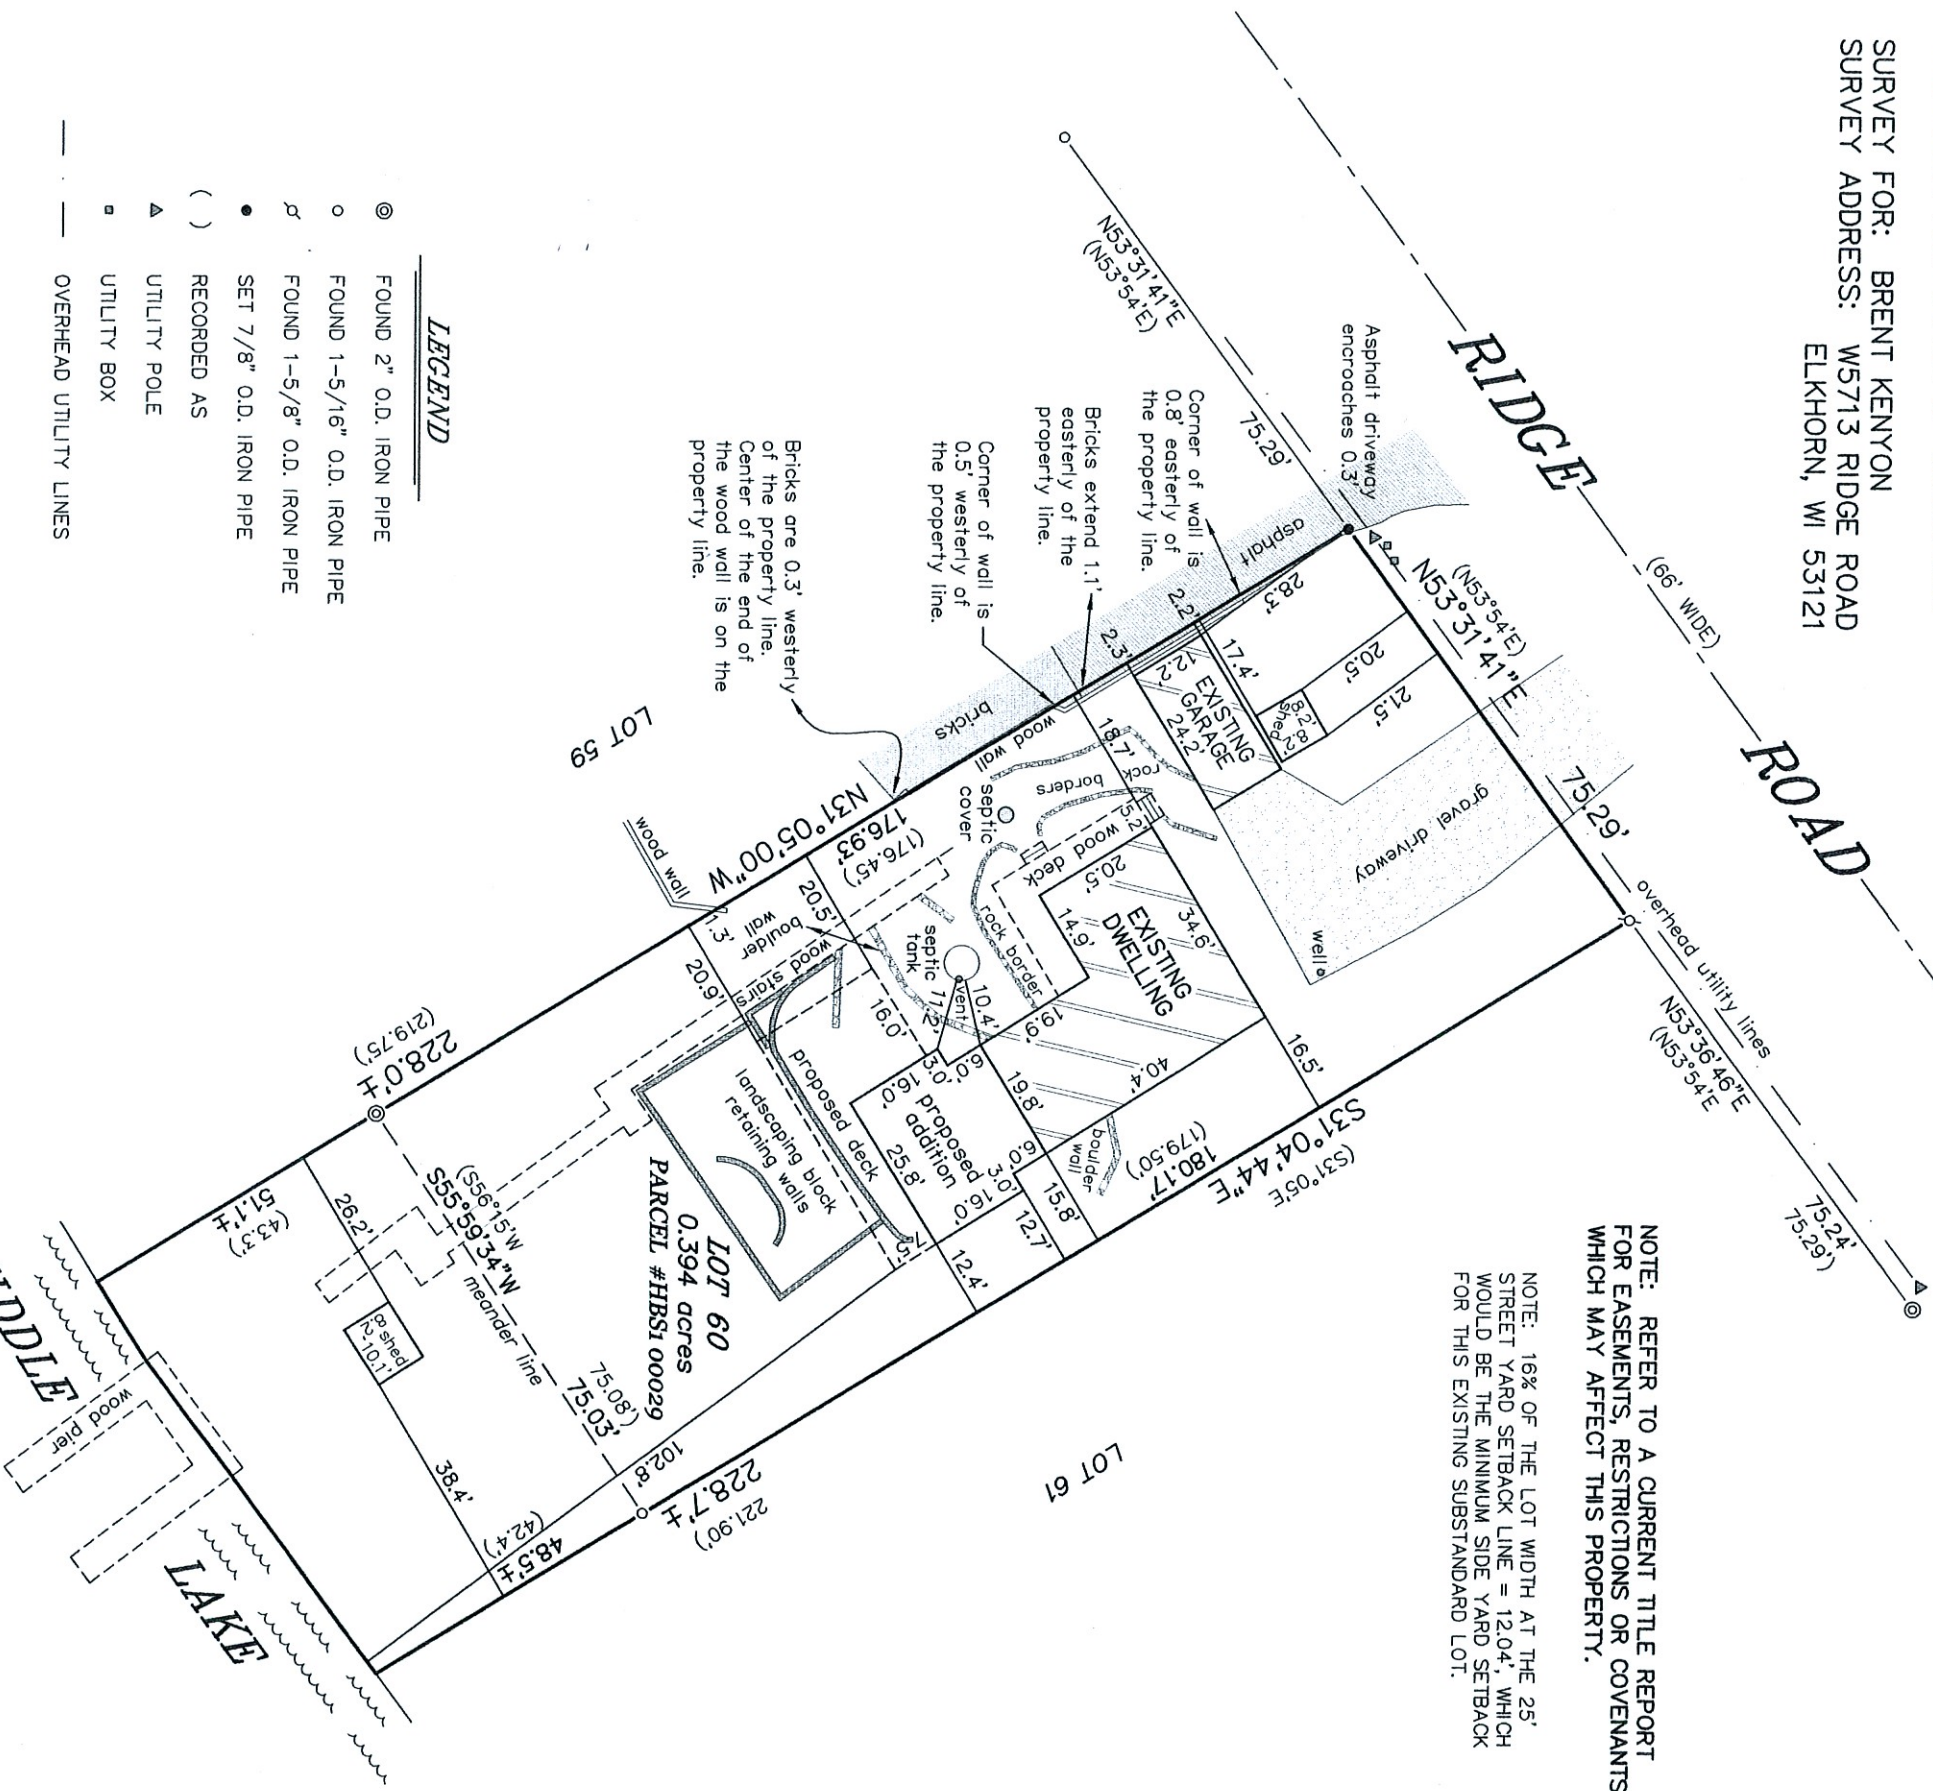

"I HEREBY CERTIFY THAT I HAVE SURVEYED THE ABOVE DESCRIBED PROPERTY AND THAT THE ABOVE MAP IS A CORRECT REPRESENTATION THEREOF AND SHOWS THE SIZE AND LOCATION OF THE PROPERTY, ITS EXTERIOR BOUNDARIES, THE LOCATION OF ALL VISIBLE STRUCTURES AND DIMENSIONS OF ALL PRINCIPAL BUILDINGS THEREON, BOUNDARY FENCES, APPARENT EASEMENTS, ROADWAYS AND ENCROACHMENTS, IF ANY."

"THIS SURVEY IS MADE FOR THE USE OF THE PRESENT OWNERS OF THE PROPERTY, AND THOSE WHO PURCHASE, MORTGAGE, OR GUARANTEE THE TITLE THERETO WITHIN ONE YEAR FROM DATE HEREOF."

**SATTER SURVEYING, LLC**  
LAND SURVEYS, MAPPING AND PLANNING  
272 ORIGIN STREET  
BURLINGTON, WI 53105  
262-661-4239

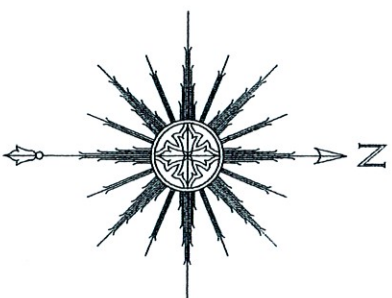

0 15' 30' 60'  
SCALE: 1" = 30'

BEARINGS HEREON RELATE TO THE WESTERLY  
LINE OF LOT 60 OF THE 1ST ADDITION TO  
BUBBLING SPRINGS, ASSUMED BEARING OF  
NORTH 31°05'00" WEST AS PLATTED.



THIS IS NOT AN ORIGINAL PRINT  
UNLESS THIS SEAL IS RED.

*Thomas L. Satter*  
THOMAS L. SATTER S-2850  
REVISED: 8/18/23  
MAY 12, 2022  
DATE  
JOB NUMBER 042208