

ABERNATHY and ASSOCIATES

Kenneth B. Abernathy, Jr.

Wisconsin Registered Land Surveyor S-1594

Rt. 3, Box 273

Elkhorn, Wisconsin 53121

Phone: (414) 723-4260 (office)

(414) 723-4813 (residence)



PLAT OF SURVEY

LOT 2 of BLOCK 1 of COOL HILL PARK SUBDIVISION LOCATED IN SECTION 35, TOWN 4 NORTH, RANGE 16 EAST, TOWN OF LAWRENCE, WALWORTH COUNTY, WISCONSIN.

Owner: Norman Leise

Rt. 1 box 549

Elkhorn, Wis. 53121

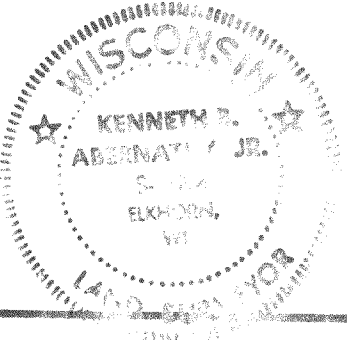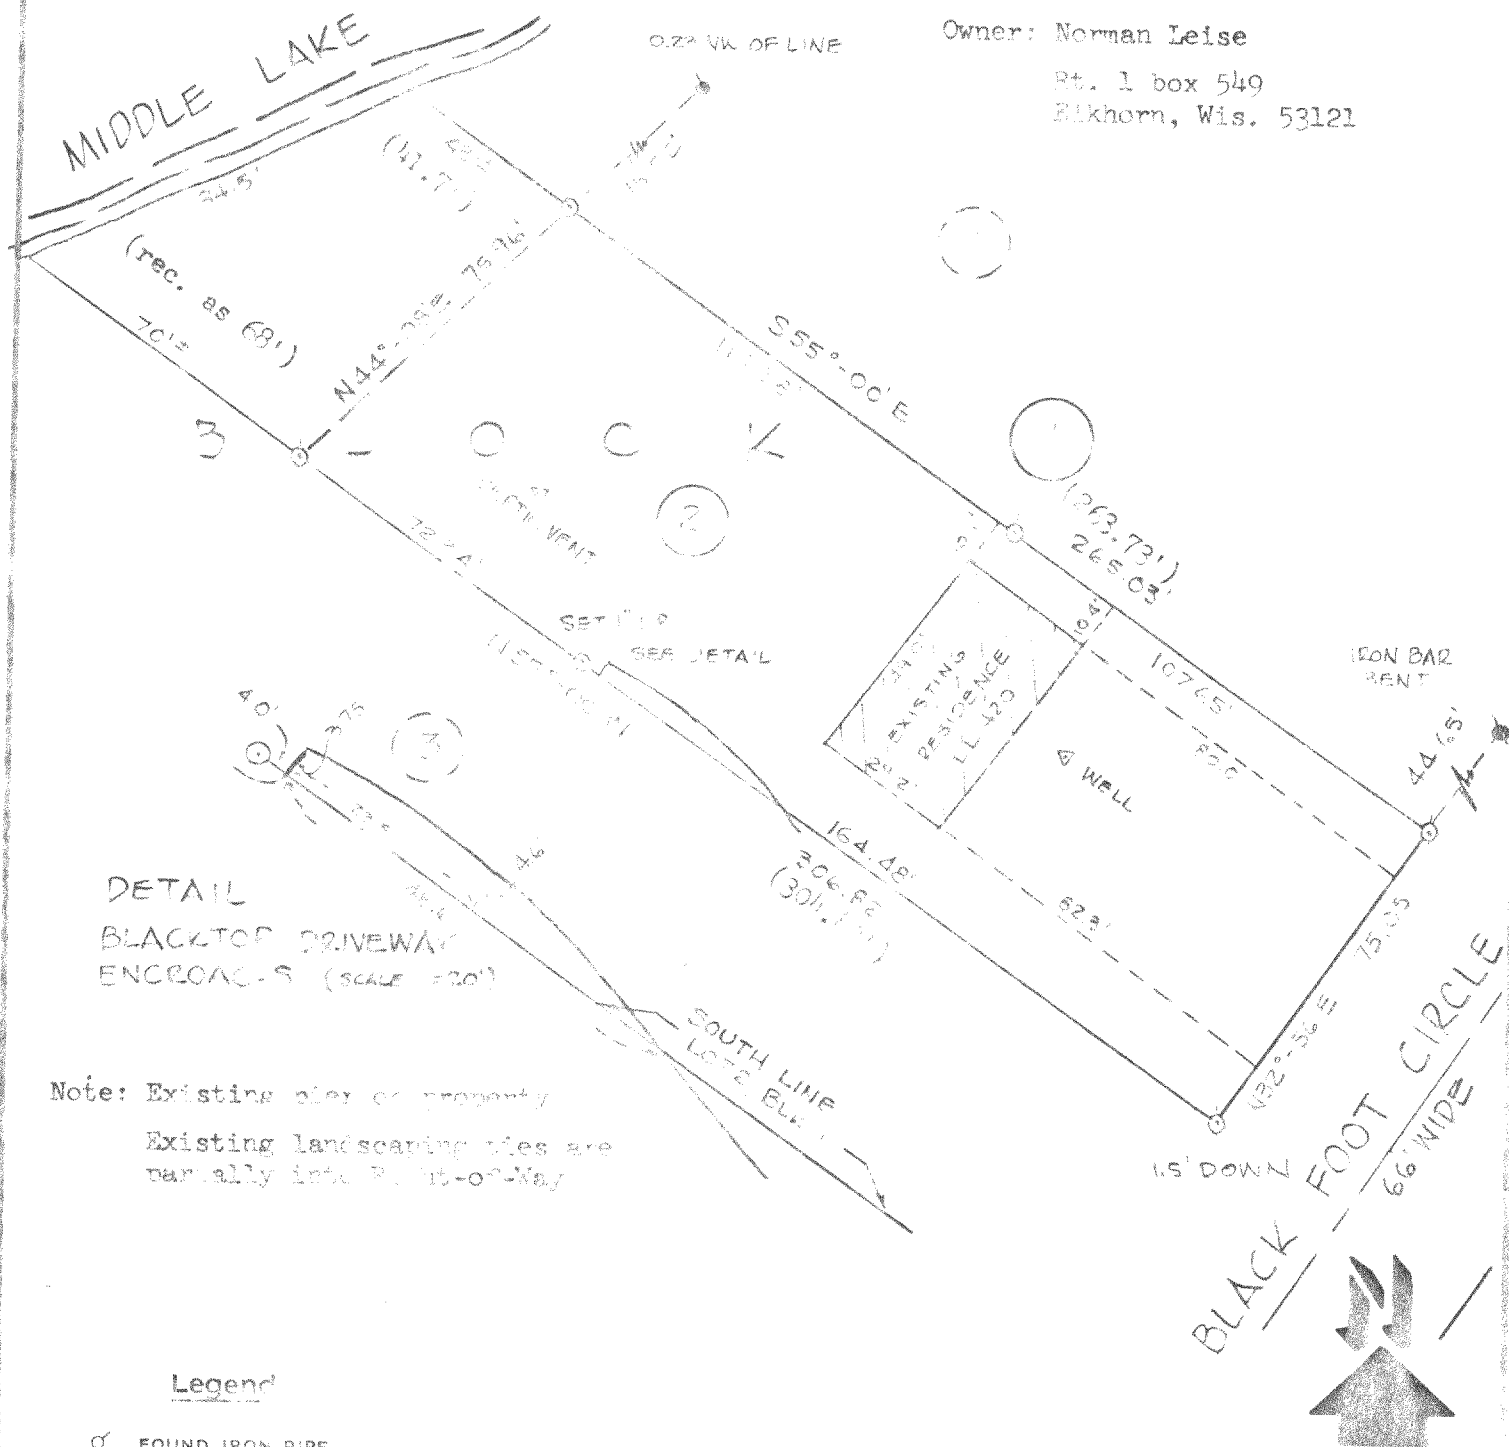

HC H-00009

416-345