


# Plat of Survey

of

## Lot 8 in Block 3 of Bay View Manor,


a subdivision located in the Northeast 1/4 of the Northwest 1/4 of Section 36,  
Town 4 North, Range 16 East, Town of LaGrange, Walworth County, Wisconsin.

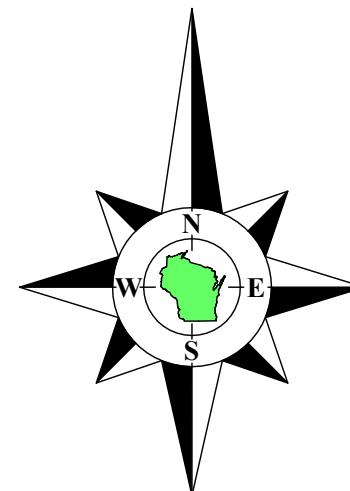

Bearings referenced to the North line of Bay Shore Drive,  
recorded as S89°53'E on the plat of Bay View Manor.

Surveyed for: **Pam King**  
W5118 Bay Shore Drive  
Elkhorn, Wisconsin 53121


Survey Date: December 4, 2023.  
Revisions:

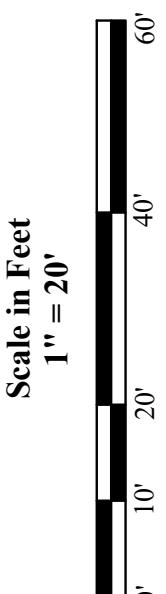

45 South Wisconsin Street | P.O. Box 322  
Elkhorn, Wisconsin 53121  
Telephone: (262) 723-3434  
Facsimile: (262) 723-8044  
Email: doug@olsonsurveying.com  
Website: www.olsonsurveying.com



Rural | Residential | Commercial

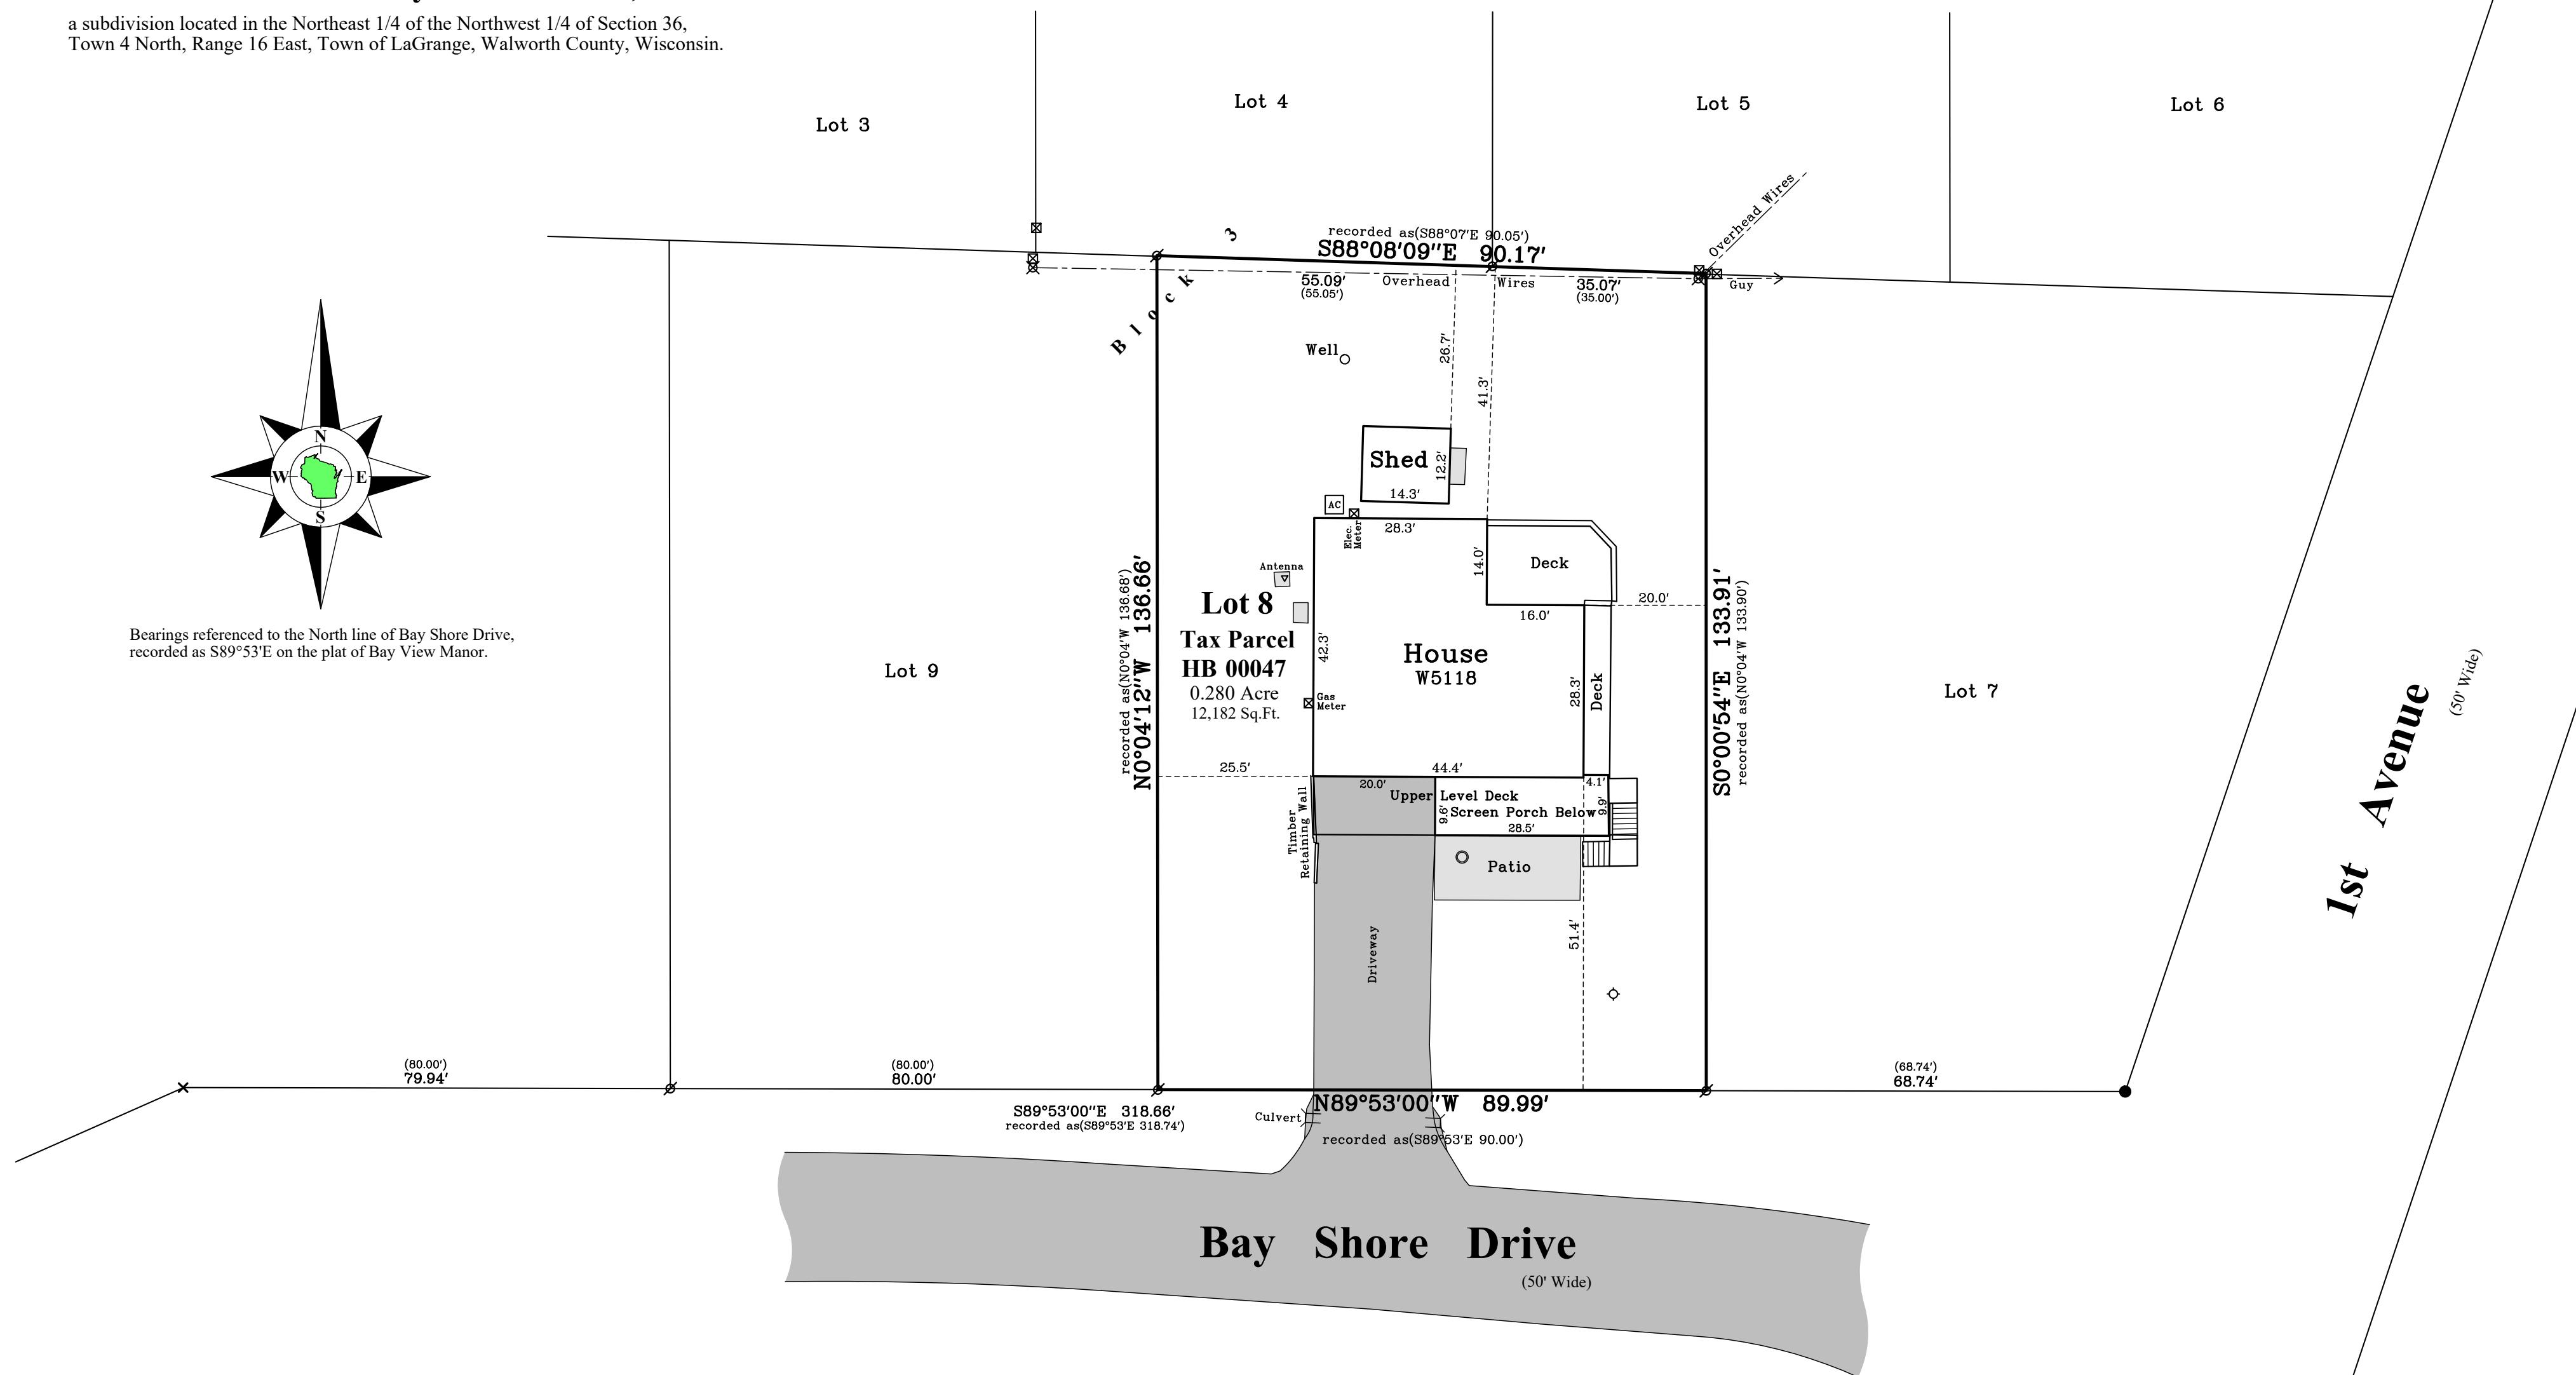


Copyright ©2023 by Olson Land Surveying, LLC.

All rights reserved. No part of this survey plat may be reproduced or transmitted in any form by any means - graphic, electronic, or mechanical, including photocopying, tracing, or information storage and retrieval systems - without permission in writing from Douglas G. Olson, Olson Land Surveying, LLC.

I hereby certify that I have surveyed the above described property in compliance with Chapter A-E 7 of the Wisconsin Administrative Code and that the map hereon is correct to the best of my professional knowledge and belief and shows the size and location of the property, its exterior boundaries, the location and dimensions of all visible structures thereon, boundary fences, apparent easements and roadways and visible encroachments, if any.

This survey is made for the exclusive use of the present owners of the property, and also those who purchase, mortgage or guarantee title thereto, within one year from the date hereof.

Douglas G. Olson  
Wisconsin Professional Land Surveyor - 2093

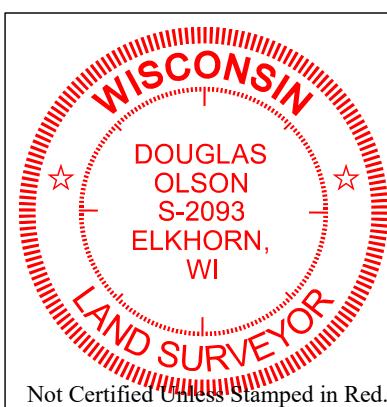

### Notes:

- 1) This Plat of Survey is not certified unless signed and sealed in red ink.
- 2) This survey is subject to Wisconsin lien laws. This Plat of Survey is the notice of intent to file lien. Lien waiver required.
- 3) The Survey Date shown on this Plat of Survey is the completion date of the field work.

Legend of Symbols & Abbreviations

■	Found Iron Pipe
○	Found Iron Rod
△	Cut Cross
●	Round Iron
×	Utility Information
×	Utility Pedestal
□	Concrete Cover
○	Septic Vent
—	Asphalt Surface—Concrete Surface

Sheet 1 of 1 Sheets  
Drawing Name:  
Job Reference Number  
**2023.108**

2023.108