

PLAT OF SURVEY OF


LOT 22 BLOCK 1 OF BAY VIEW MANOR A
SUBDIVISION LOCATED IN THE NORTHWEST 1/4
OF SECTION 36, T4N, R16E, TOWN OF LAGRANGE
WALWORTH COUNTY, WISC.

JENSEN SURVEYING & MAPPING S.C.

P.O. BOX 322 ELKHORN, WISCONSIN 53121
45 S. WISCONSIN ST.

PHONE - (414) 723-3434


SURVEYED FOR: COLONY REALTY
16 EAST WALWORTH ST.
ELKHORN, WISCONSIN 53121

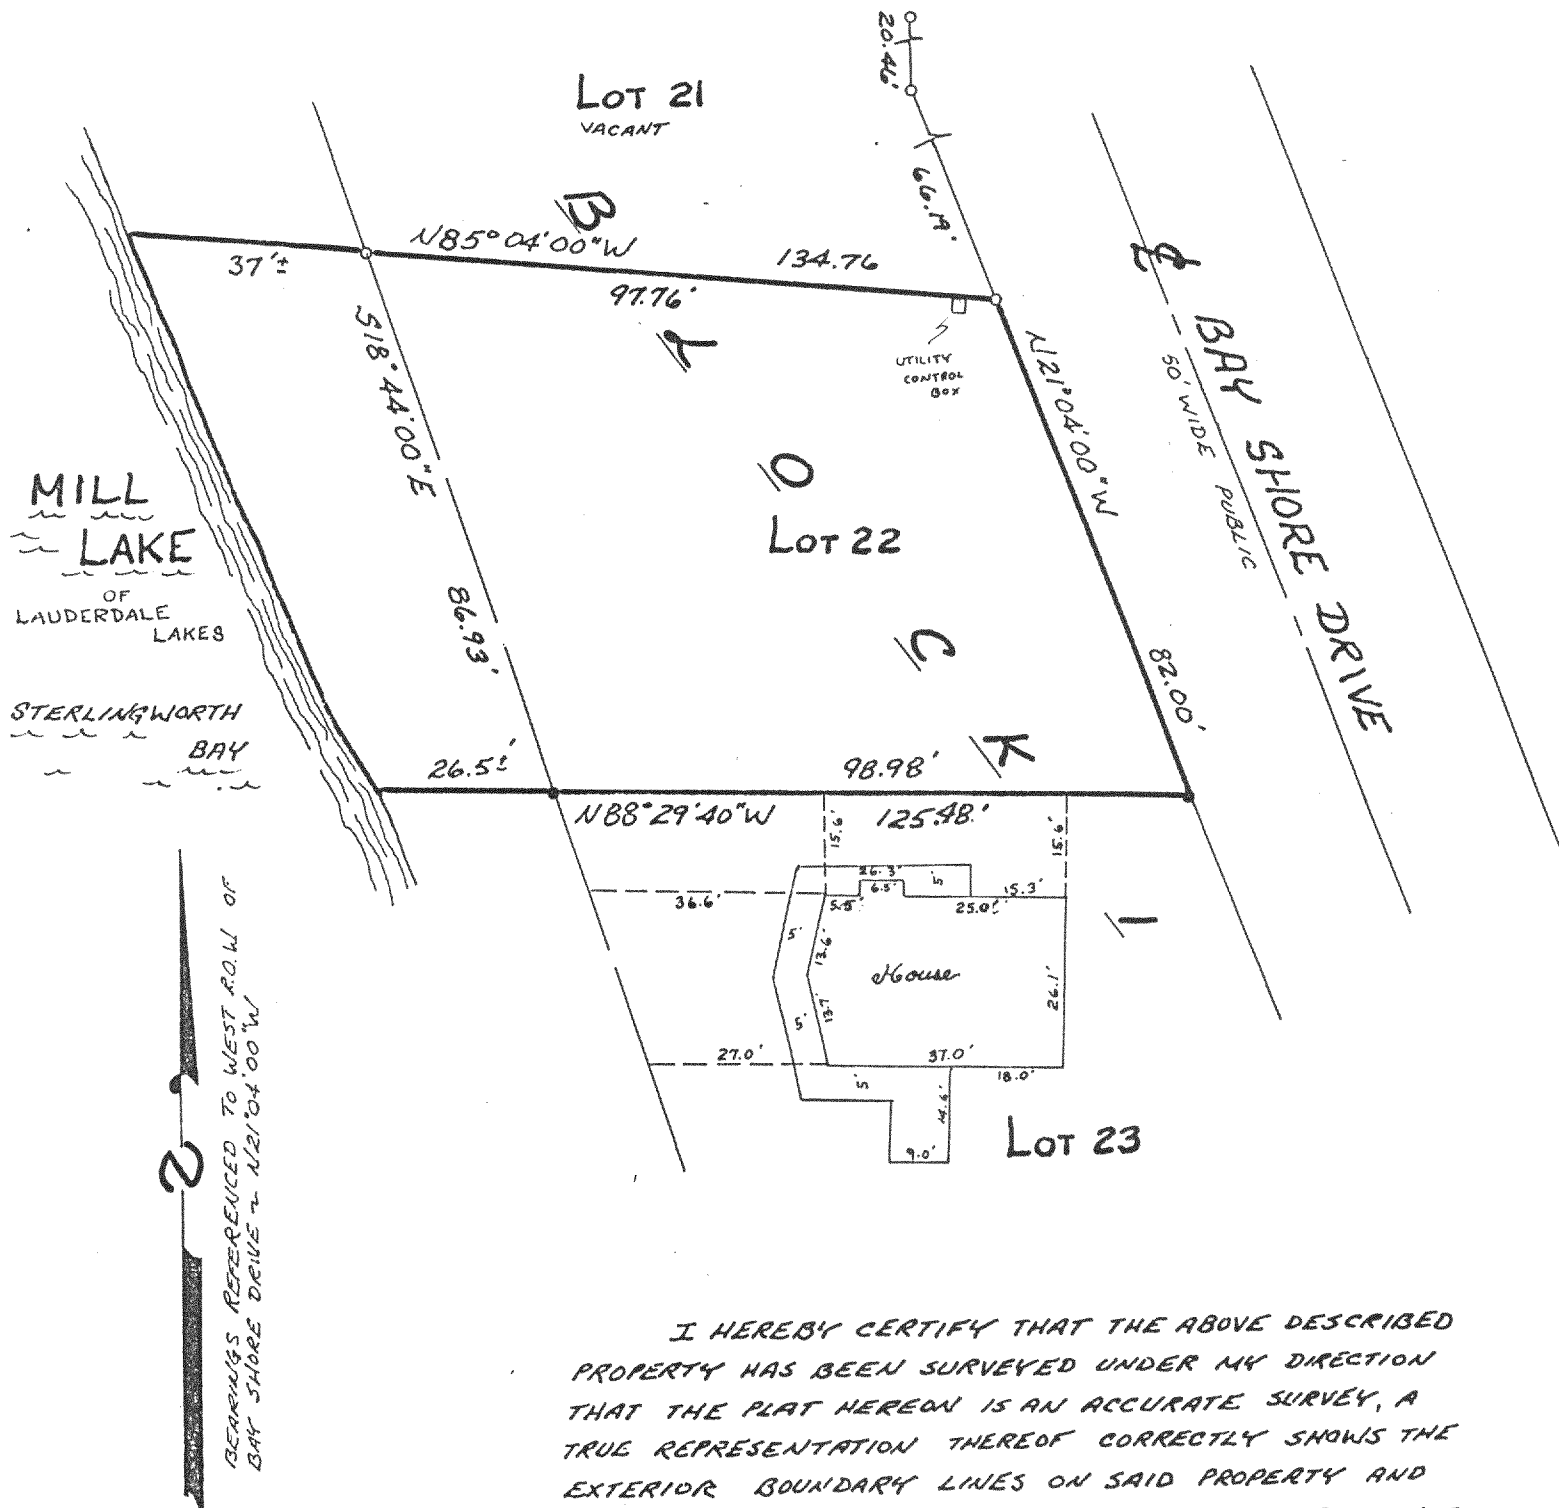

SCALE ~ 1"=30'

LEGEND

- ~ FOUND IRON PIPE
- ~ FOUND CONCRETE MONUMENT

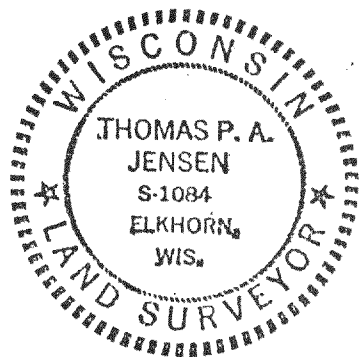

Thomas P.A. Jensen
THOMAS P.A. JENSEN RLS-1084

MAPPING DATE ~ 11, JAN. 85



WB-22

416-356V

1985.001