



KOLB LAND CONSULTING, INC.
LAKE GENEVA, WISCONSIN

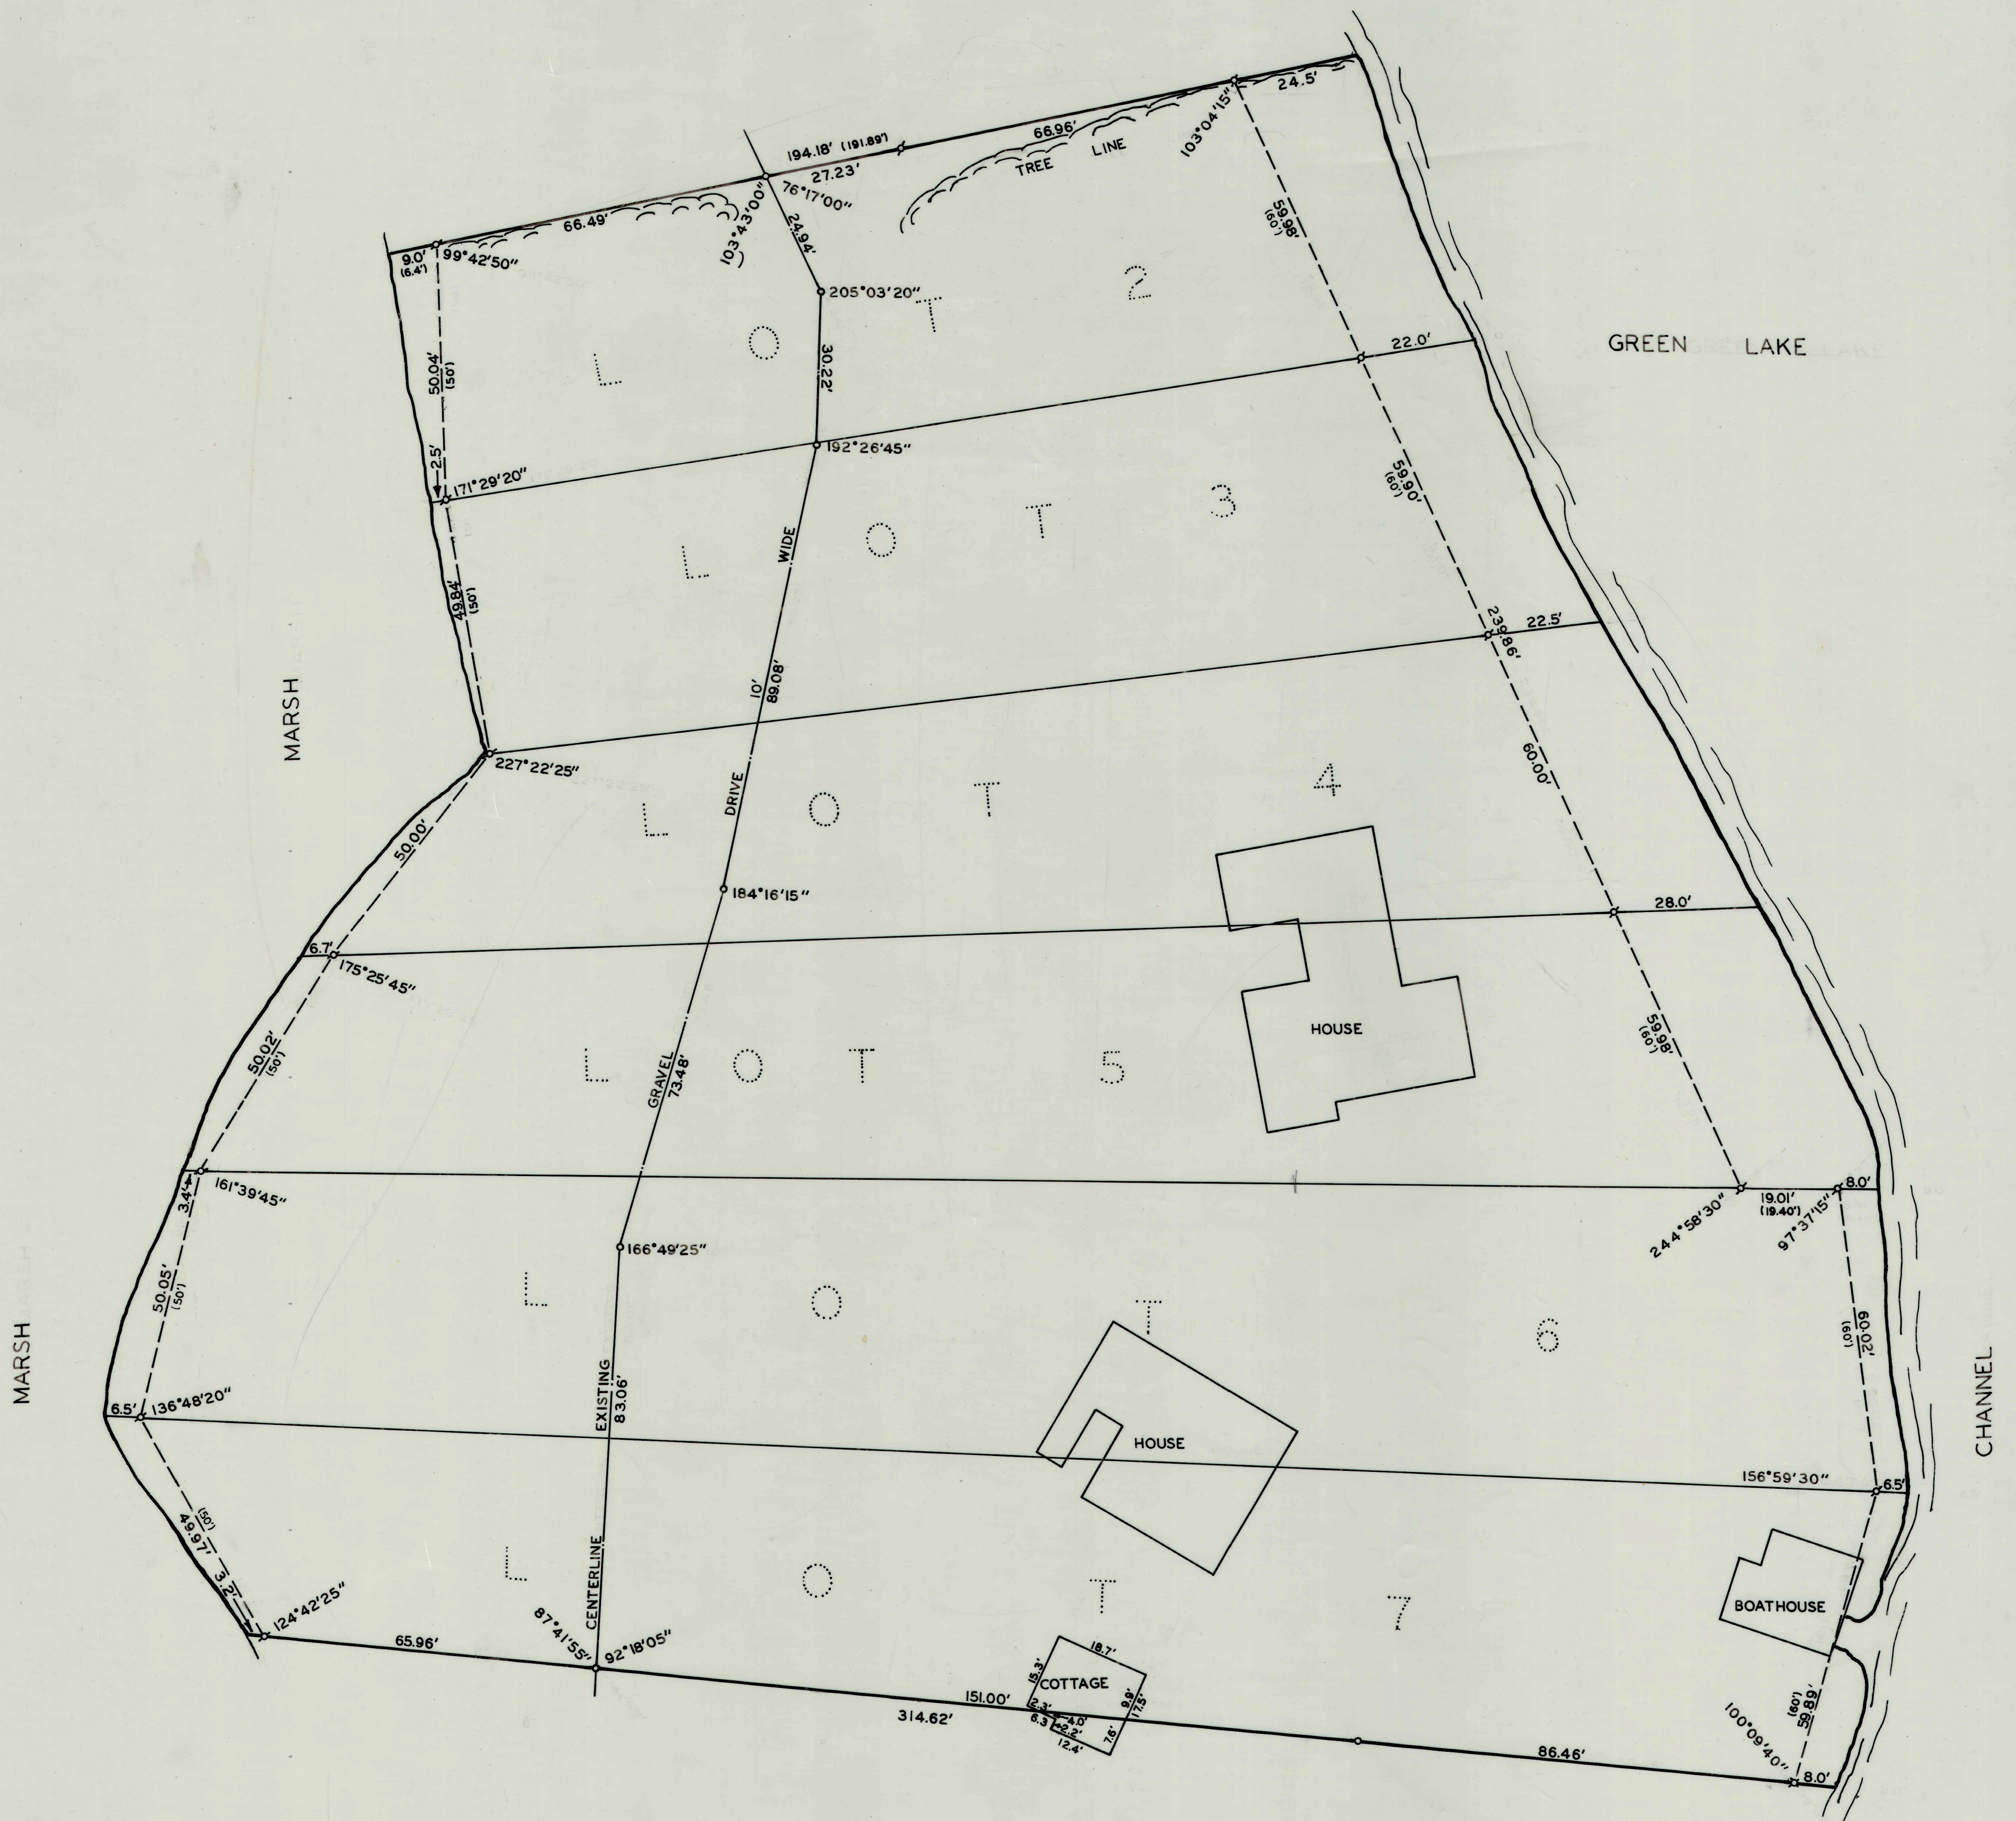


PLAT OF SURVEY OF
LOTS 2-7 OF INGLESIDE POINT, A SUBDIVISION
LOCATED IN THE SOUTHEAST 1/4 OF SECTION
26, T4N, R16E, WALWORTH COUNTY, WIS.

ORDERED BY: MRS. K. R. INGLE
605 PFEIFFER ROAD
EVANSVILLE, INDIANA 47711

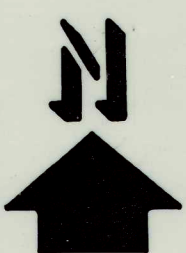

SCALE: 1" = 20'

- x-IRON PIPE FOUND
 o-IRON PIPE PLACED
 x-IRON ROD FOUND
 ()-AS PLATTED

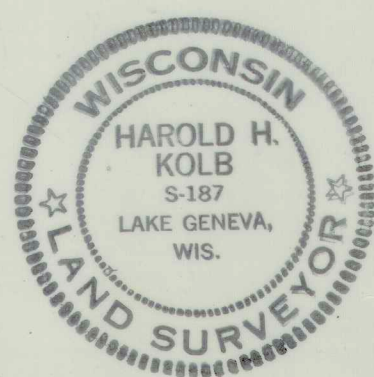

REVISED OCT 6, 2014
MARK MINITZ, SURVEYOR
#5-2582

I, HAROLD H. KOLB, DO HEREBY CERTIFY THAT I HAVE SURVEYED THE PROPERTY HEREON DESCRIBED ACCORDING TO THE OFFICIAL RECORDS, AND THAT THE PLAT HEREON IS A CORRECT REPRESENTATION OF THE LOT LINES.

Harold H. Kolb
HAROLD H. KOLB
WISCONSIN REGISTERED LAND SURVEYOR S-187

DATE Oct. 9, 1978