


PLAT OF SURVEY OF LOTS 3, 4, & 5
BLOCK 4 OF COOL HILL PARK SUBDIVISION LOCATED IN
SECTION 35, T4N, R1E, WALWORTH COUNTY, WISCONSIN.

COOL HILL DRIVE 66' WIDE PUBLIC

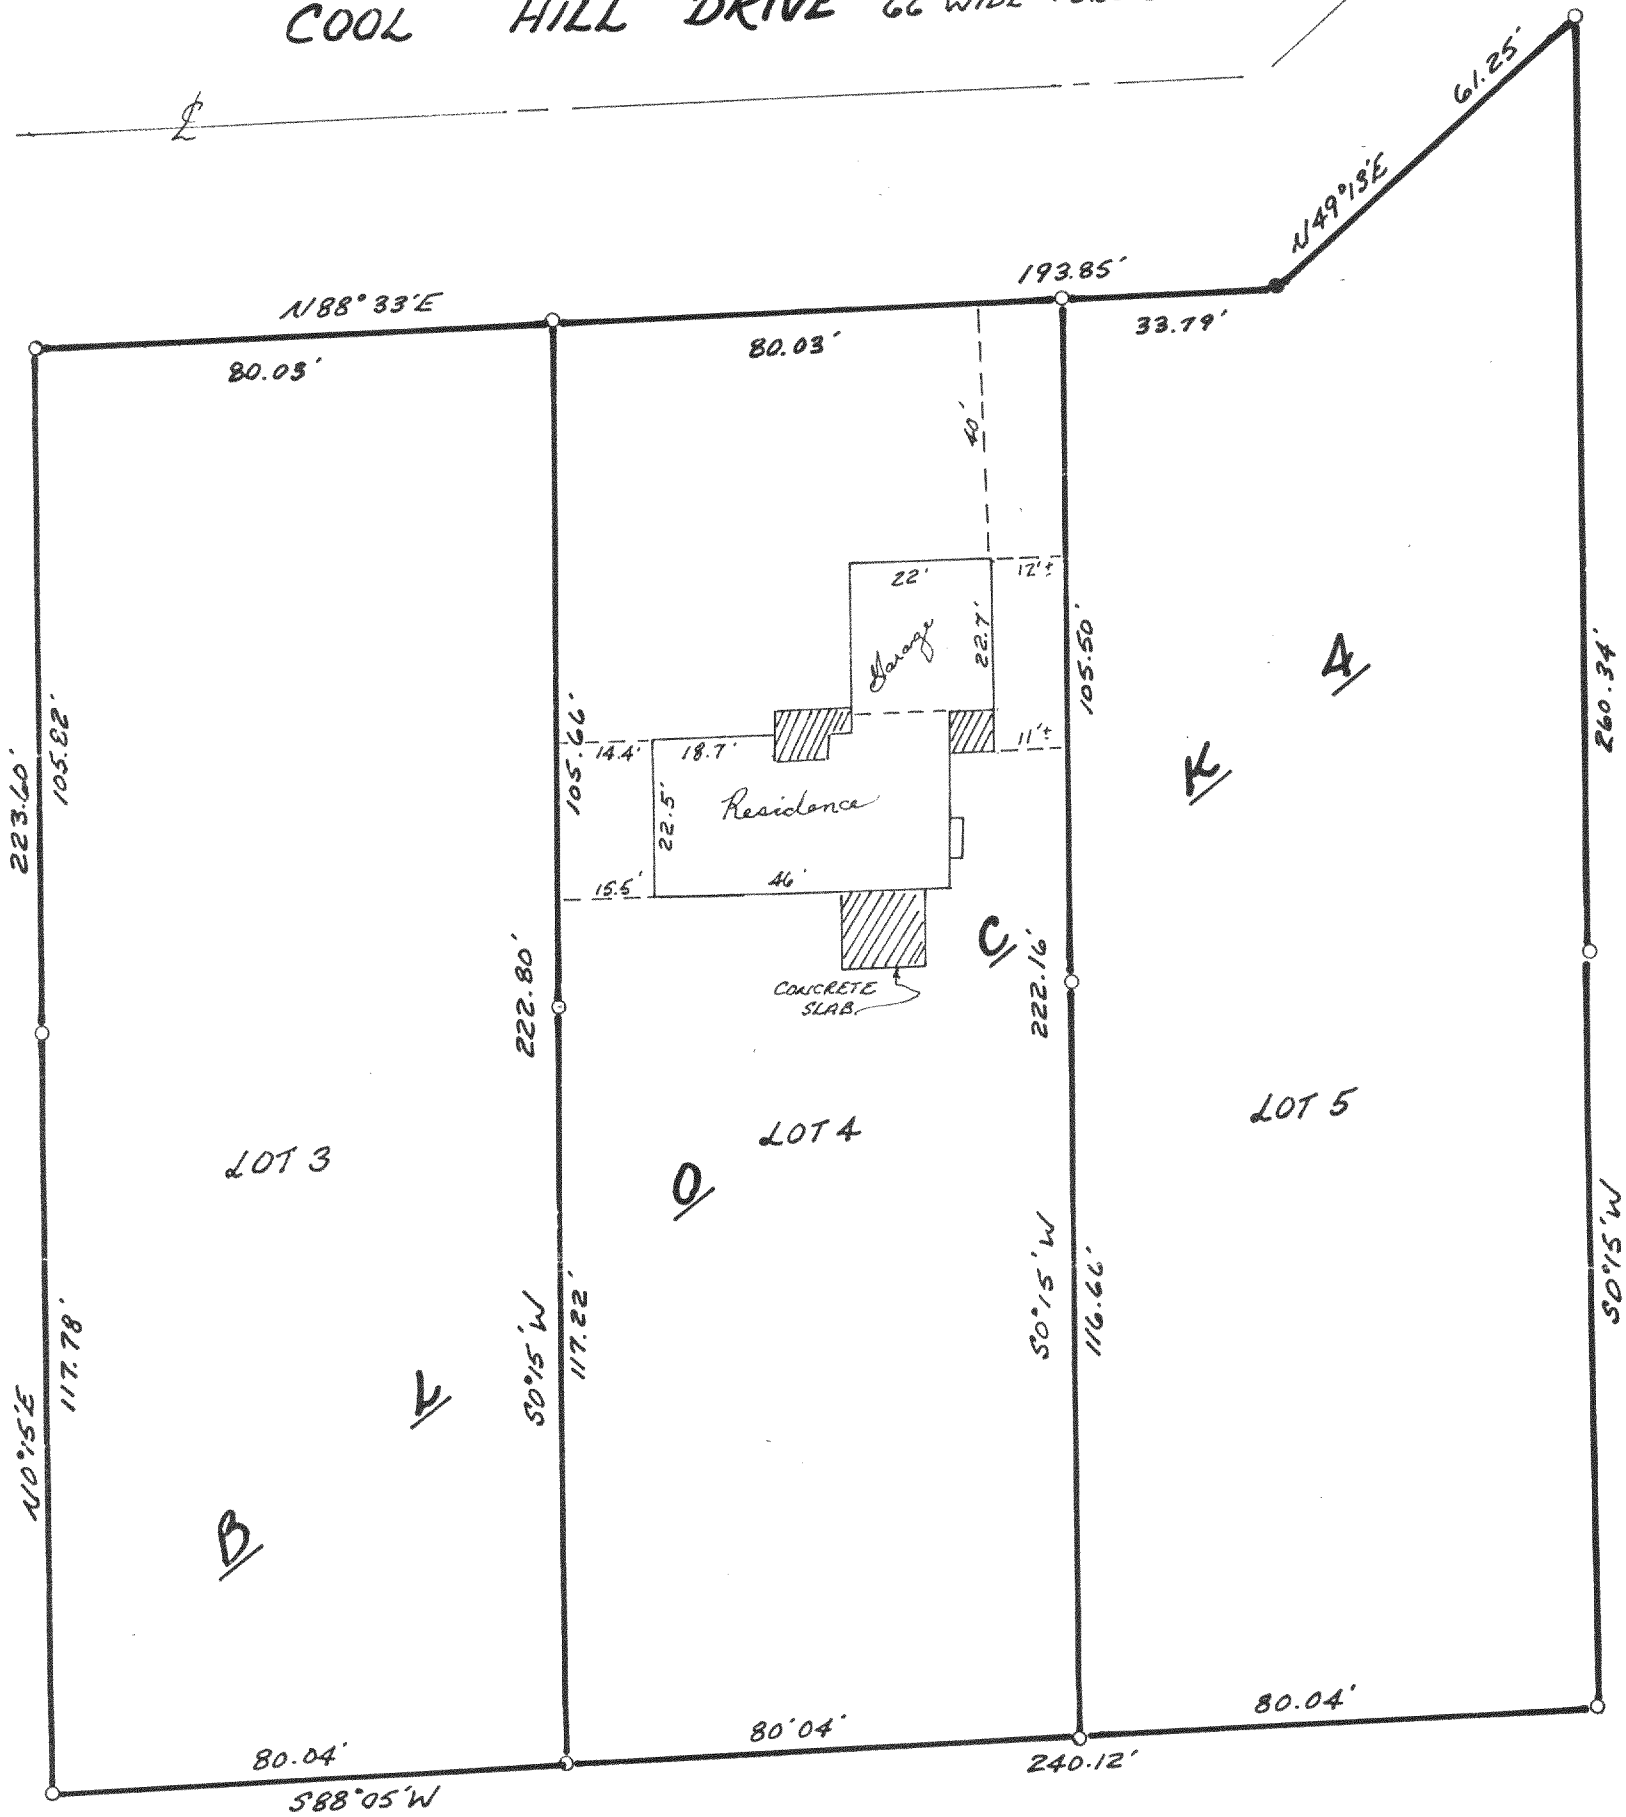

JENSEN SURVEYING & MAPPING S.C.

P.O. BOX 322

45 S. WISC. ST.

ELKHORN, WISC. 53121

PHONE (414) 723-9434

OWNER ~ CARMEN SWANSON

RT #1 BOX 568


ELKHORN, WISC. 53121

LEGEND

○ ~ FOUND 1 1/4" IRON PIPE


● ~ FOUND 2" IRON PIPE

SCALE 1" = 30'

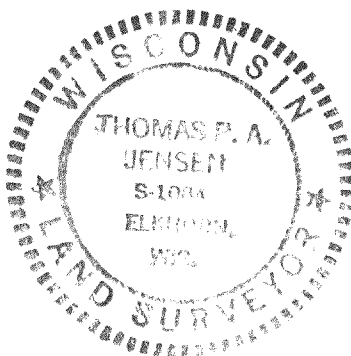

I THOMAS P.A. JENSEN, WIS REGISTERED LAND SURVEYOR,
DO HEREBY CERTIFY THAT THIS SURVEY WAS PERFORMED BY ME, OR
UNDER MY DIRECTION, IN FULL COMPLIANCE WITH THE OWNER'S / AGENT'S
INSTRUCTIONS AND CHAPTER A-55 OF WIS. ADMIN. CODE "MINIMUM
STANDARDS FOR PROPERTY SURVEYS"; AND THAT THIS MAP IS AN
ACCURATE REPRESENTATION THEREOF TO THE BEST OF MY KNOWLEDGE
AND BELIEF.

July 22, 1985

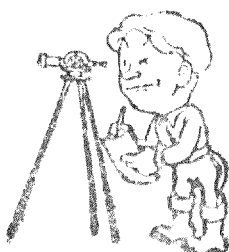

Thomas P.A. Jensen
THOMAS P.A. JENSEN S-1084

4-4-22, 23, 24

416-358
1985.066