
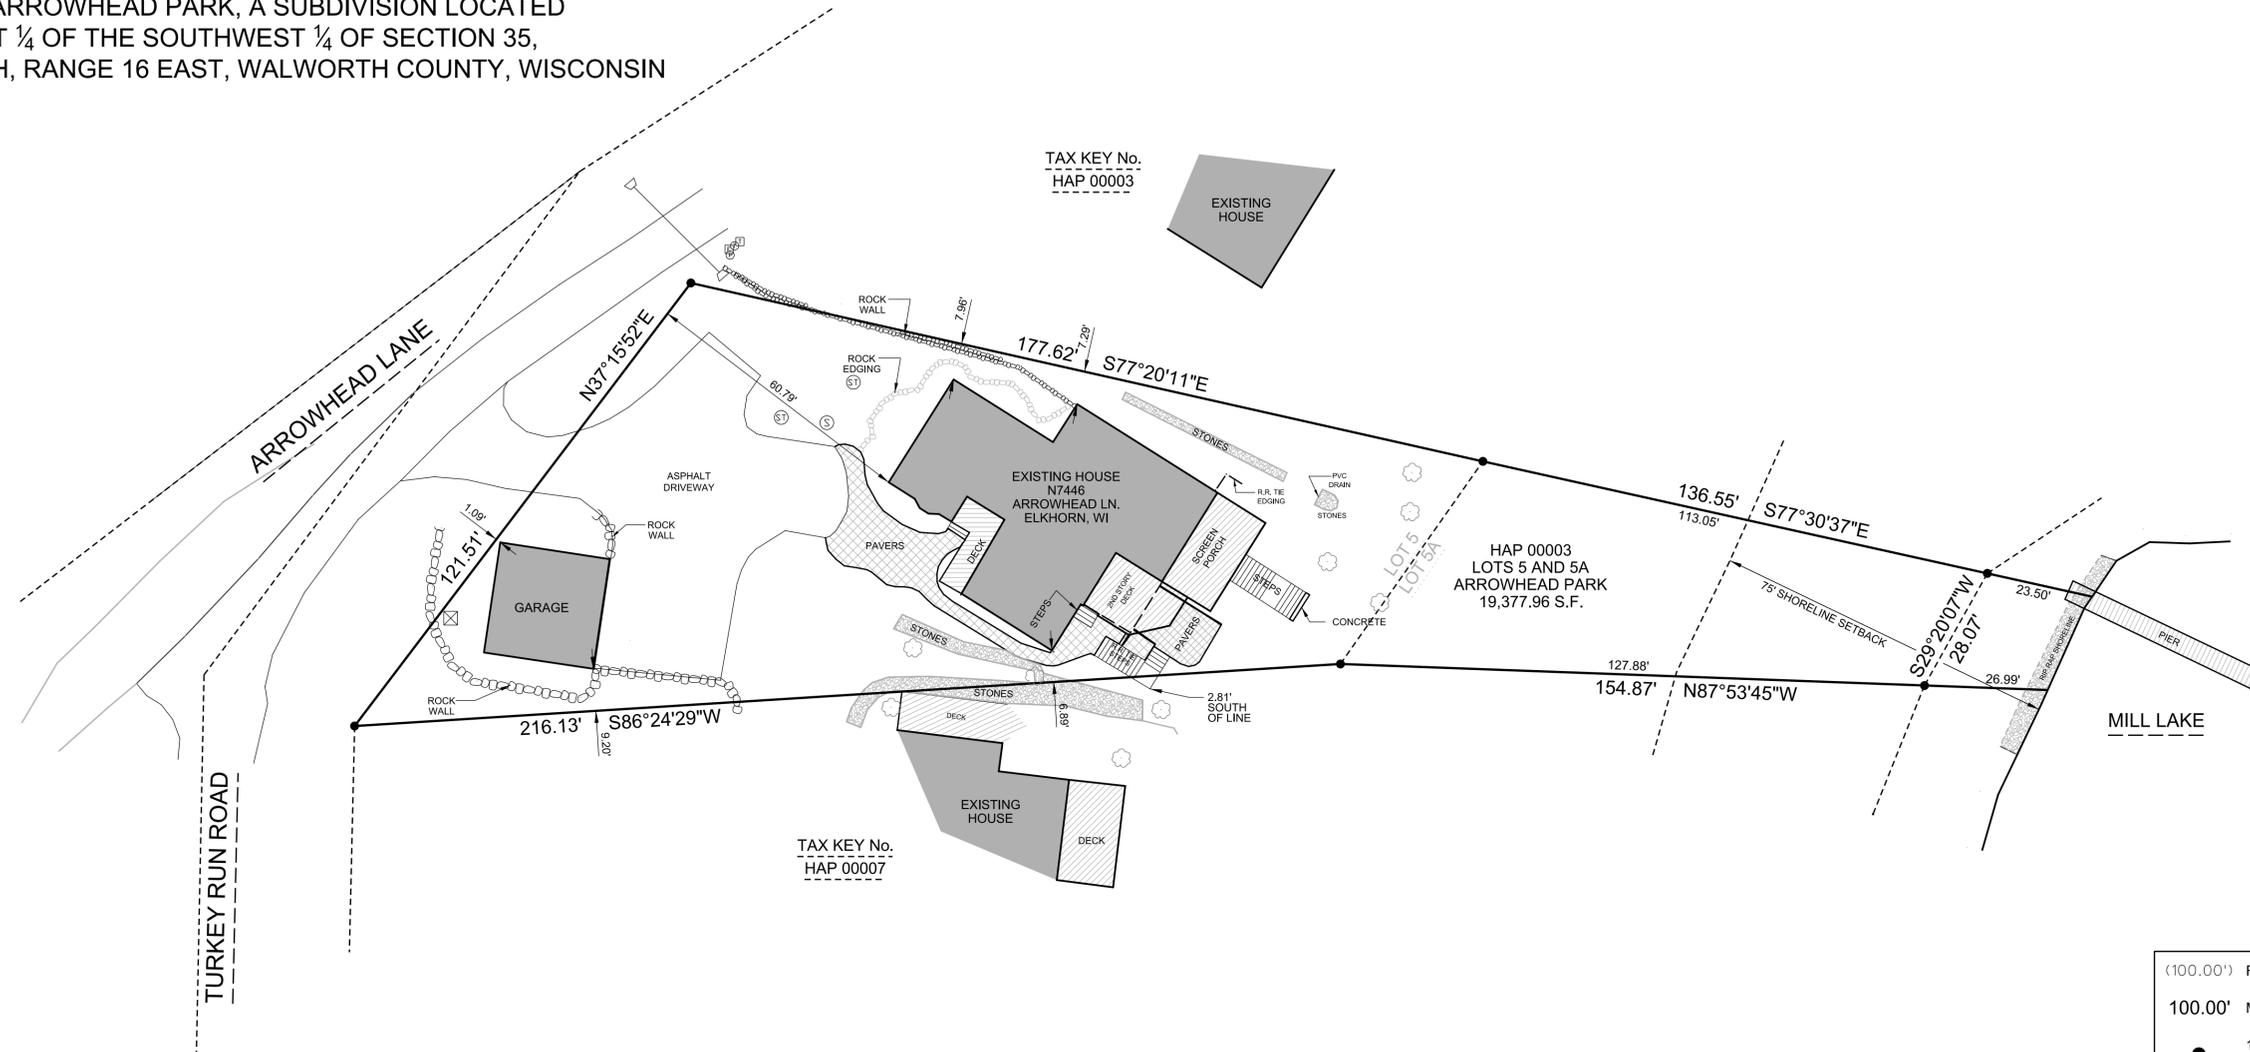


PLAT OF SURVEY

LOTS 5 AND 5A OF ARROWHEAD PARK, A SUBDIVISION LOCATED IN THE NORTHWEST ¼ OF THE SOUTHWEST ¼ OF SECTION 35, TOWNSHIP 4 NORTH, RANGE 16 EAST, WALWORTH COUNTY, WISCONSIN

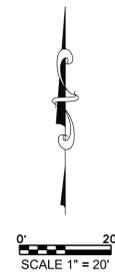

LEGEND:

(100.00')	RECORDED DISTANCE
100.00'	MEASURED DISTANCE
●	1" FOUND IRON PIPE, UNLESS NOTED
⊗	¾" x 18" IRON PIPE SET, 1.13 lbs./L.F.
▲	WELL
Ⓢ	SEPTIC TANK
Ⓢ	SEPTIC VENT
⊗	LIGHT POLE
Ⓛ	ELECTRIC TRANSFORMER
Ⓢ	ELECTRIC PEDESTAL
Ⓢ	TELEPHONE PEDESTAL
Ⓢ	CABLE TV PEDESTAL

FILE NAME: 2025-129 ENVIRONMENT N7446 ARROWHEAD LINDEN



SURVEY MADE FOR:
ROBERT V GATTUSO
DANIELLE N GATTUSO
1103 W LONNQUIST BLVD
MOUNT PROSPECT IL 60056

DATE	ITEM
09/22/2025	PLAT OF SURVEY

THIS SURVEY IS MADE FOR THE USE OF THE PRESENT OWNERS OF THE PROPERTY, AND ALSO THOSE WHO PURCHASE, MORTGAGE OR GUARANTEE TITLE TO WITHIN ONE (1) YEAR FROM DATE HERETO.

I, MICHAEL A. GREESON P.L.S. #2770, HEREBY CERTIFY THAT THIS SURVEY WAS MADE IN ACCORDANCE WITH THE MINIMUM STANDARDS FOR PROPERTY SURVEYS (CHAPTER A-E 7) FOR THE STATE OF WISCONSIN AND HAS BEEN PREPARED UNDER MY DIRECTION AND CONTROL AND IS CORRECT TO THE BEST OF MY KNOWLEDGE AND BELIEF.



Michael A. Greeson

NO TITLE COMMITMENT OR RESULTS OF A TITLE SEARCH WERE FURNISHED TO V2G SURVEYING LLC., PERTAINING TO THIS SURVEY. THIS PLAT OF SURVEY MAY NOT REFLECT EASEMENTS OF RECORD, ENCUMBRANCES, RESTRICTIONS, OWNERSHIP TITLE EVIDENCE, OR OTHER FACTS THAT AN ACCURATE AND CURRENT TITLE SEARCH MAY DISCLOSE.