
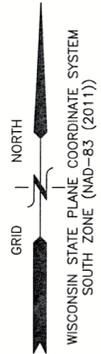


PLAT OF SURVEY

N7398 NINE INDIAN TRAIL – TOWN OF LAGRANGE

LOT 9 OF COOL HILL PARK ADDITION NO. 2
A SUBDIVISION LOCATED IN THE SOUTHEAST 1/4 OF
SECTION 34, TOWNSHIP 4 NORTH, RANGE 16 EAST,
TOWN OF LAGRANGE, WALWORTH COUNTY, WISCONSIN.

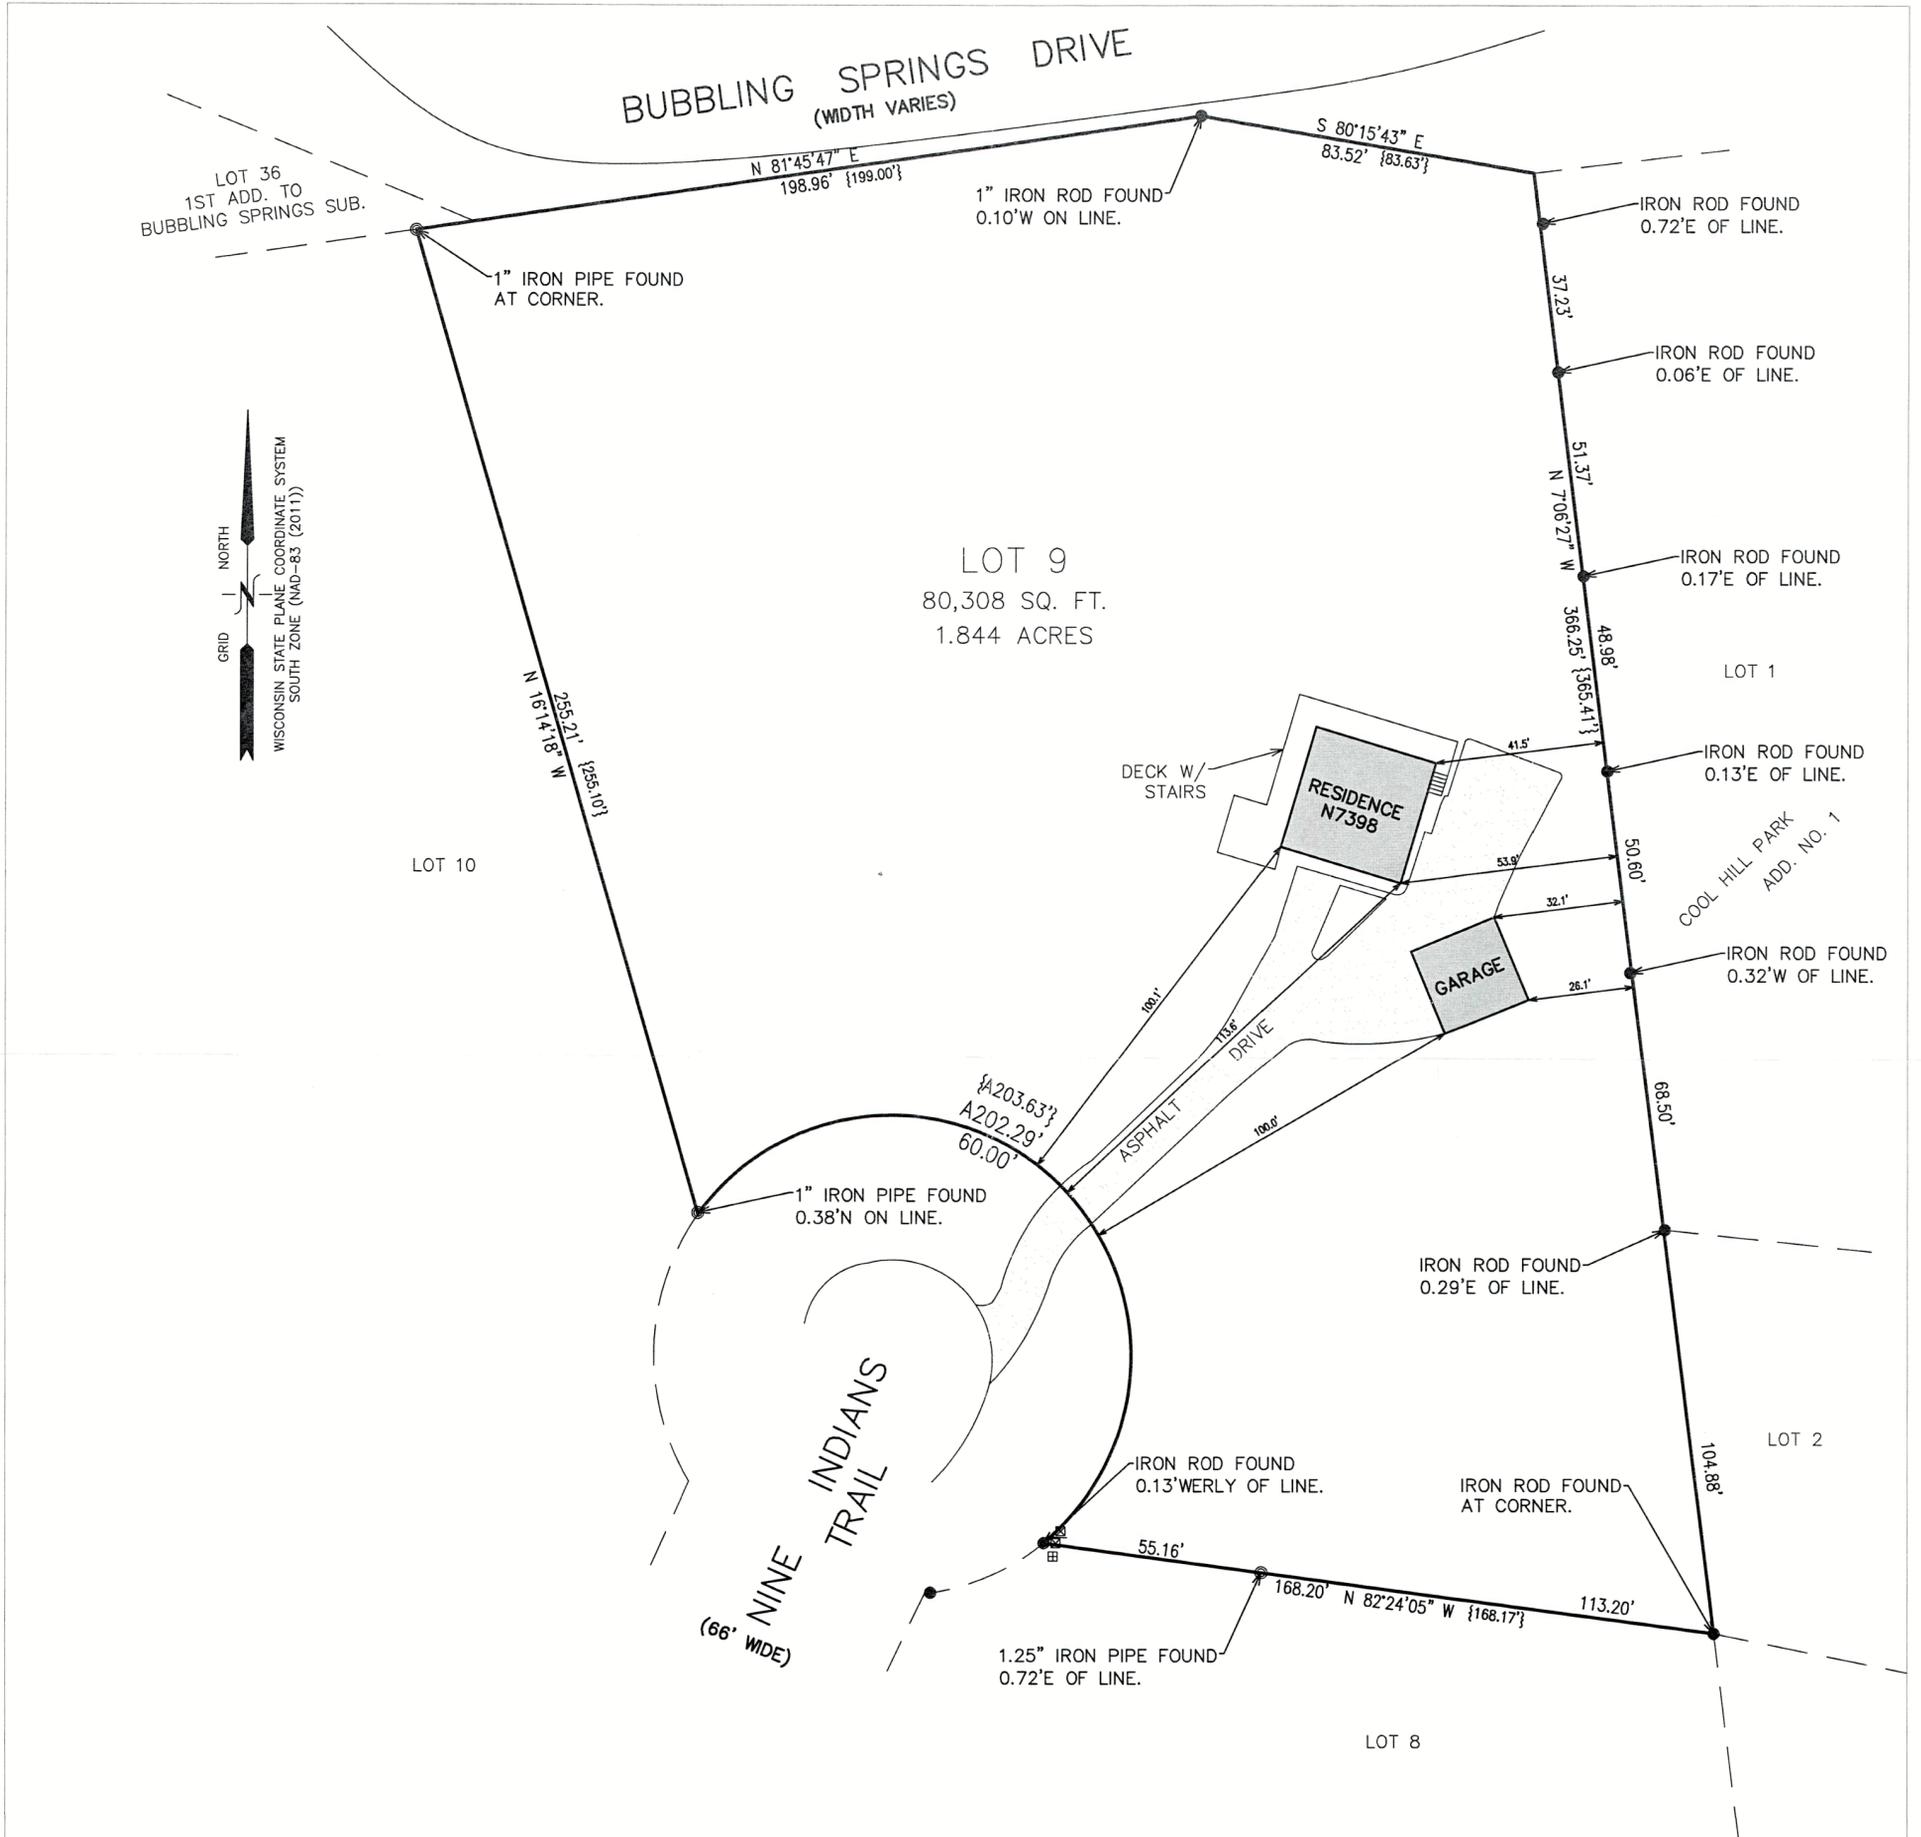

NOTE: COPIES OF THIS MAP TO WHICH THE FOLLOWING CERTIFICATE WILL APPLY SHOW THE SURVEYOR'S ORIGINAL SEAL AND SIGNATURE IN RED INK. COPIES BY ANY OTHER MEANS MAY HAVE ALTERATIONS WHICH DO NOT REPRESENT THE SURVEYOR'S WORK PRODUCT.

I HEREBY CERTIFY THAT THE ABOVE DESCRIBED PROPERTY HAS BEEN SURVEYED UNDER MY DIRECTION AND THAT THE ABOVE MAP IS A TRUE REPRESENTATION THEREOF AND SHOWS THE SIZE AND LOCATION OF THE PROPERTY AND ITS EXTERIOR BOUNDARIES. THIS SURVEY IS MADE FOR THE USE OF THE PRESENT OWNERS OF THE PROPERTY, AND ALSO THOSE WHO PURCHASE, MORTGAGE, OR GUARANTEE THE TITLE THERETO WITHIN ONE YEAR FROM THE DATE HEREOF.

DATED: 01-22-25

Christopher A. Hodges
CHRISTOPHER A. HODGES P.L.S. 2760



LEGEND	
○	= FOUND IRON PIPE STAKE, 1 3/8" O.D.
●	= FOUND IRON REBAR STAKE, 3/4" DIA.
⊠	= TRANSFORMER
⊞	= TELEPHONE BOX



FH	PLAT OF SURVEY N7398 NINE INDIAN TRAIL ELKHORN, WALWORTH COUNTY, WISCONSIN	FARRIS, HANSEN & ASSOCIATES, INC. ENGINEERING - ARCHITECTURE - SURVEYING 7 RIDGWAY COURT P.O. BOX 437 ELKHORN, WISCONSIN 53121 PHONE: (262) 723-2098 e-mail: office@farrishansen.com	JASON & HEATHER SMOLAREK N7398 NINE INDIAN TRAIL ELKHORN, WISCONSIN 53121	REVISIONS 1/7/25 RS FIELD WORK 1/22/25 RS DRAFTED	PROJECT NO. 11151 DATE: 01/22/2025 SHEET NO. 1 OF 1
	HCH2-11 416-3589				