


Plat of Survey

- of -

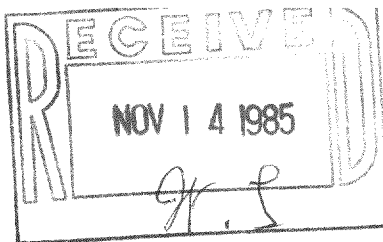

Lot 3, Block 14 of Cool Hill Park
Addition No. 2, located in the SE 1/4 of the
SE 1/4 of Section 34, T4N R16E Town of
LaGrange, and in the NE 1/4 of the NE 1/4 of
Section 3, T3N R16E Town of Sugar Creek,
Walworth County, Wisconsin.

Surveyed For: Salvatore Lo Presti

Rt. 1 Box 507
Elkhorn, WI. 53121

Surveyed by:

Jensen Surveying & Mapping


45 S. Wisconsin
Elkhorn, WI. 53121

Scale: 1" = 60'

Legend

○ ~ Found Iron Pipe

● ~ Found Iron Rod

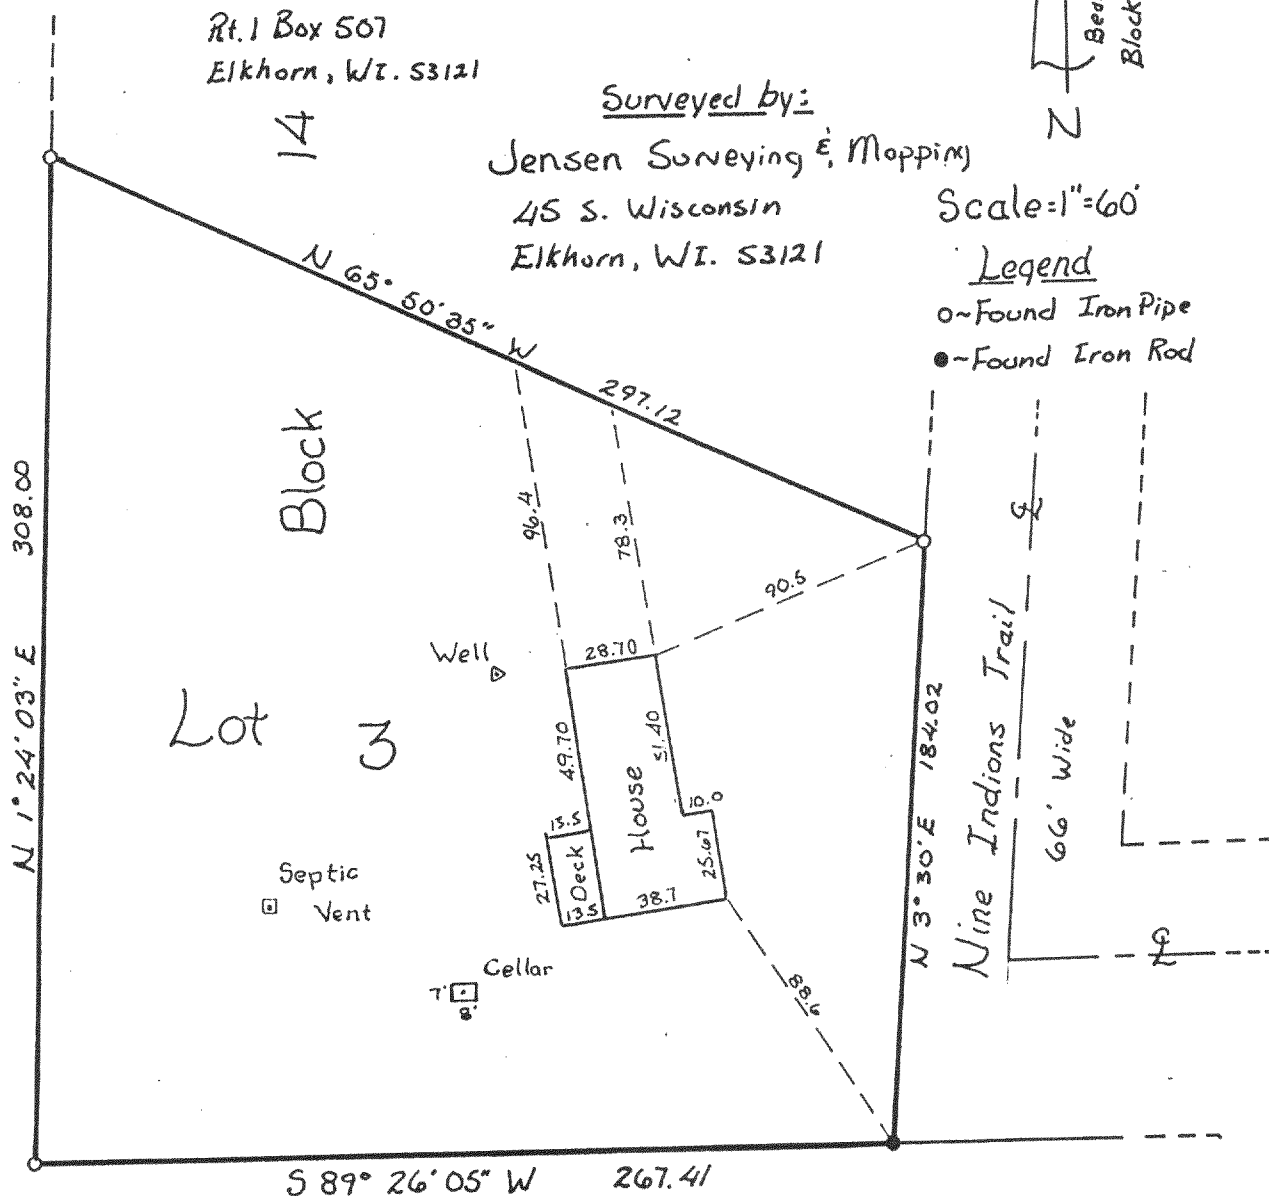

I, Thomas P.A. Jensen, Wis. Registered Land Surveyor,
do hereby certify that this survey was performed by me,
or under my direction, in full compliance with the owner's/
agent's instructions and chapter A-E 5 of the Wis. Admin.
Code "Minimum Standards For Property Surveys"; and that this
map is an accurate representation thereof to the best of my
knowledge and belief.

Thomas P.A. Jensen

Thomas P.A. Jensen S-1084
Jensen Surveying & Mapping, S.C.
45 S. Wisconsin St.
Elkhorn, Wis. 53121
414-723-3434

Mapping Date 6/7/85

416-359
1985.042

