


52

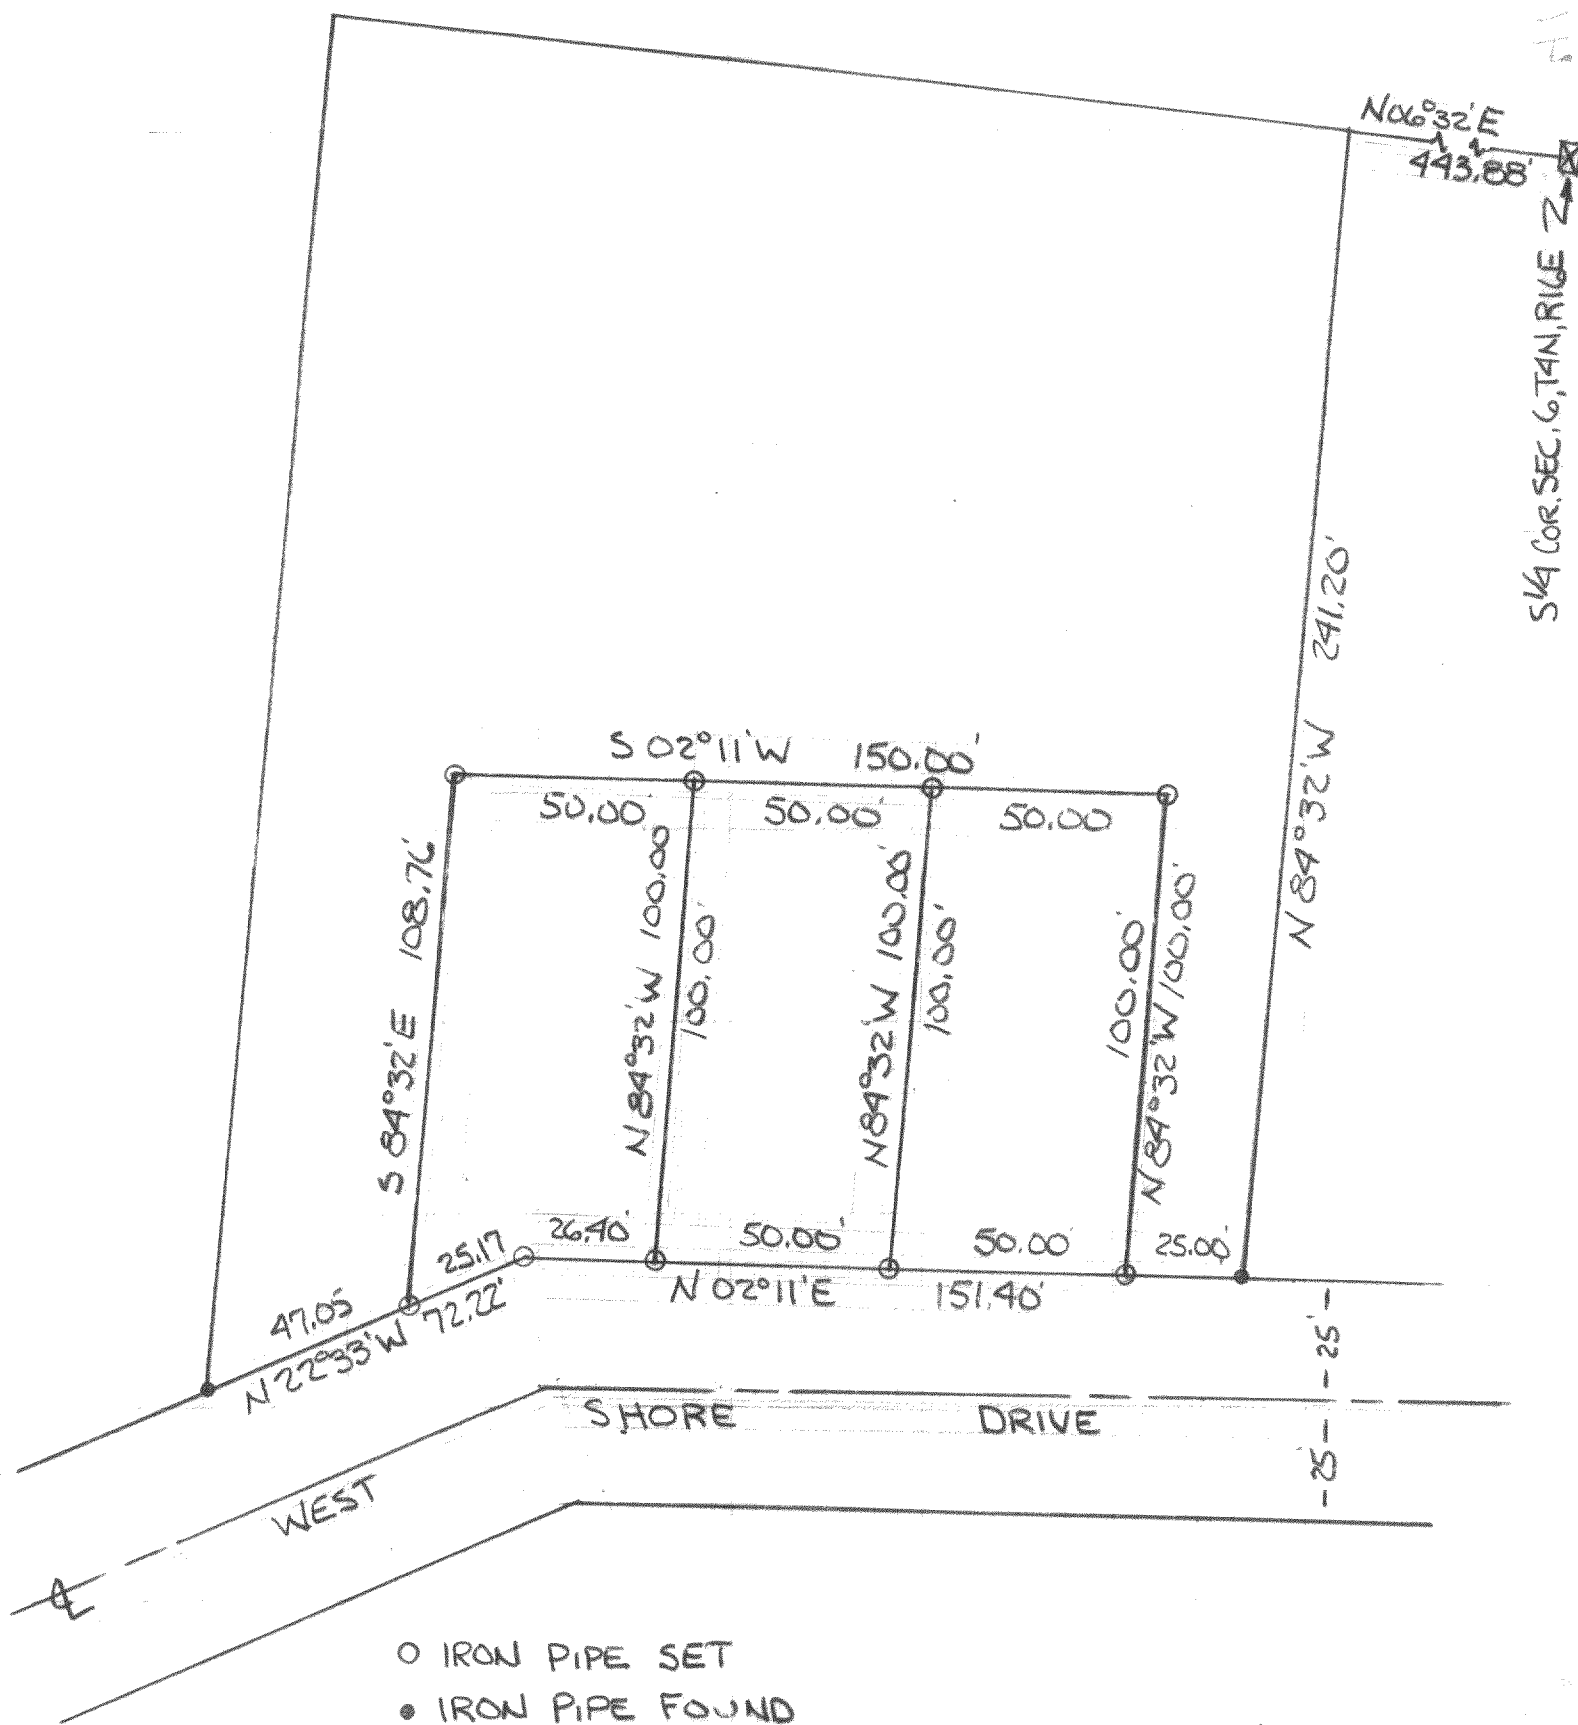

Green Lake Park

parcels GP-41A, 41A1, 41A2, + 41A3

416-35B

416-32B

Description of 3 Garage Lots for the
Town of LaGrange

South Parcel: Commencing at the S $\frac{1}{4}$ corner of Section 26, T. 4 N., R. 16 E., Walworth County, Wisconsin; thence N. 06° 32' E. 443.88 feet, thence N. 84° 32' W. 241.20 feet, thence N. 02° 11' E. 25.00 feet to the place of beginning of the lands hereinafter described, to wit: thence continue N. 02° 11' E. 50.00 feet, thence S. 84° 32' E. 100.00 feet, thence S. 02° 11' W. 50.00 feet, thence N. 84° 32' W. 100.00 feet to the place of beginning.

Middle Parcel: Commencing at the S $\frac{1}{4}$ corner of Section 26, T. 4 N., R. 16 E., Walworth County, Wisconsin; thence N. 06° 32' E. 443.88 feet, thence N. 84° 32' W. 241.20 feet, thence N. 02° 11' E. 75.00 feet to the place of beginning of the lands hereinafter described, to wit: thence continue N. 02° 11' E. 50.00 feet, thence S. 84° 32' E. 100.00 feet, thence S. 02° 11' W. 50.00 feet, thence N. 84° 32' W. 100.00 feet to the place of beginning.

North Parcel: Commencing at the S $\frac{1}{4}$ corner of Section 26, T. 4 N., R. 16 E., Walworth County, Wisconsin; thence N. 06° 32' E. 443.88 feet, thence N. 84° 32' E. 241.20 feet, thence N. 02° 11' E. 125.00 feet to the place of beginning of the lands hereinafter described, to wit: thence continue N. 02° 11' E. 26.40 feet, thence N. 22° 33' W. 25.17 feet, thence S. 84° 32' E. 108.76 feet, thence S. 02° 11' W. 50.00 feet, thence N. 84° 32' W. 100.00 feet to the place of beginning.

CERTIFICATE:

I, Joseph M. Biagi, surveyor, do hereby certify that I have surveyed the lands hereon described.

DATE:

October 12, 1973

Joseph M. Biagi
Elkhorn, Wisconsin

RLS #12

416-32B

416-35B